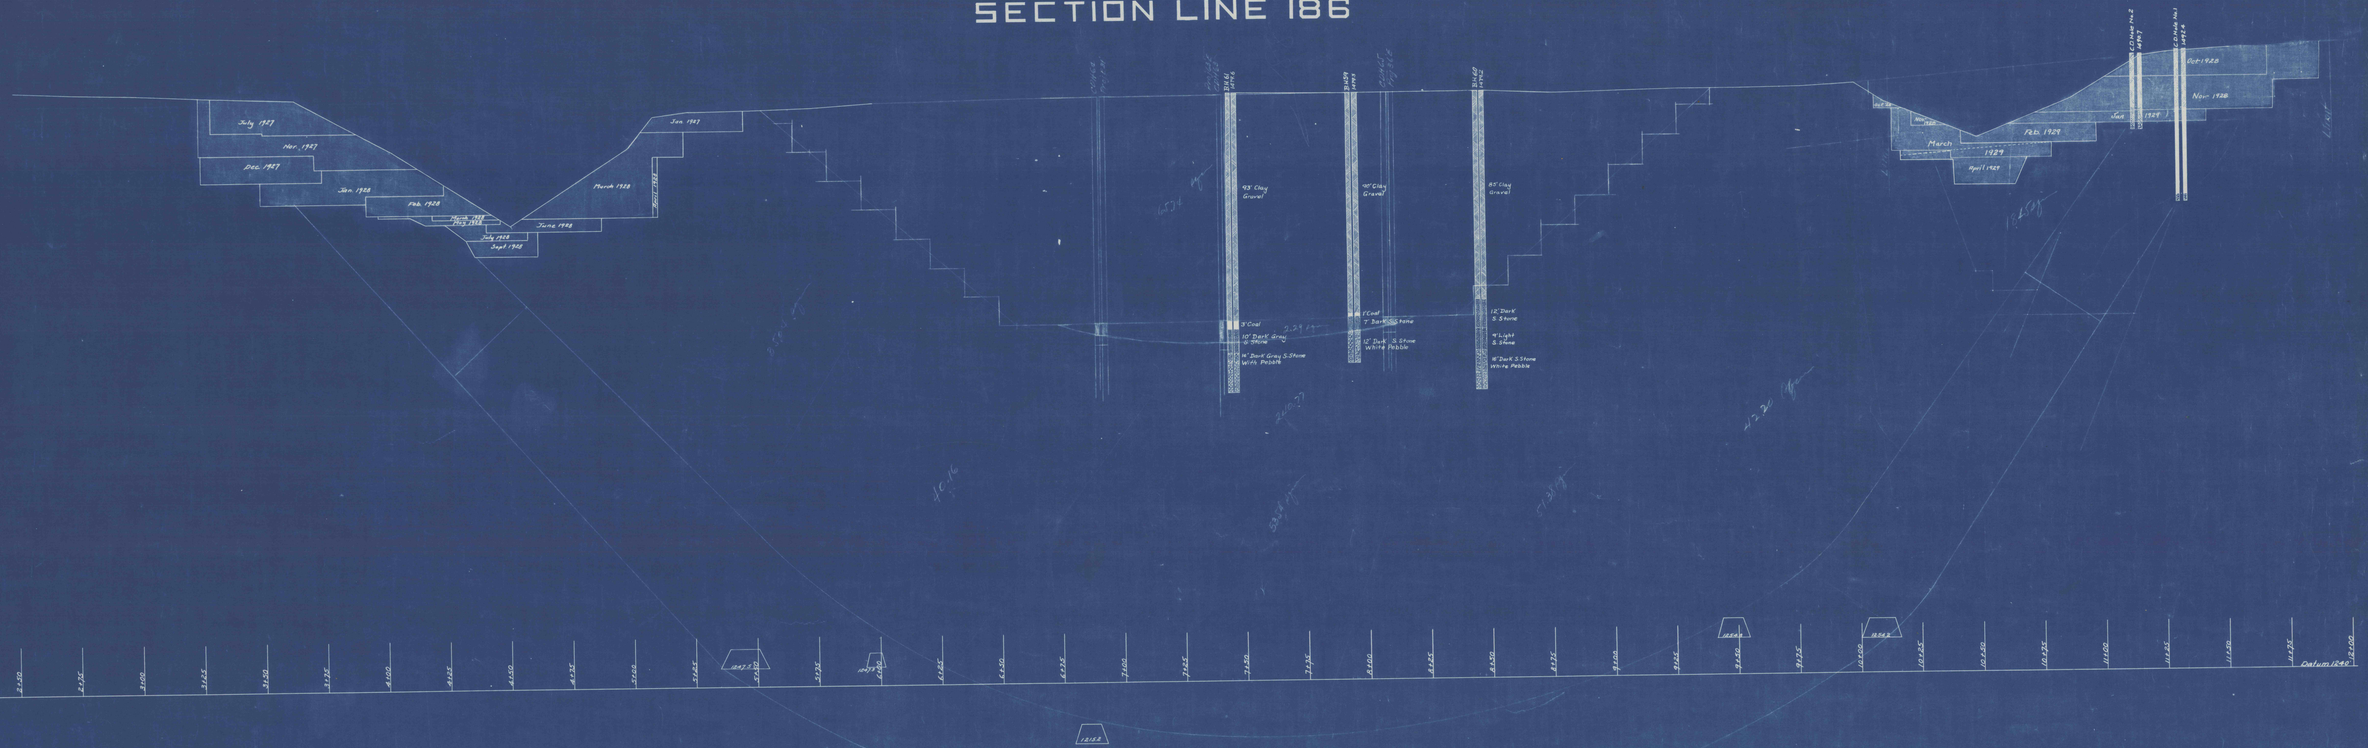SECTION LINE 186