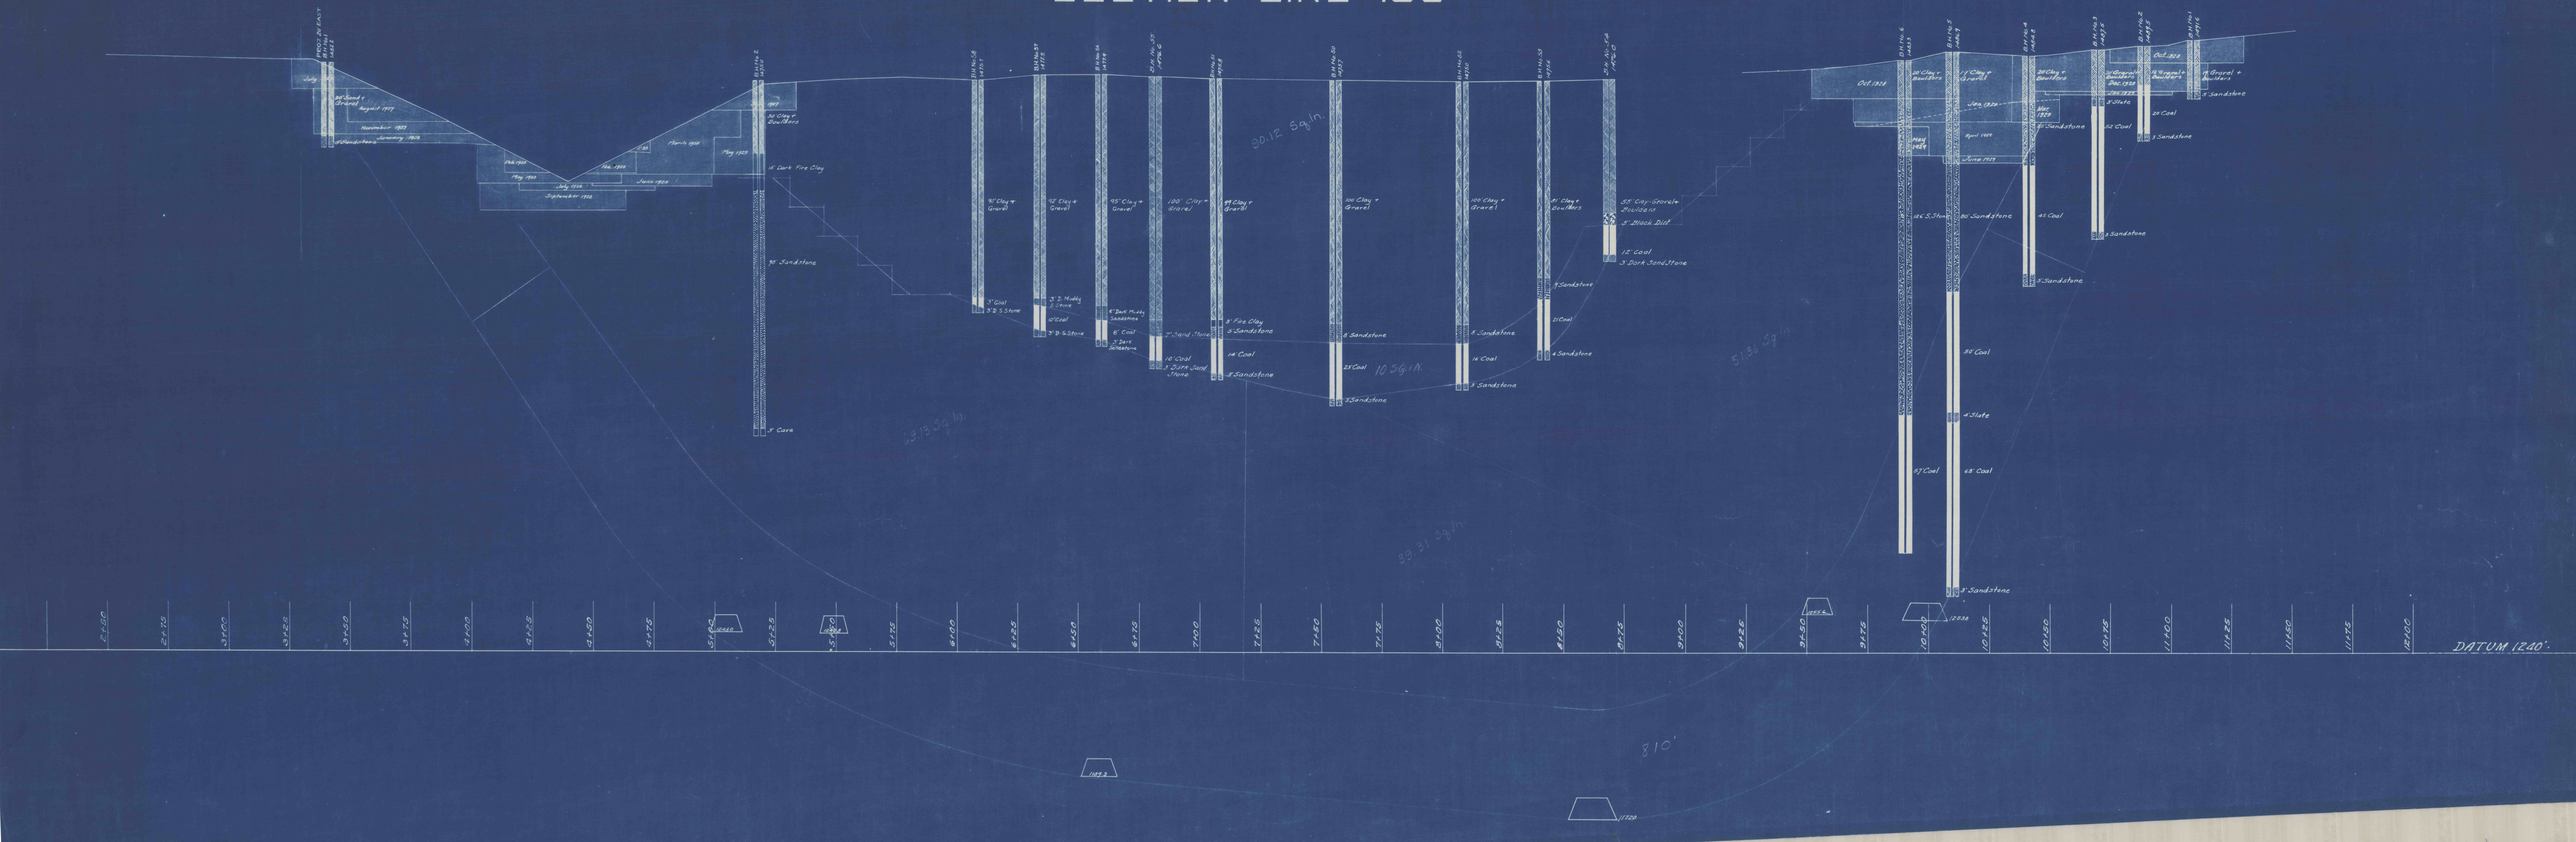SECTION LINE 196