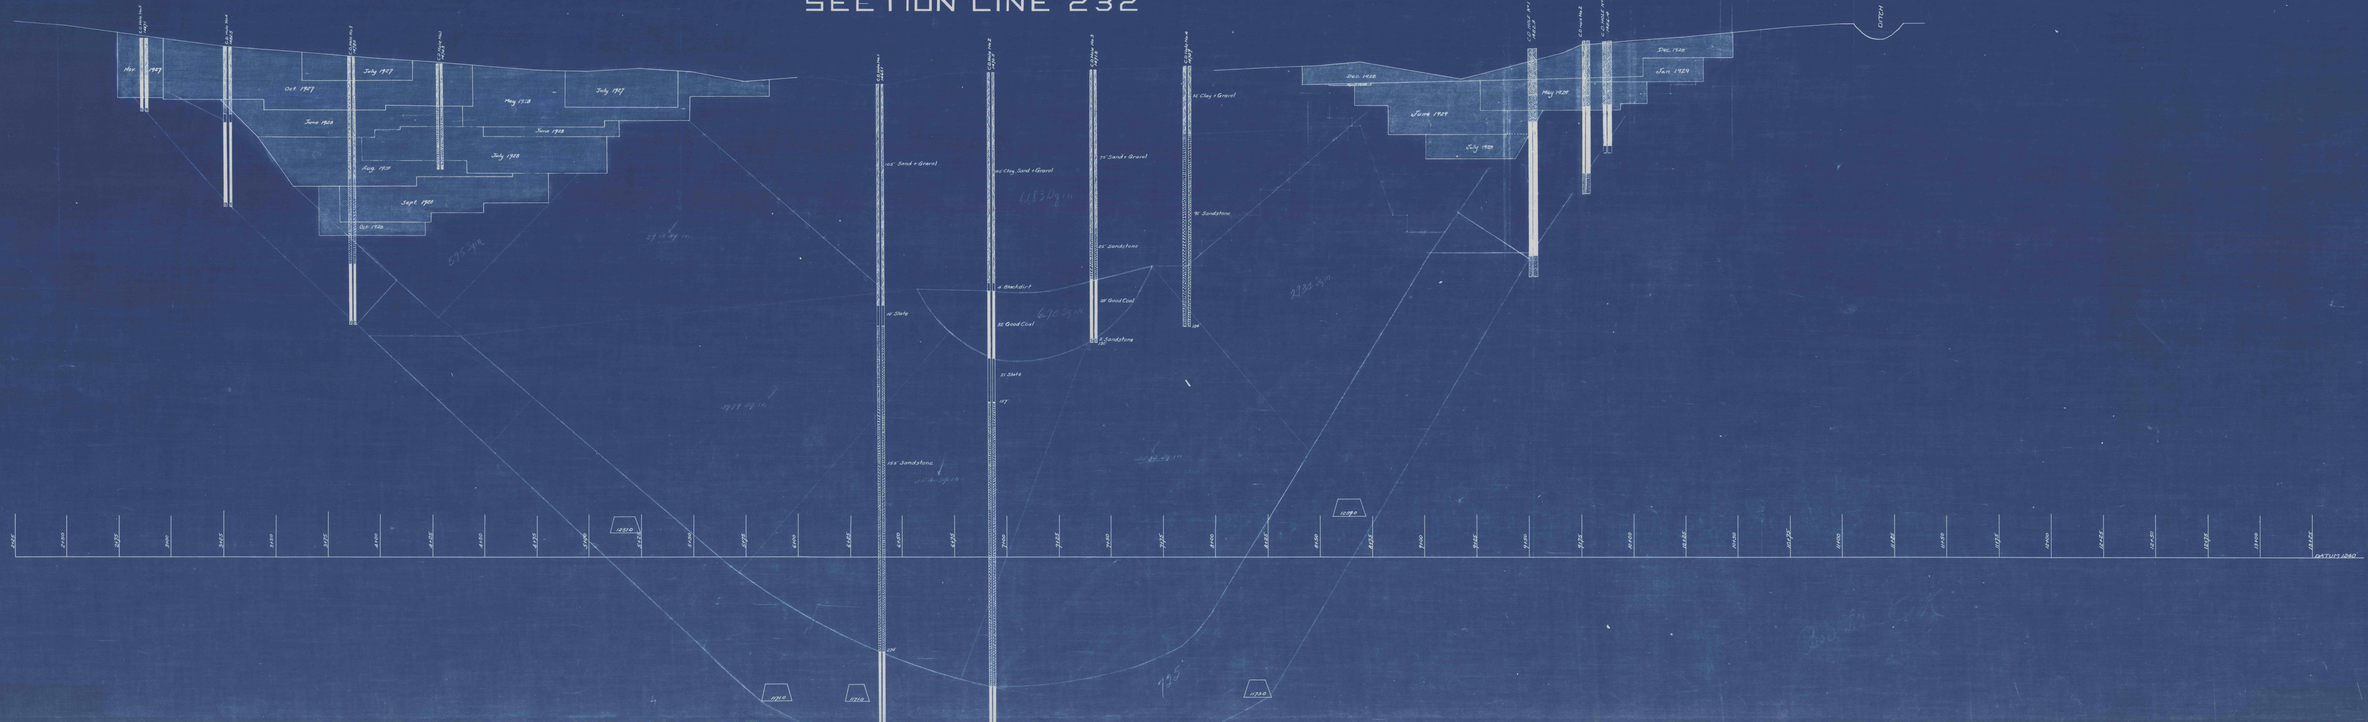SECTION LINE 232