




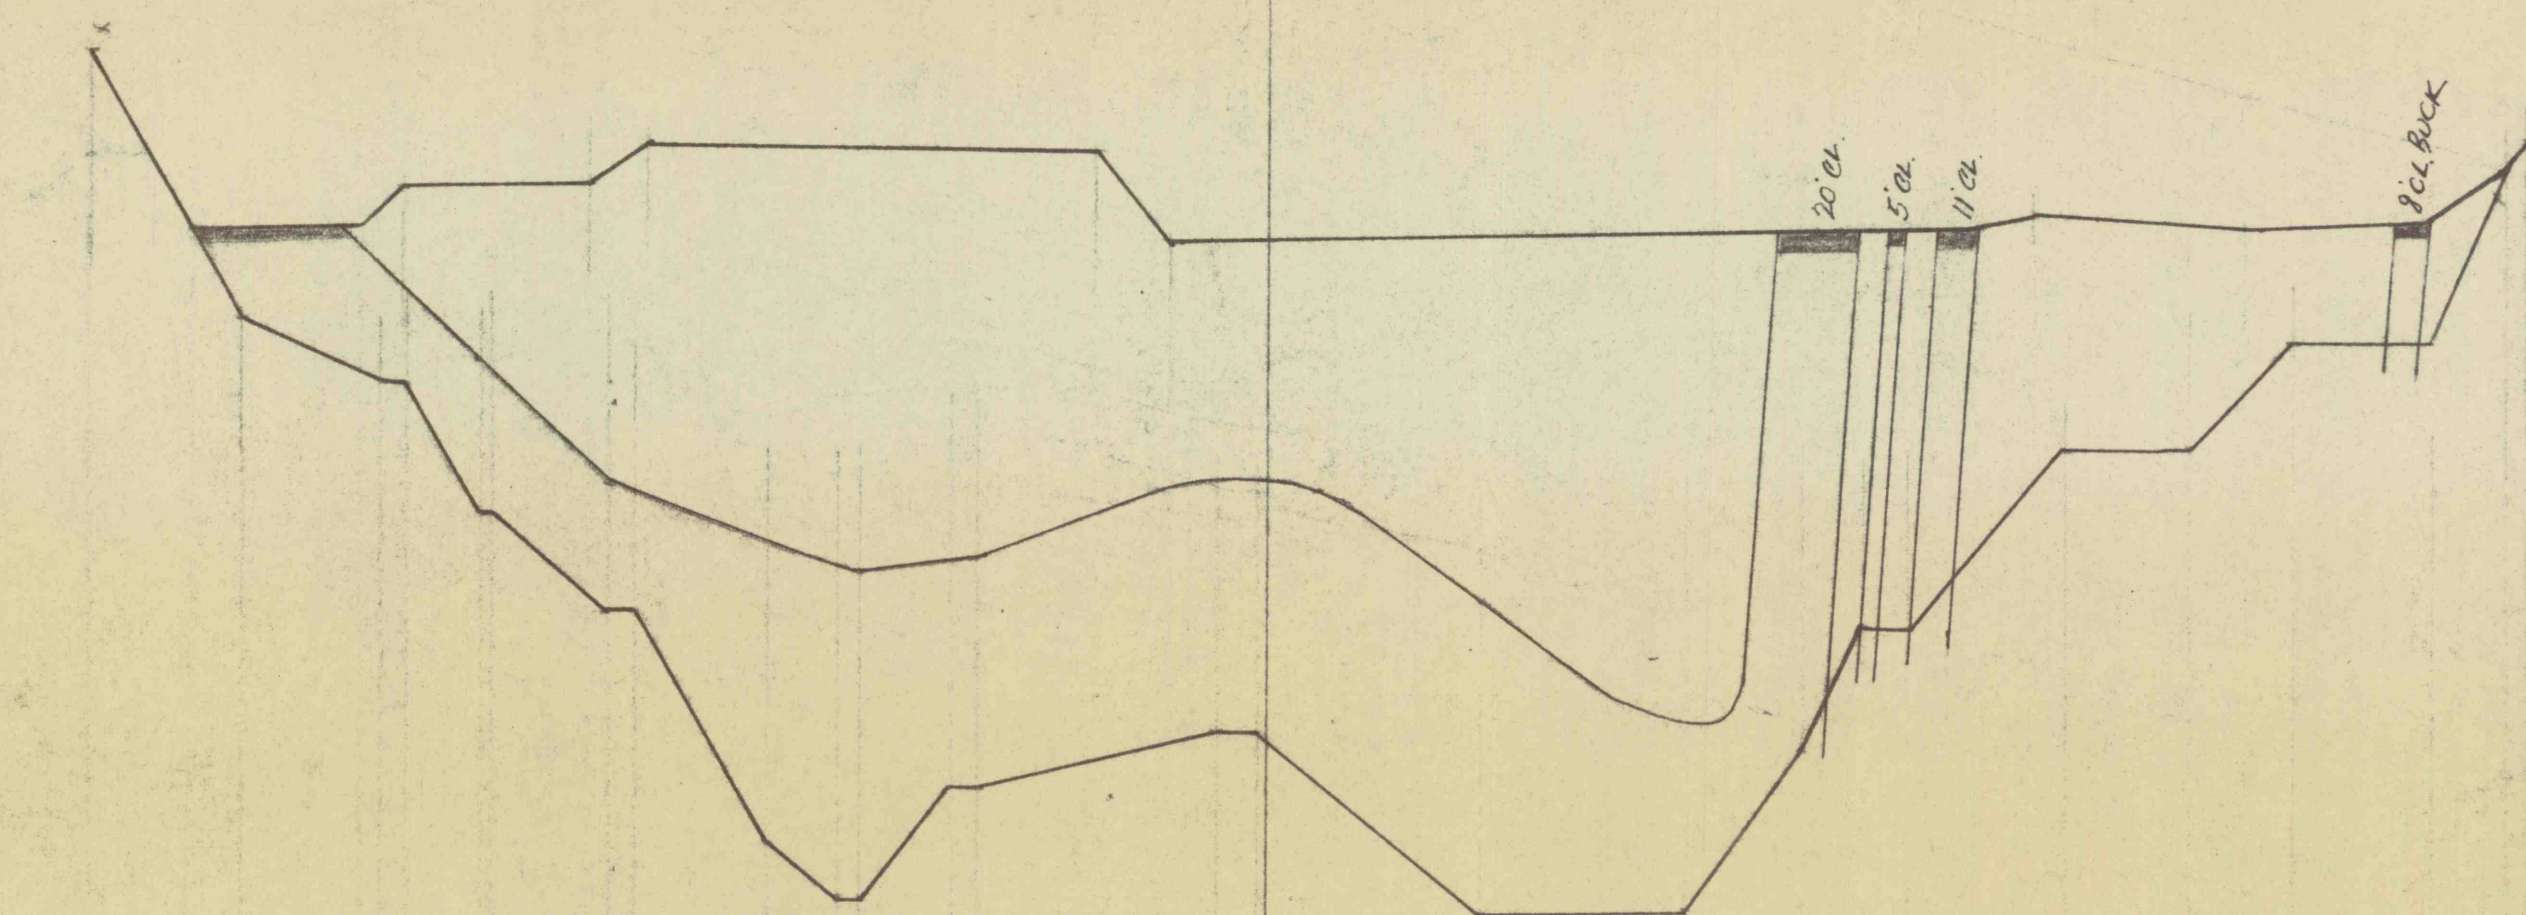


TOTAL = 65550
COAL = 27060

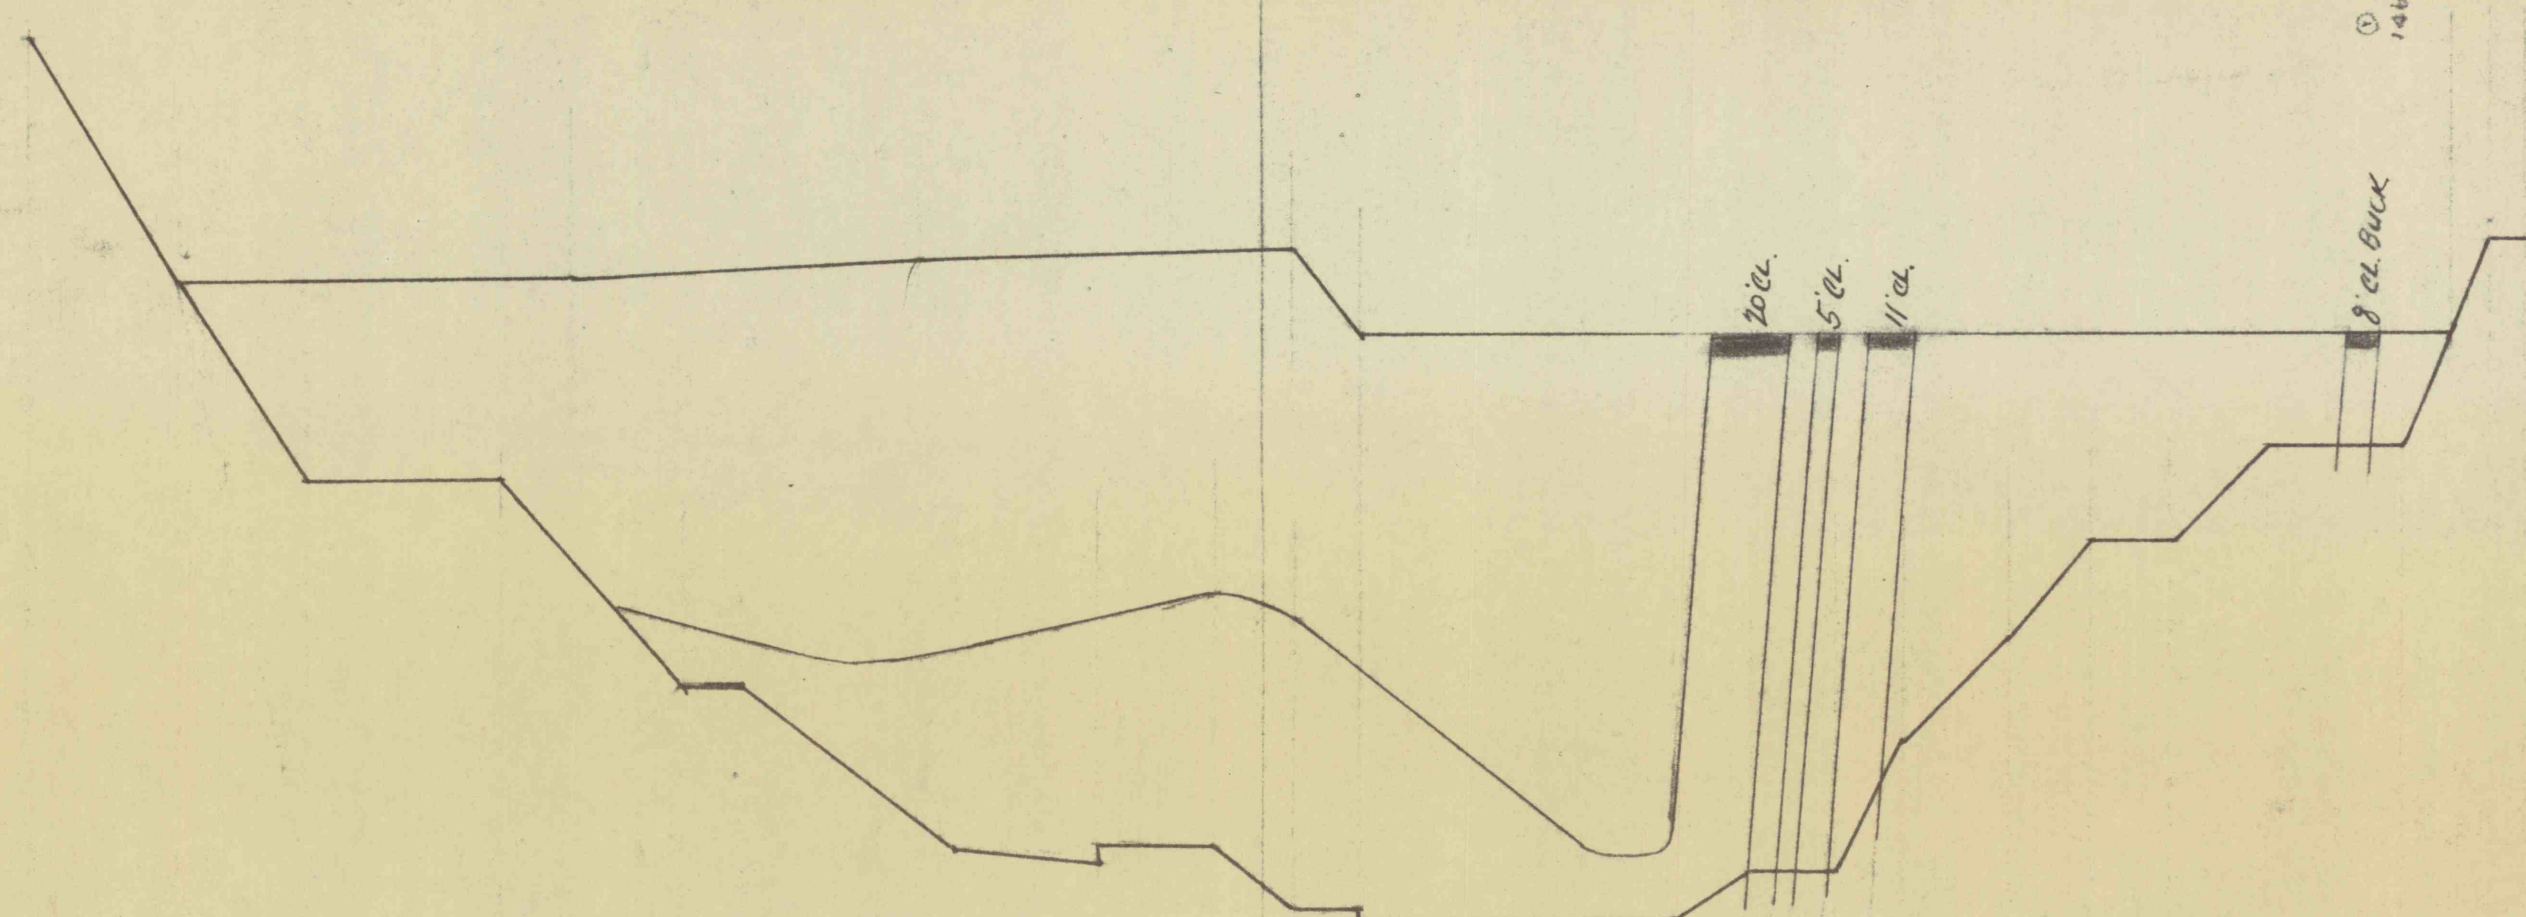


TOTAL = 60400
COAL = 16910

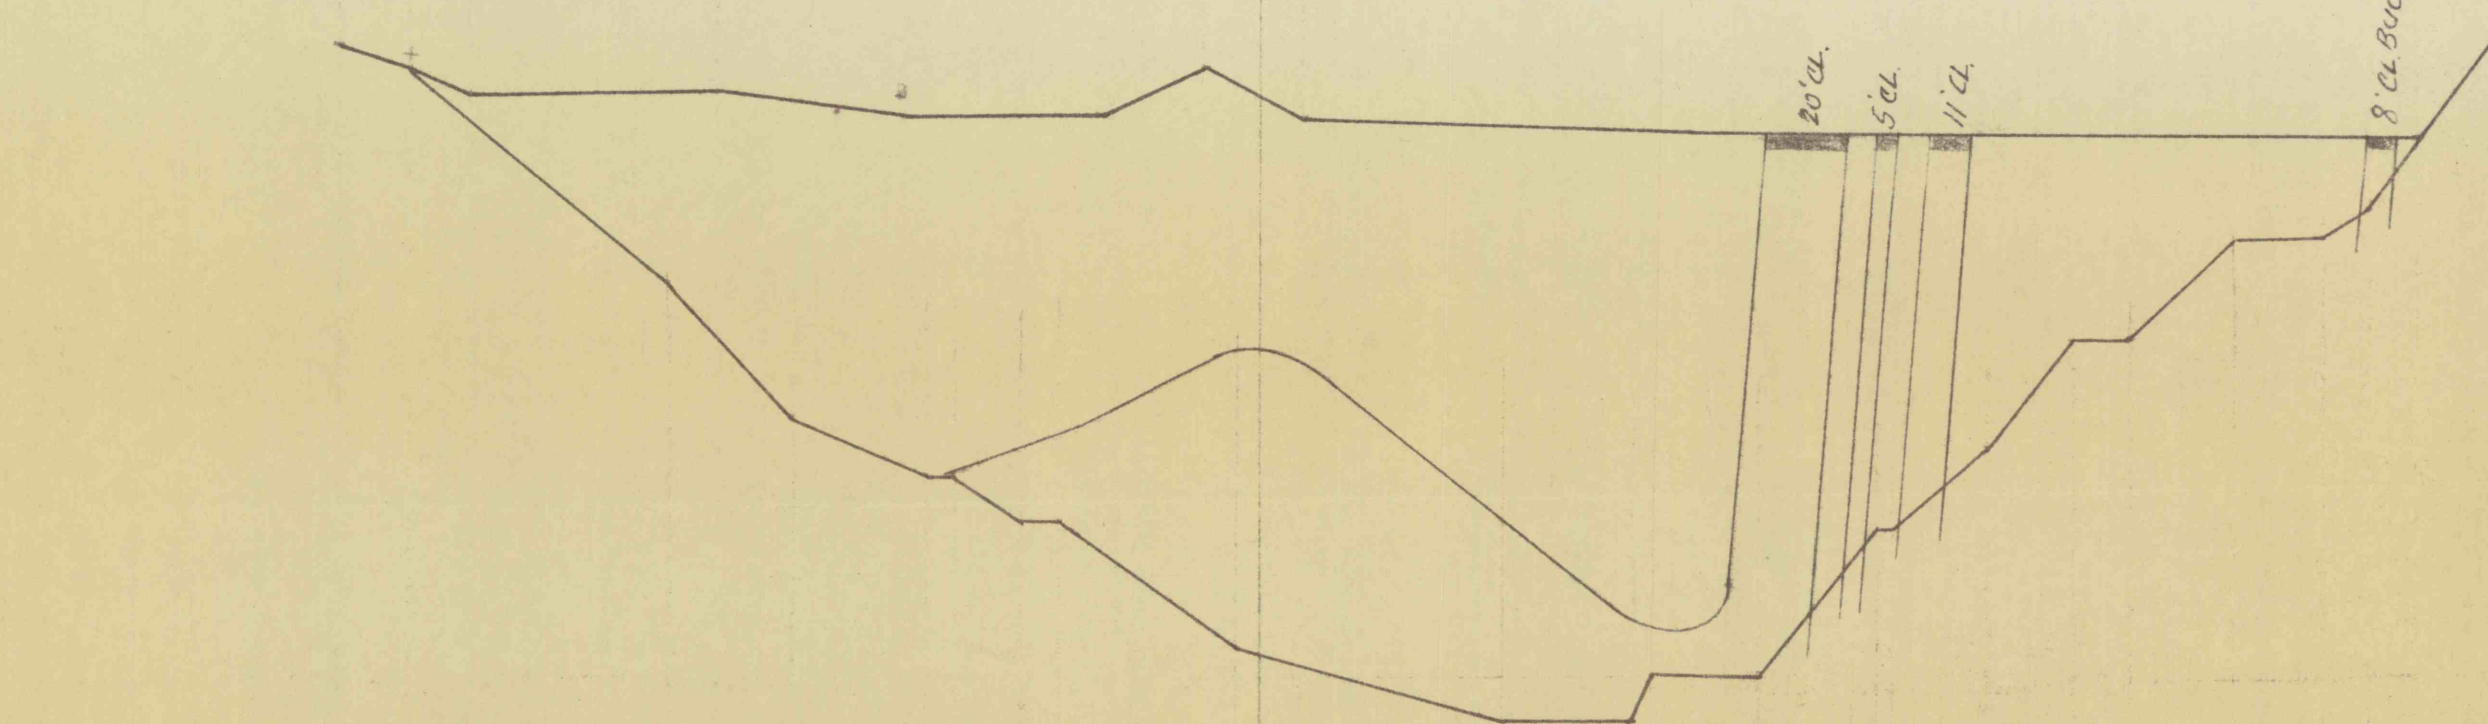


TOTAL = 46680
COAL = 13780

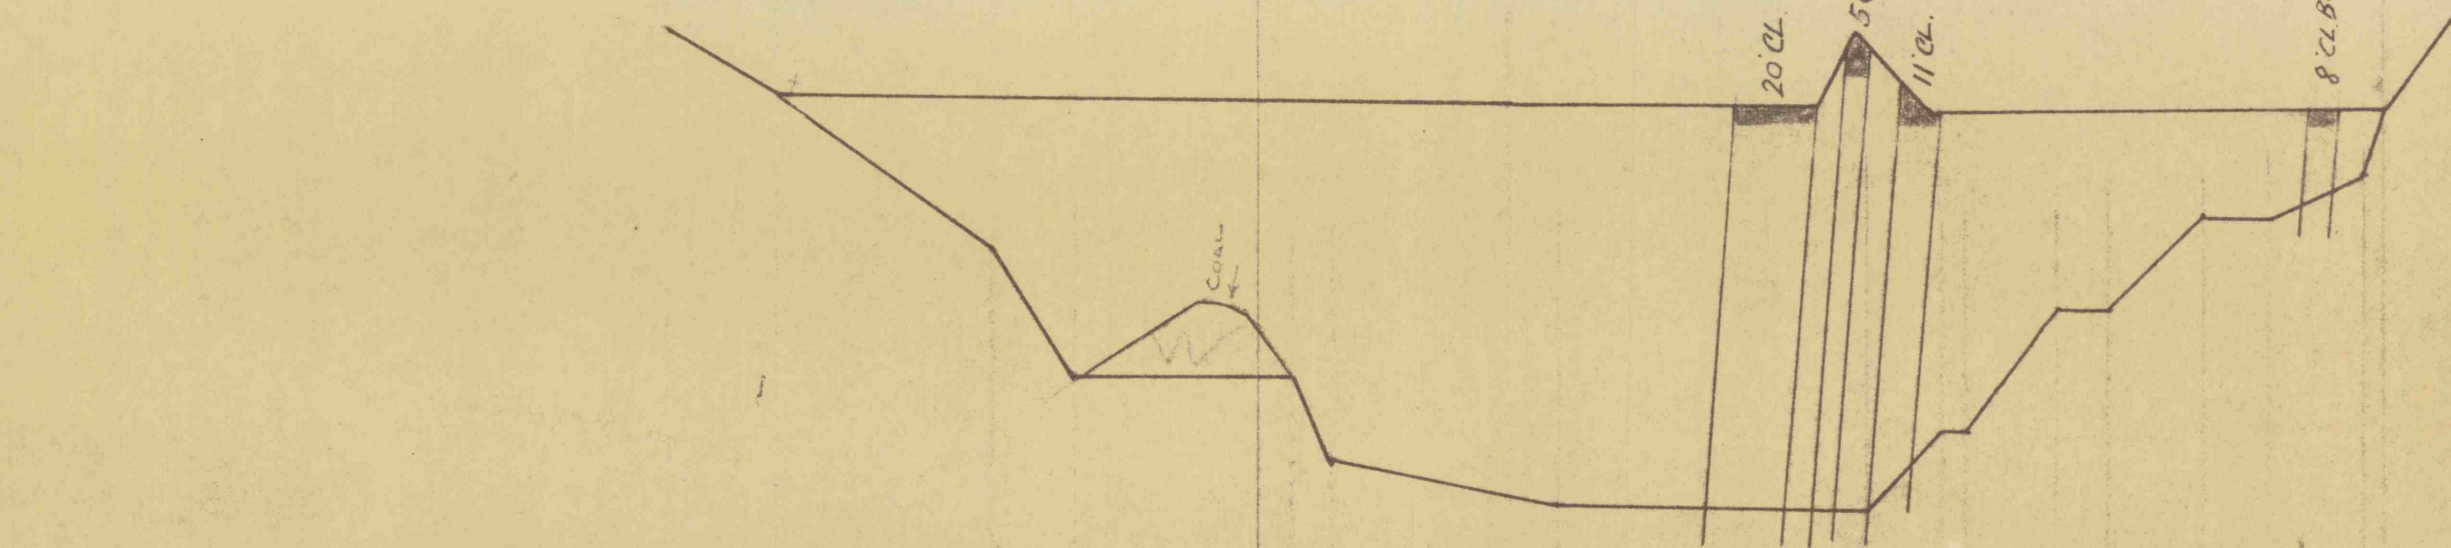

TOTAL = 28320
COAL = 4650

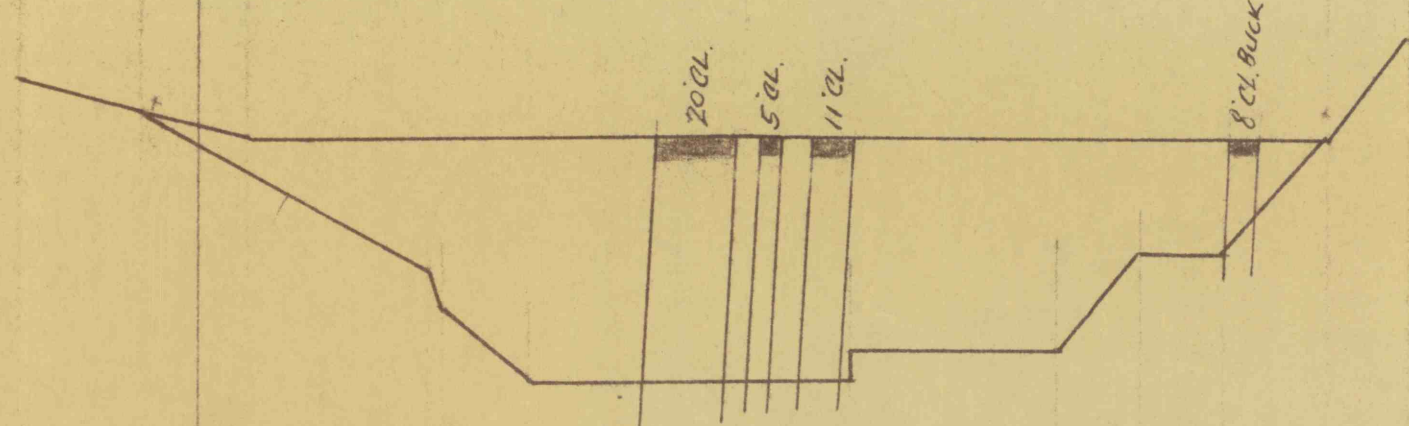

TOTAL = 12760
COAL = 2500
TOTAL 12900
COAL 25042

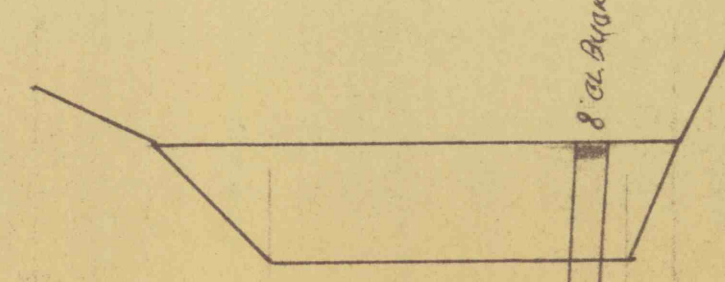

TOTAL = 3440
COAL = 240