


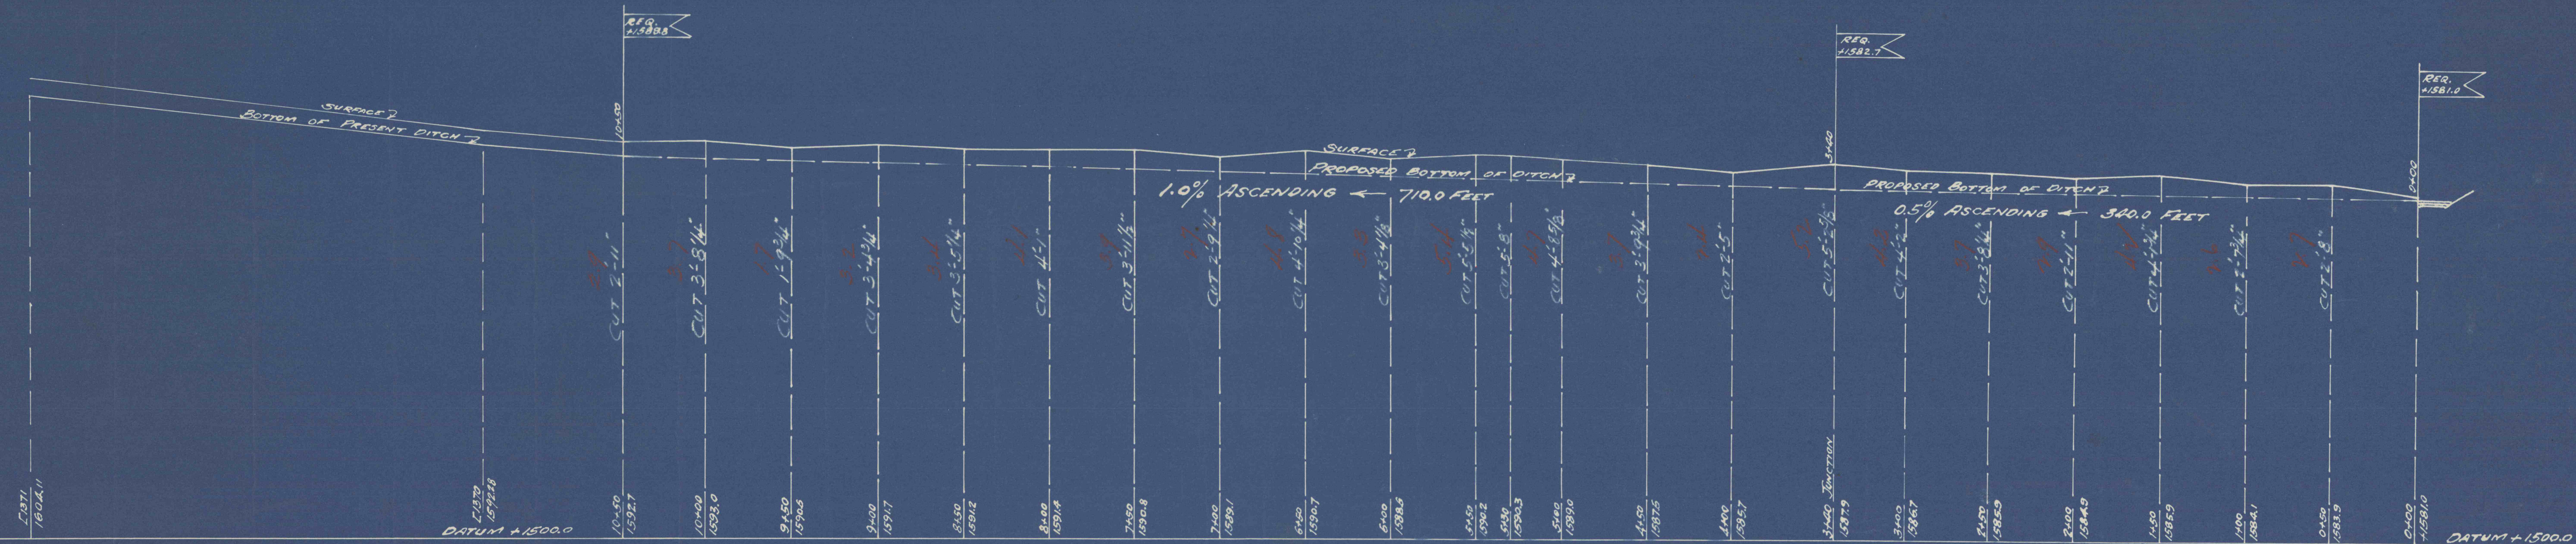

PROFILE SHOWING
 PROPOSED DITCH
 SOUTH AND EAST OF L.V.R.R.
 MILL CREEK COAL COMPANY
 MIDDLE LEHIGH COLLIERY
 SCALE 1" = 50' HOR. OCT. 19th 1935
 1" = 20' VER.