


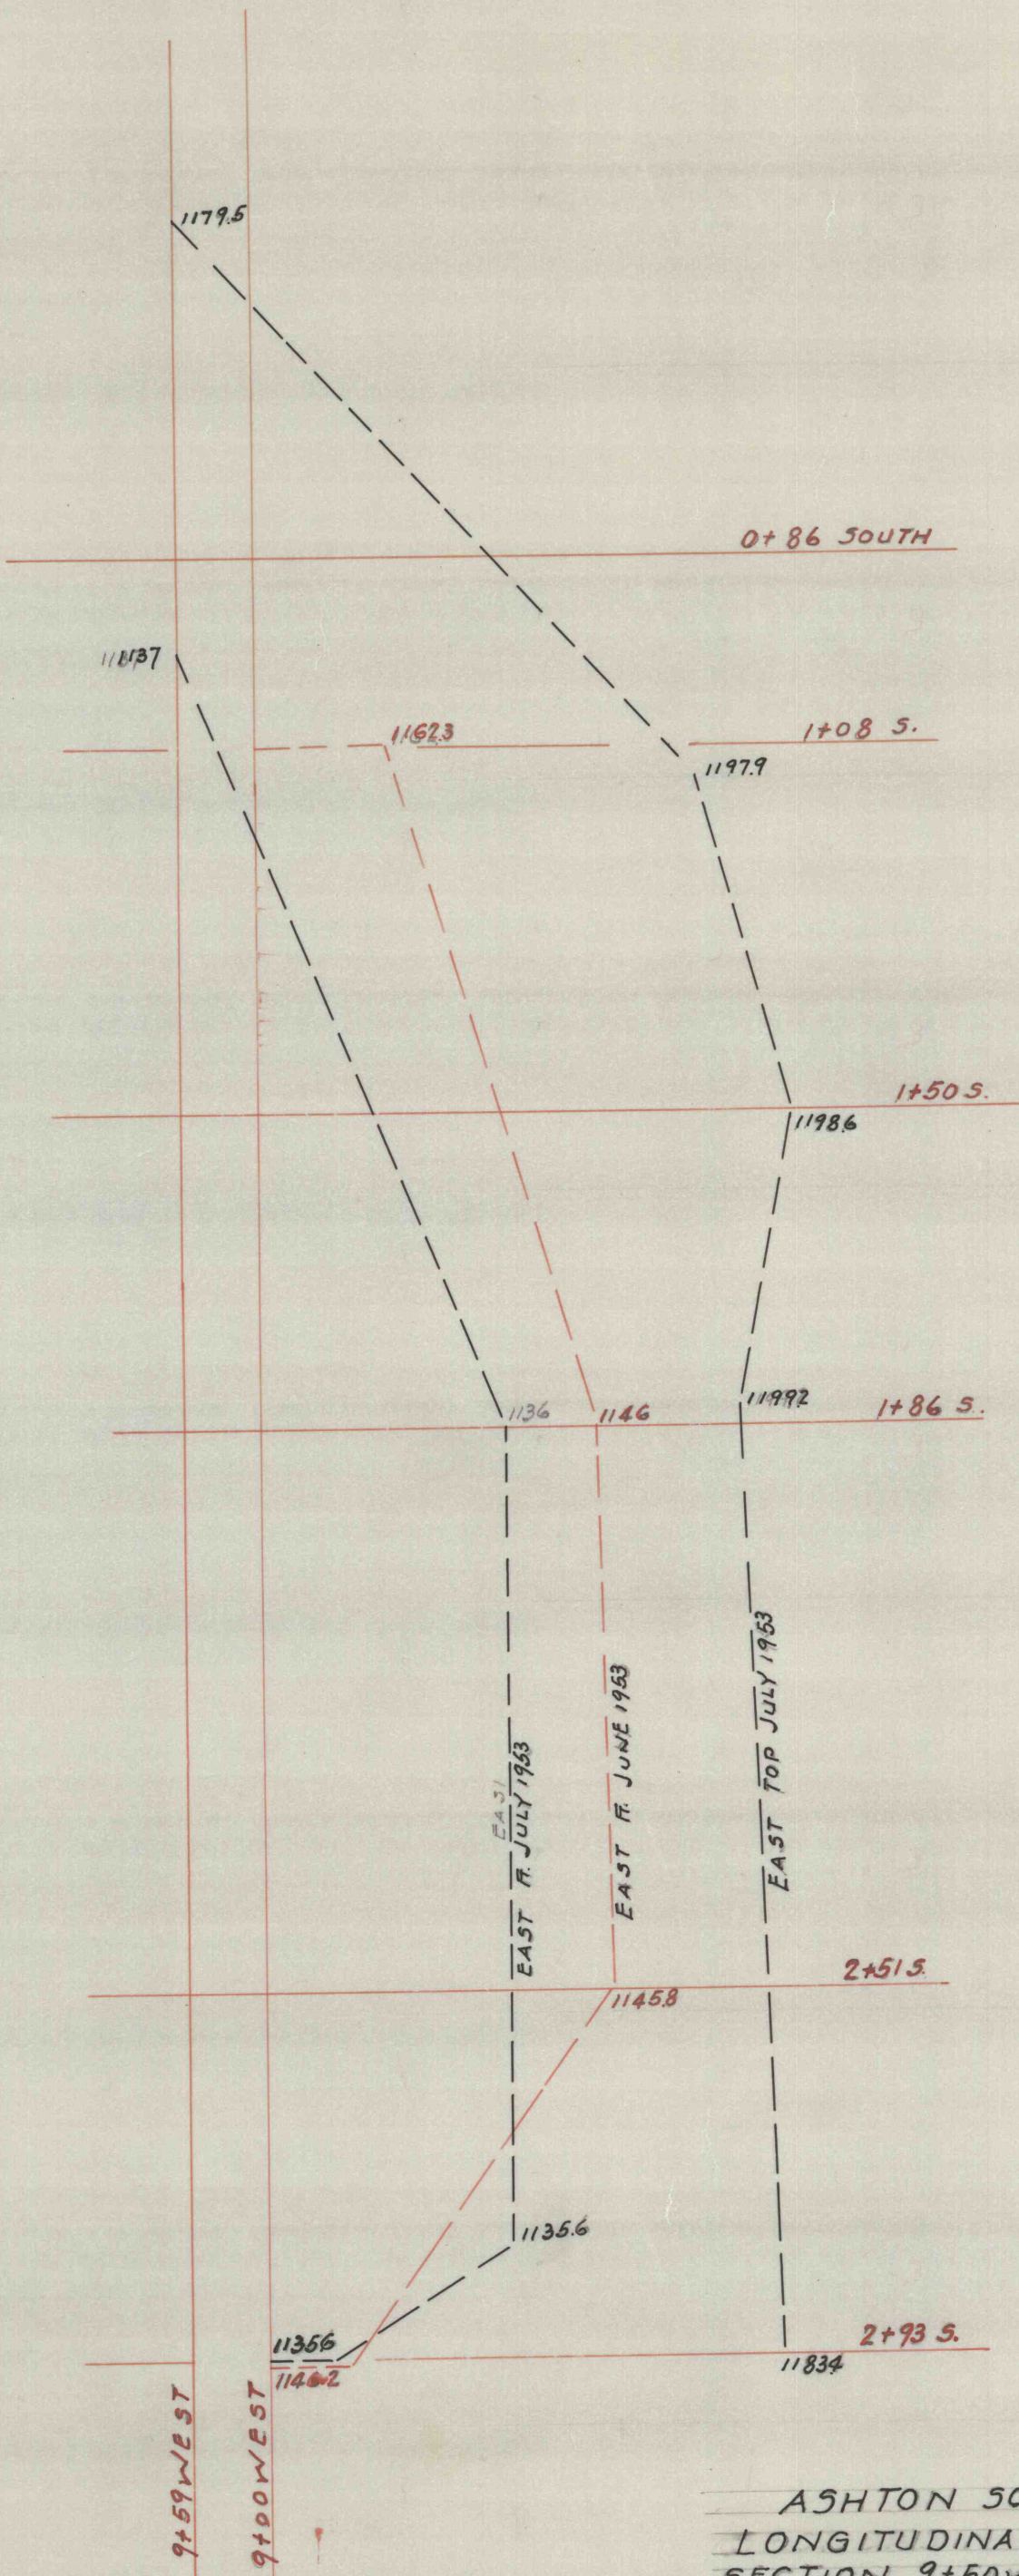

ASHTON SOUTH SIDE STRIPPING
 LONGITUDINAL SECTIONS BETWEEN
 SECTION 9+50W & EAST FACE OF WEST PIT
 MAR 4-1955 J. ROBERT BAZLEY INC.