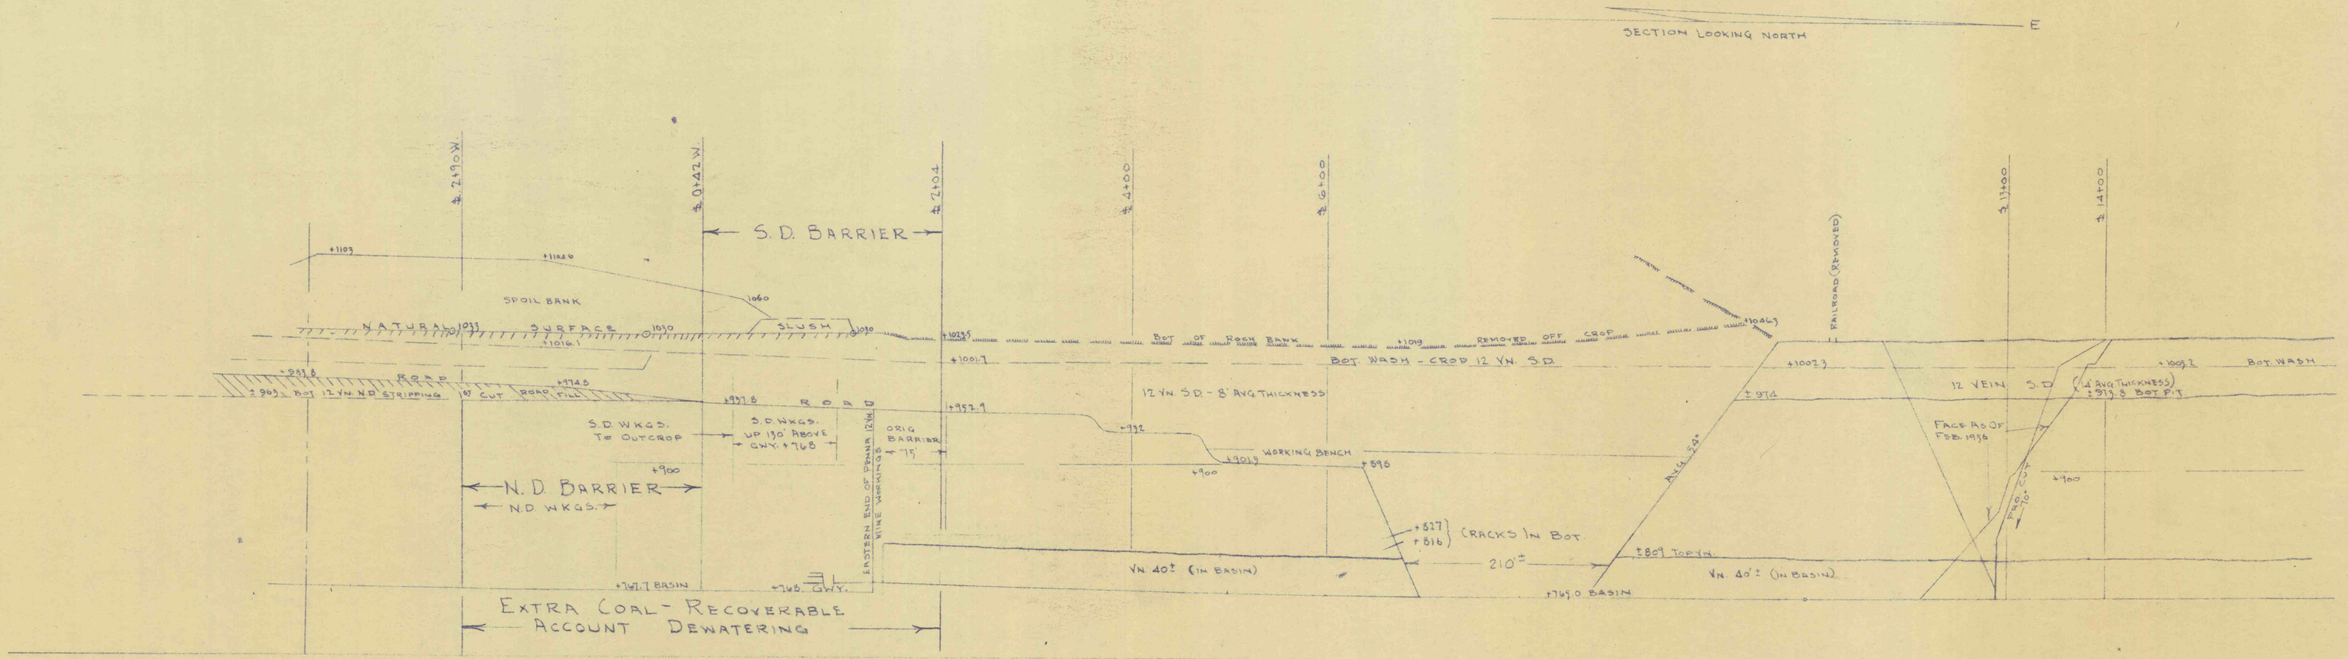

LONGITUDINAL SECTION THROUGH ℄ PENNA. 12 VN. BASIN STRIPPING AREA SHOWING STRIPPING WORK COMPLETED TO DATE

SCALE 1" = 100'