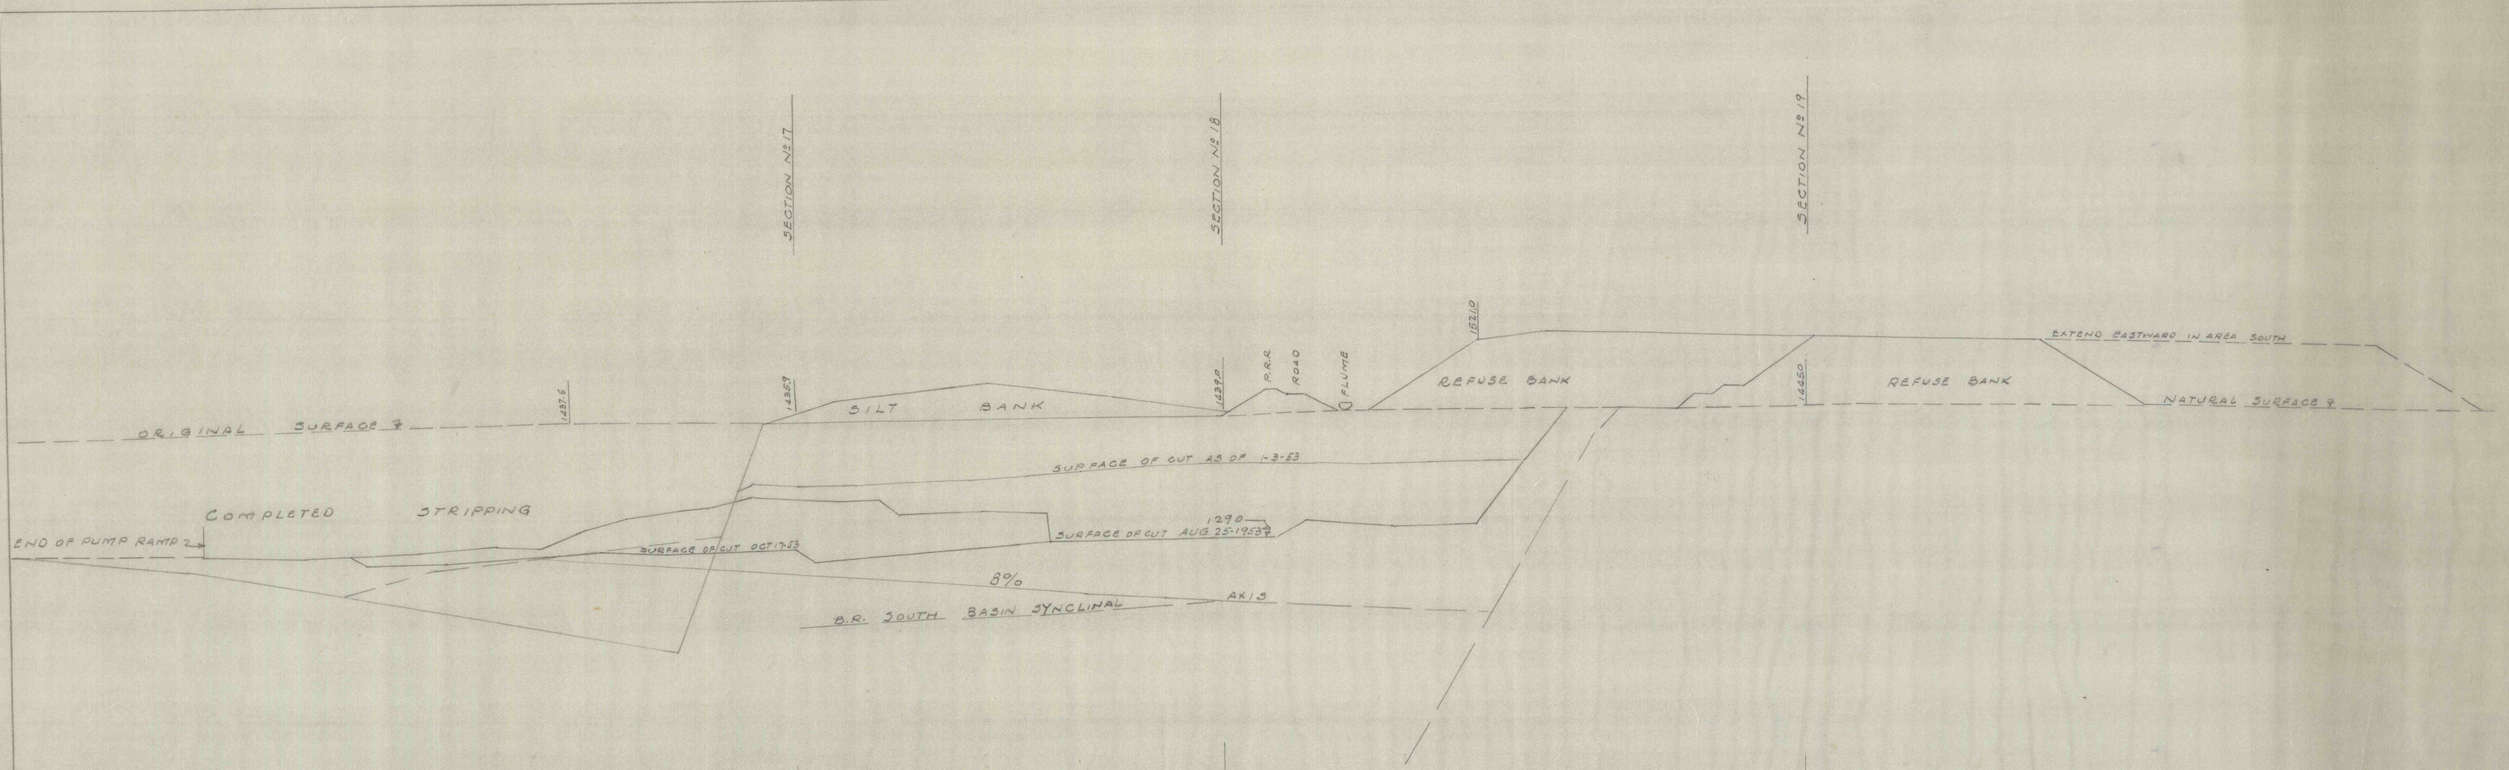

LONGITUDINAL SECTION
THROUGH
MOREA RAILROAD RESERVATION PILLAR

JAN. 21-1949 SCALE 1" = 100 ft. LOCUST COAL CO.

COPIED OCT. 3-1951

ENGINEERING DEPT
LOCUST COAL & LAND CO.
CONNELLSVILLE, PA.