


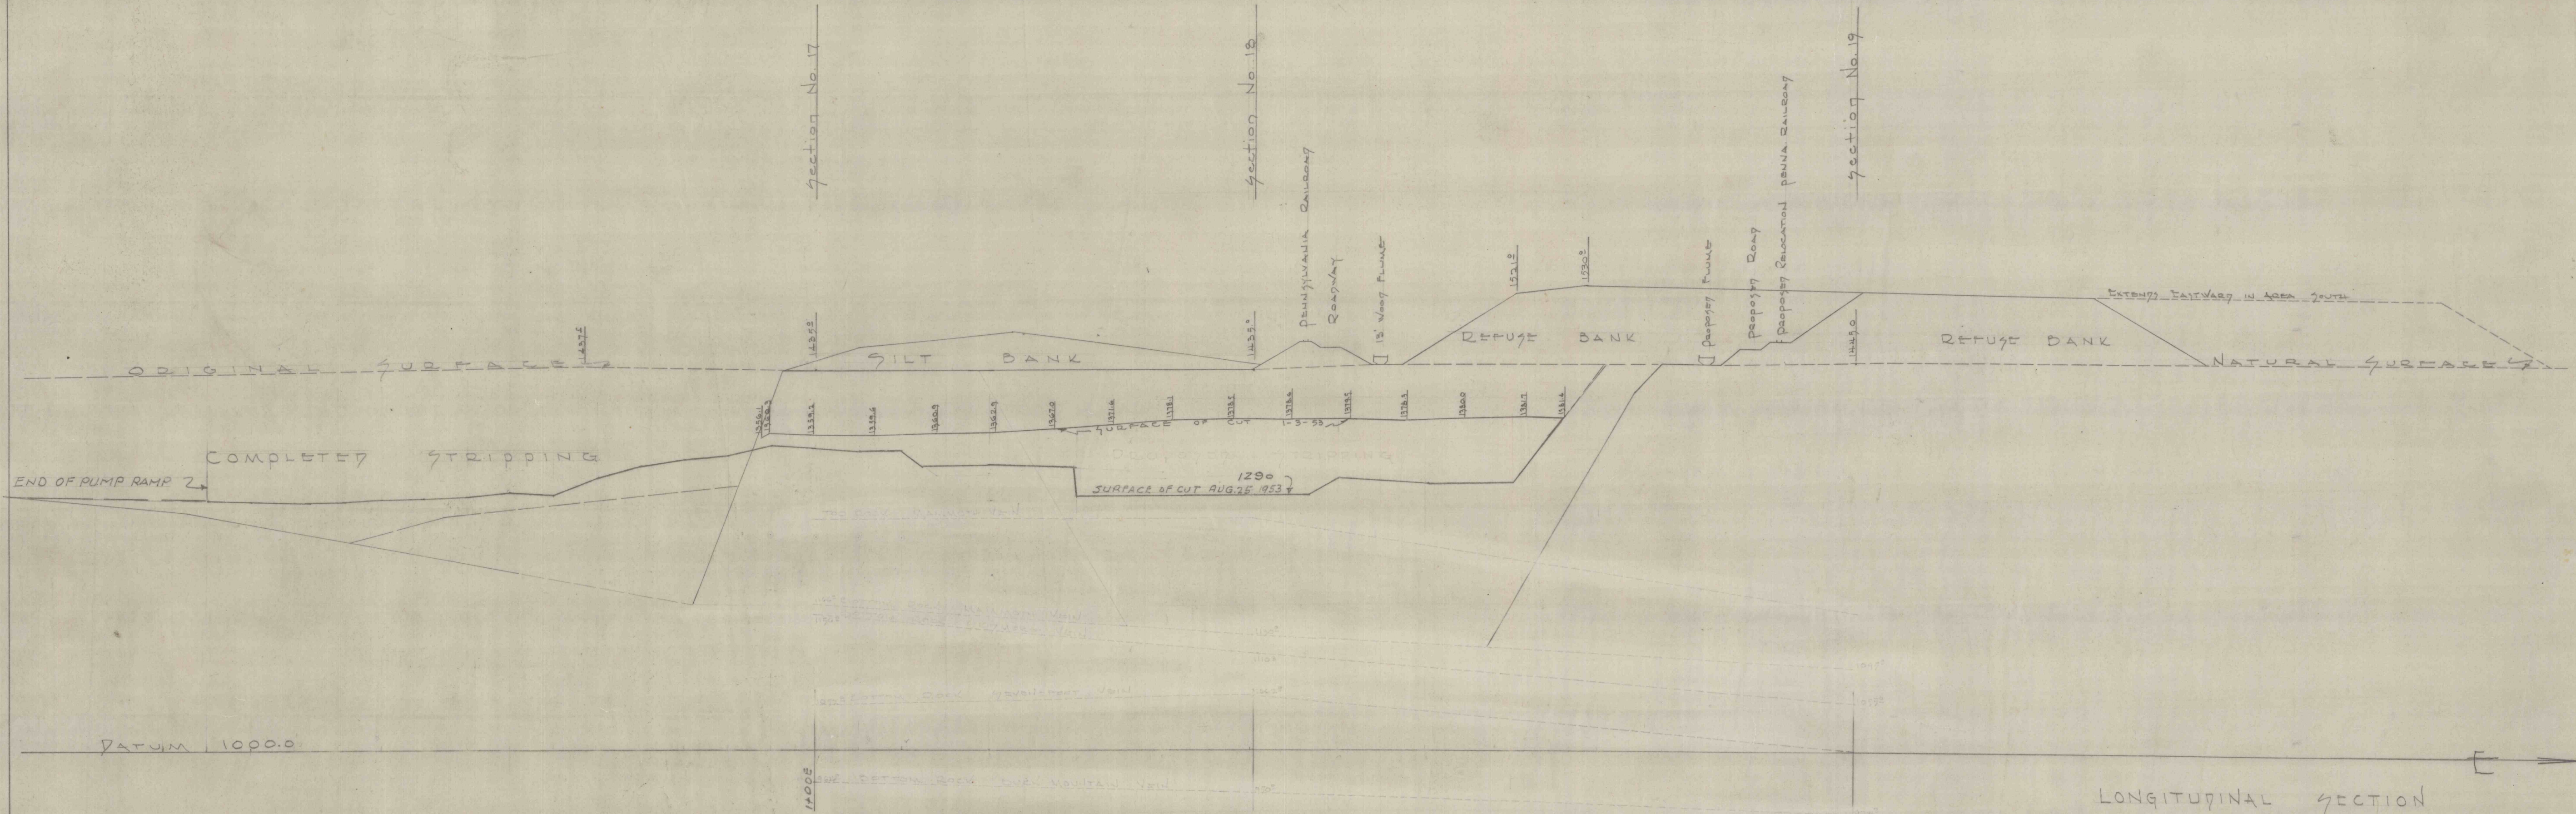

LONGITUDINAL SECTION
THROUGH
MORA RAILROAD RESERVATION DILLAR
January 21, 1949 Scale 1"=100 ft Locust Coal Co.
Pottsville, Pa.
Copied October 5, 1951
ENGINEERING DEPT.
J. ROBERT BAZLEY, INC.
POTTSVILLE, PA.