


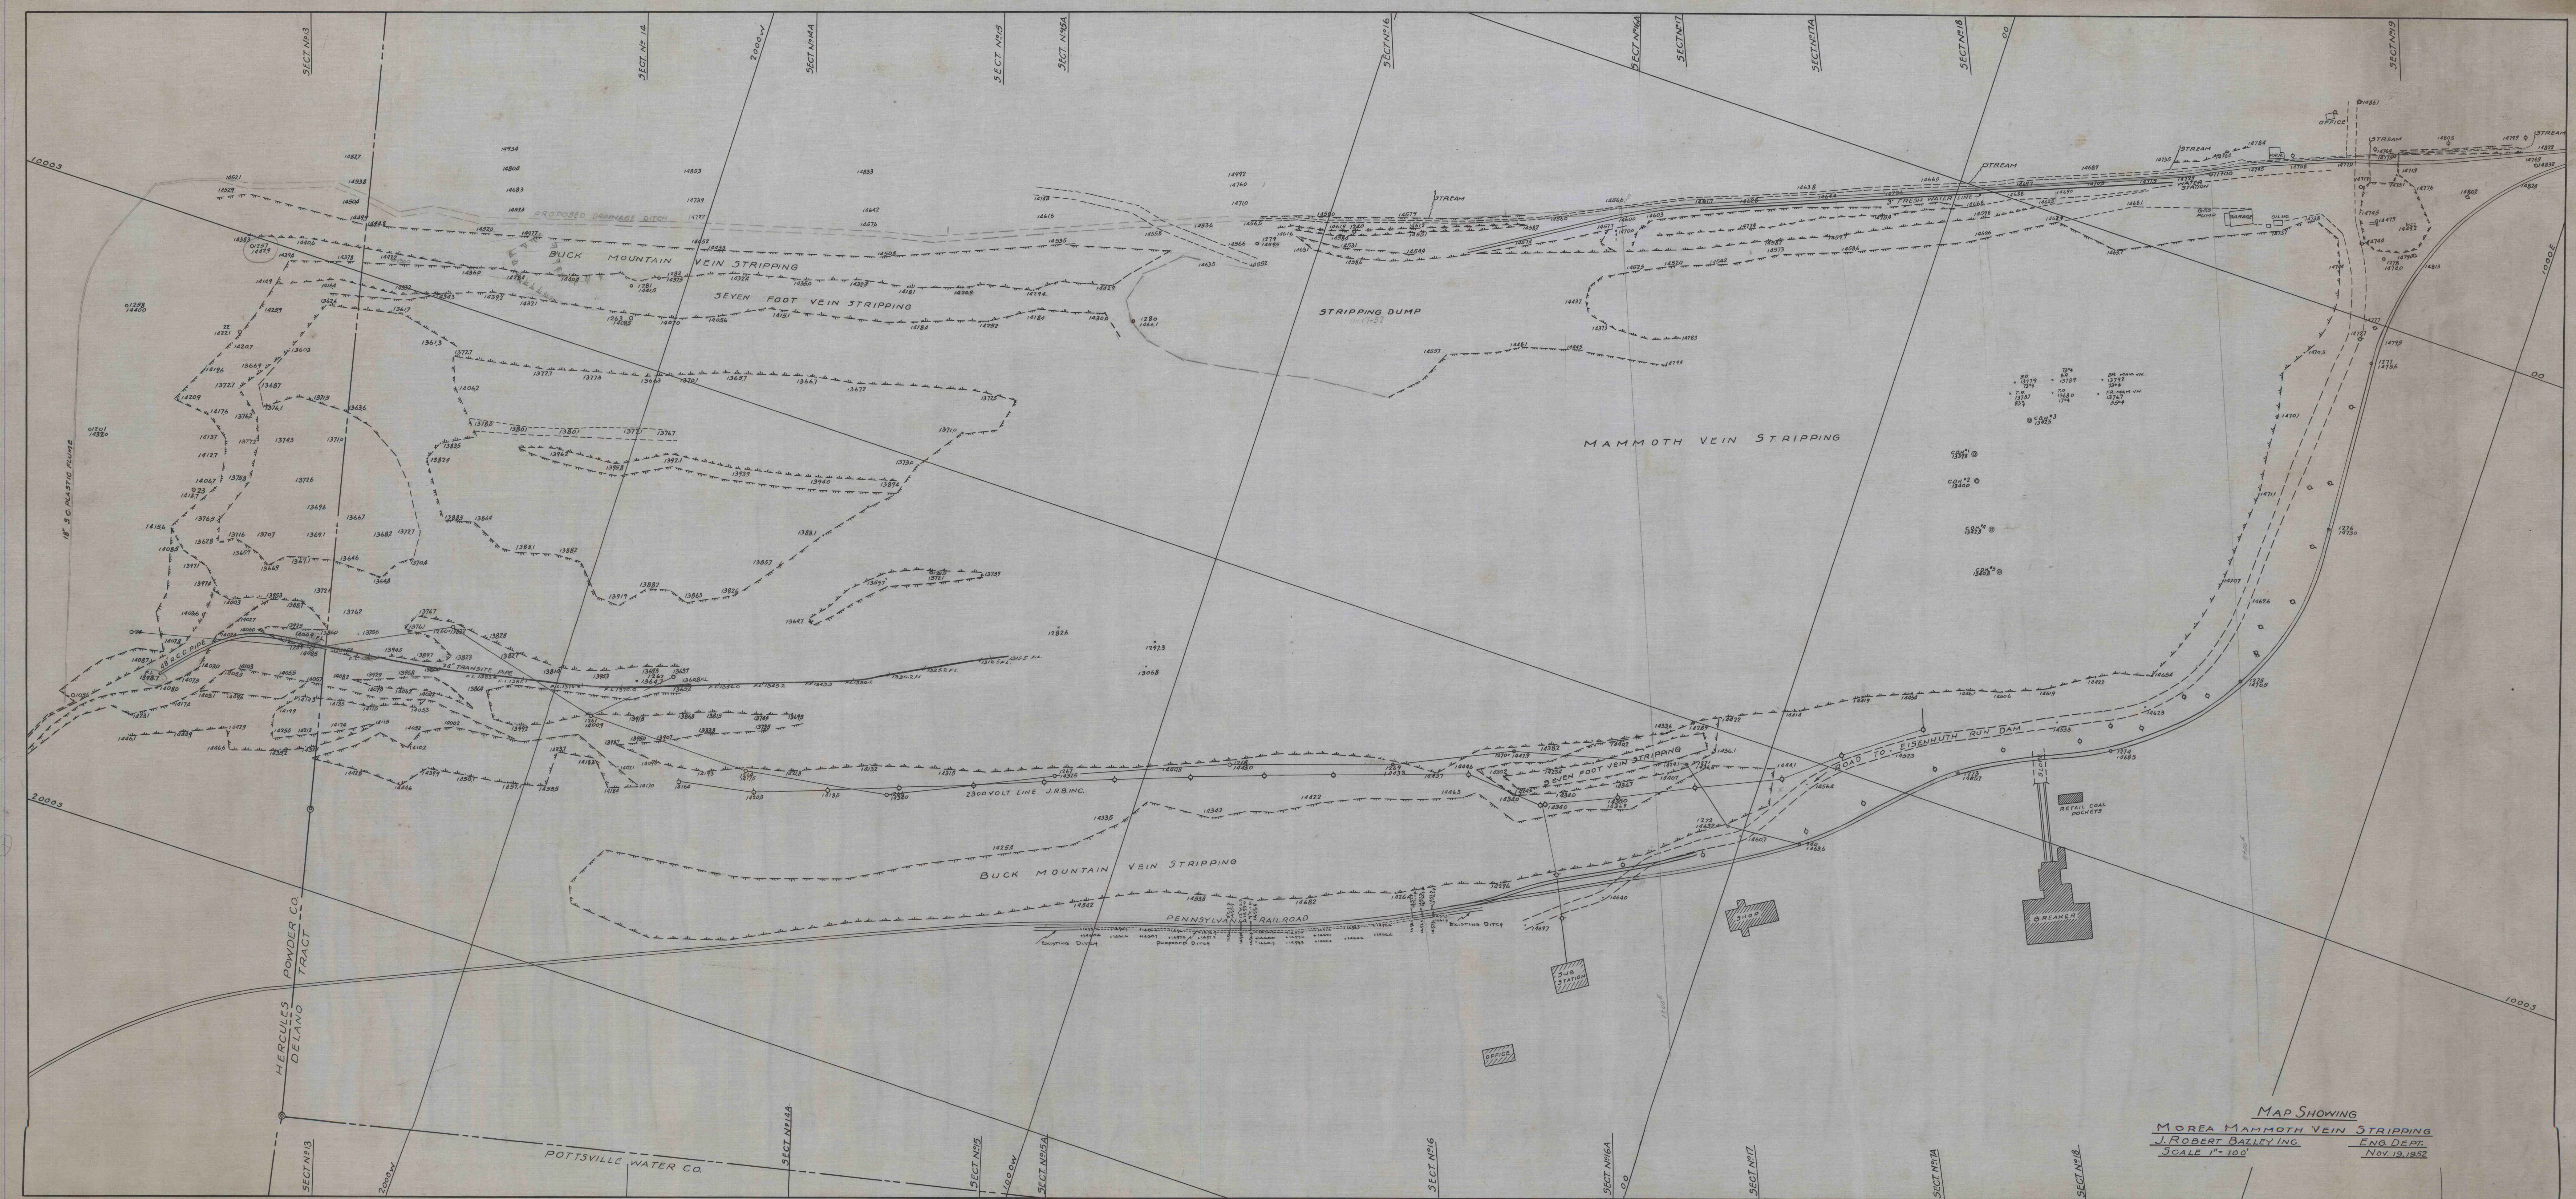

MAP SHOWING
MOREA MAMMOTH VEIN STRIPPING
J. ROBERT BAZLEY INC. ENG. DEPT.
SCALE 1" = 100'
NOV. 19, 1952