


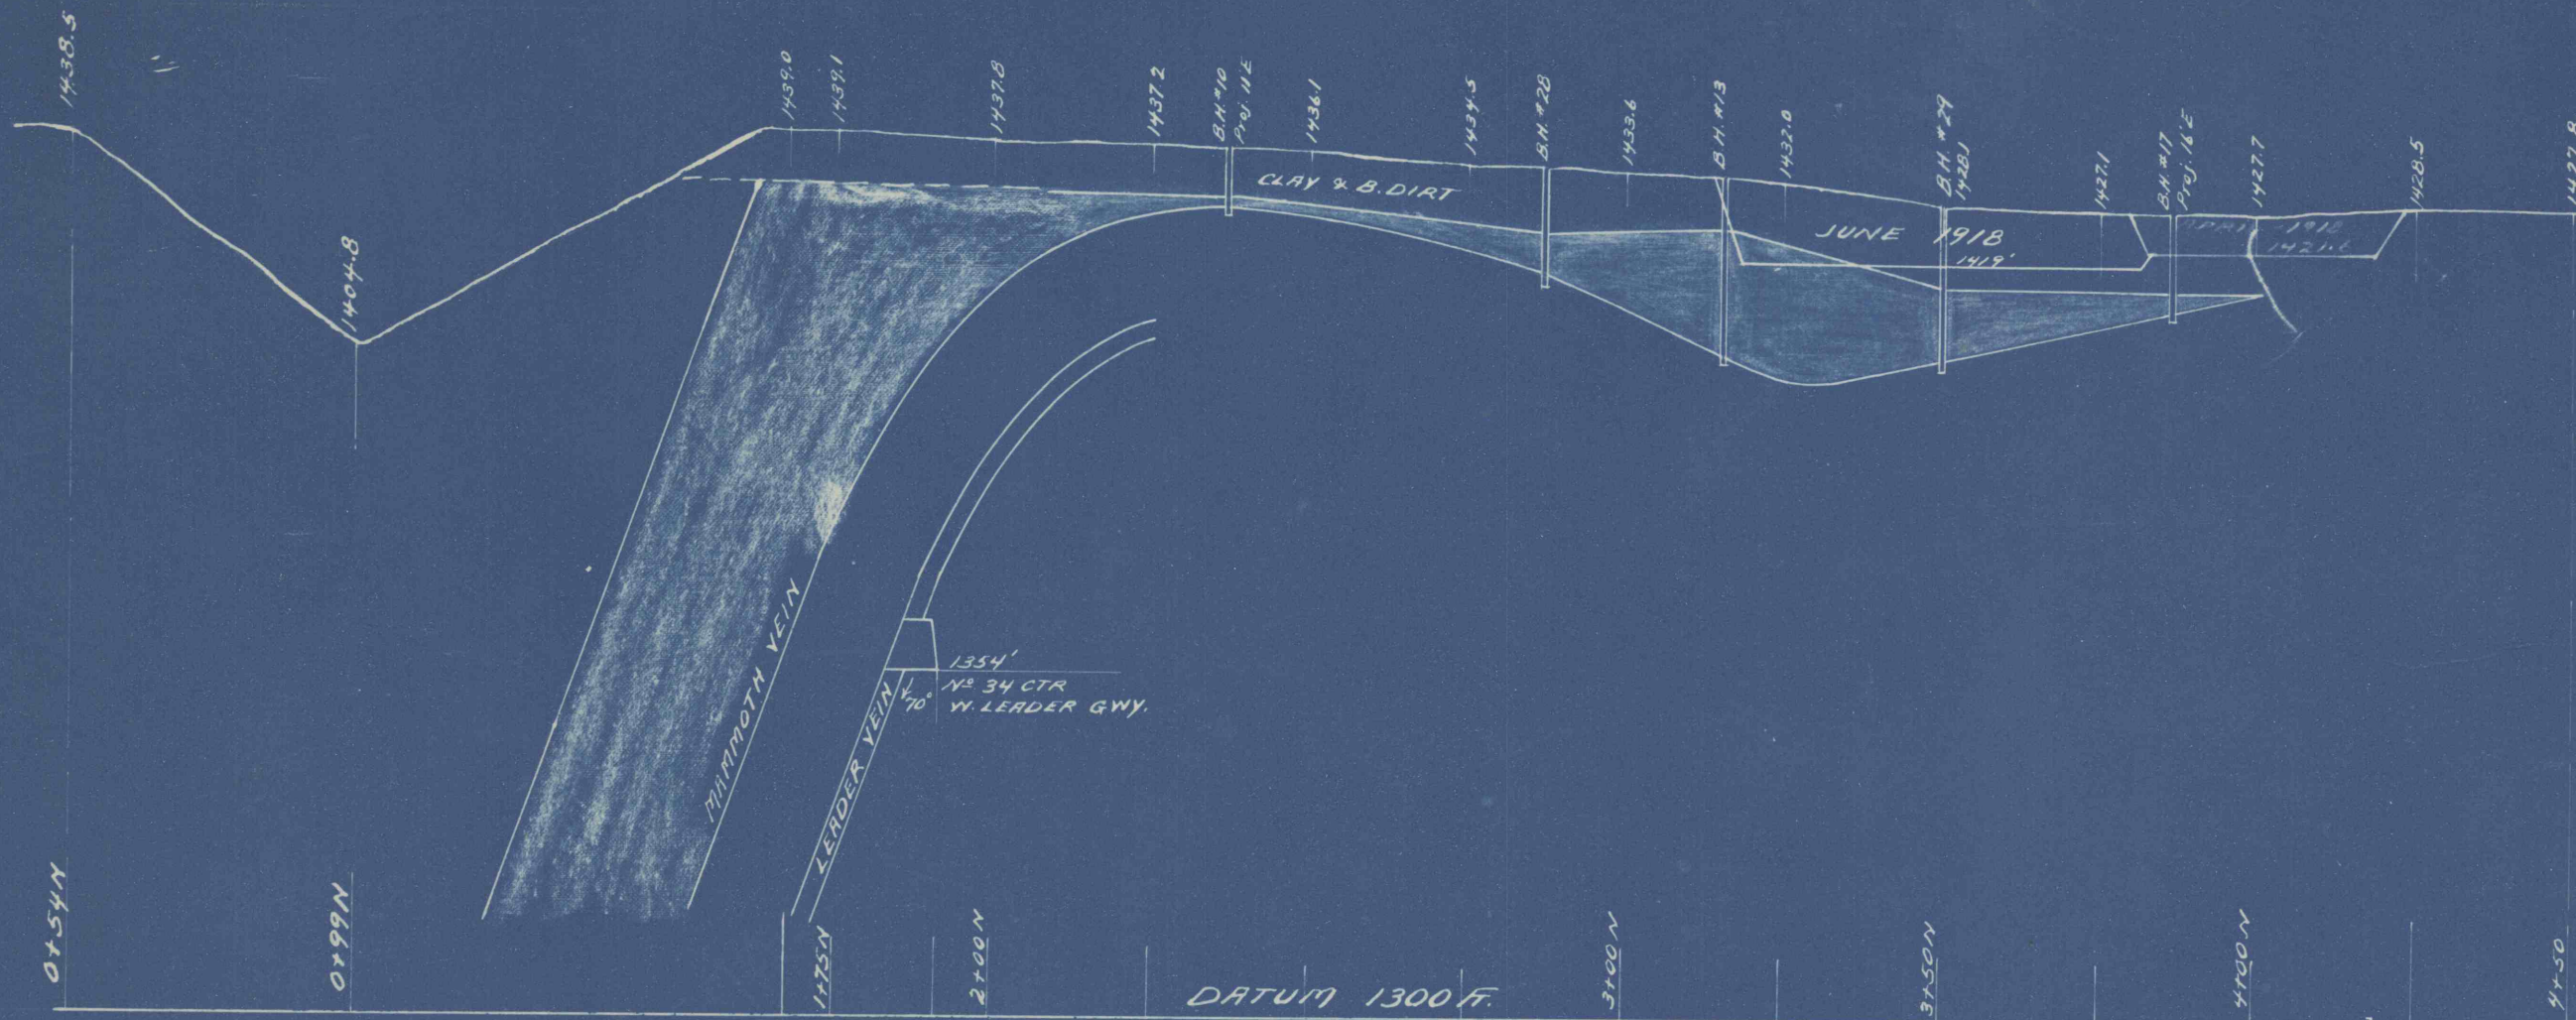

DATUM 1300 FT.
Section Looking West on Line 1+00 East