


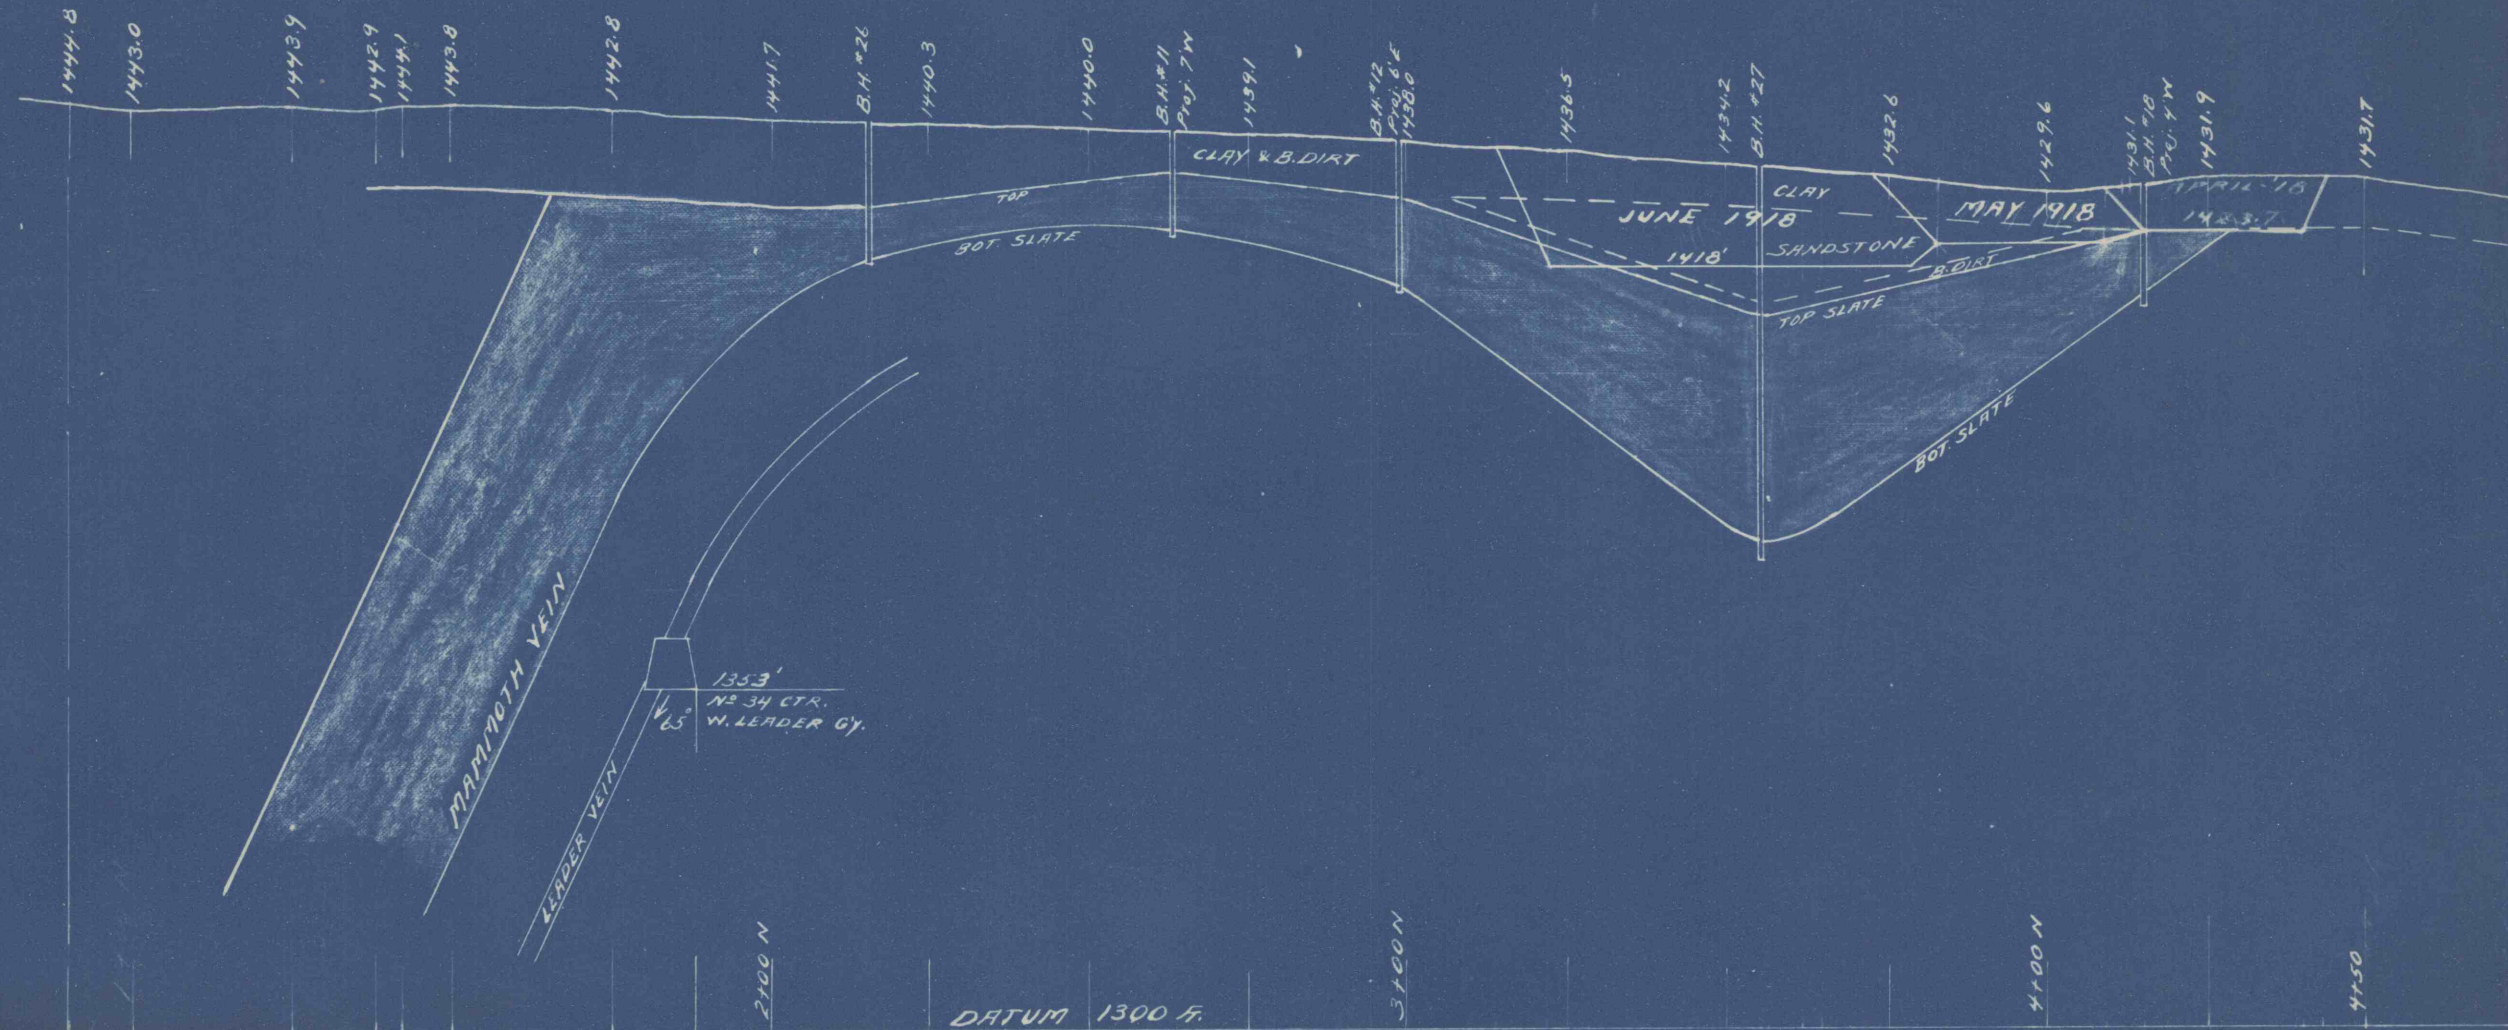

Section Looking West on Line 1+50 East