


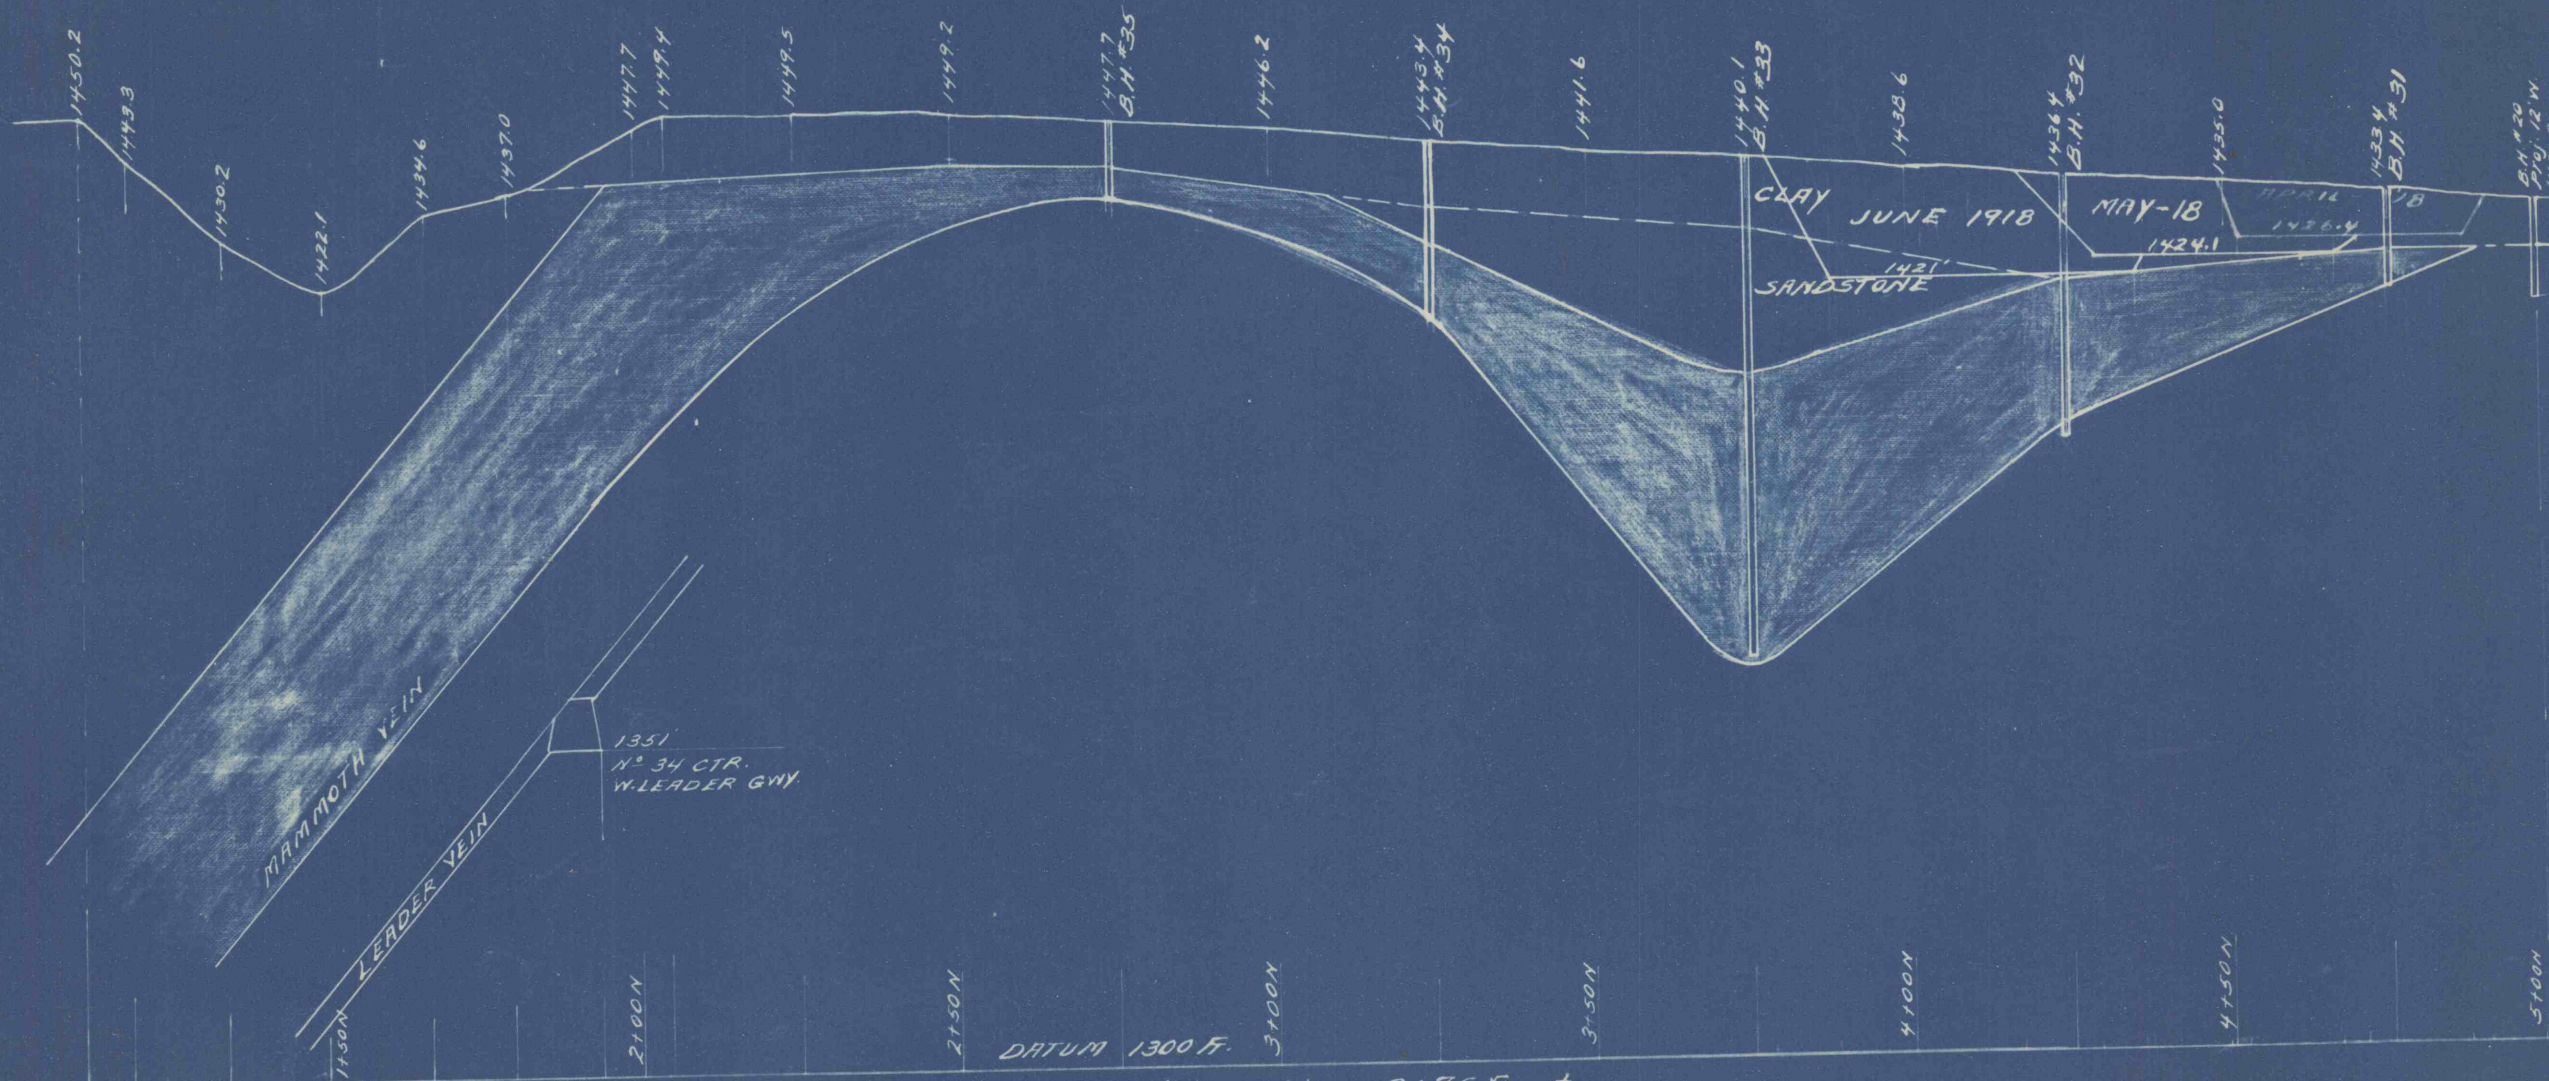

Section Looking West on Line 2175 East