


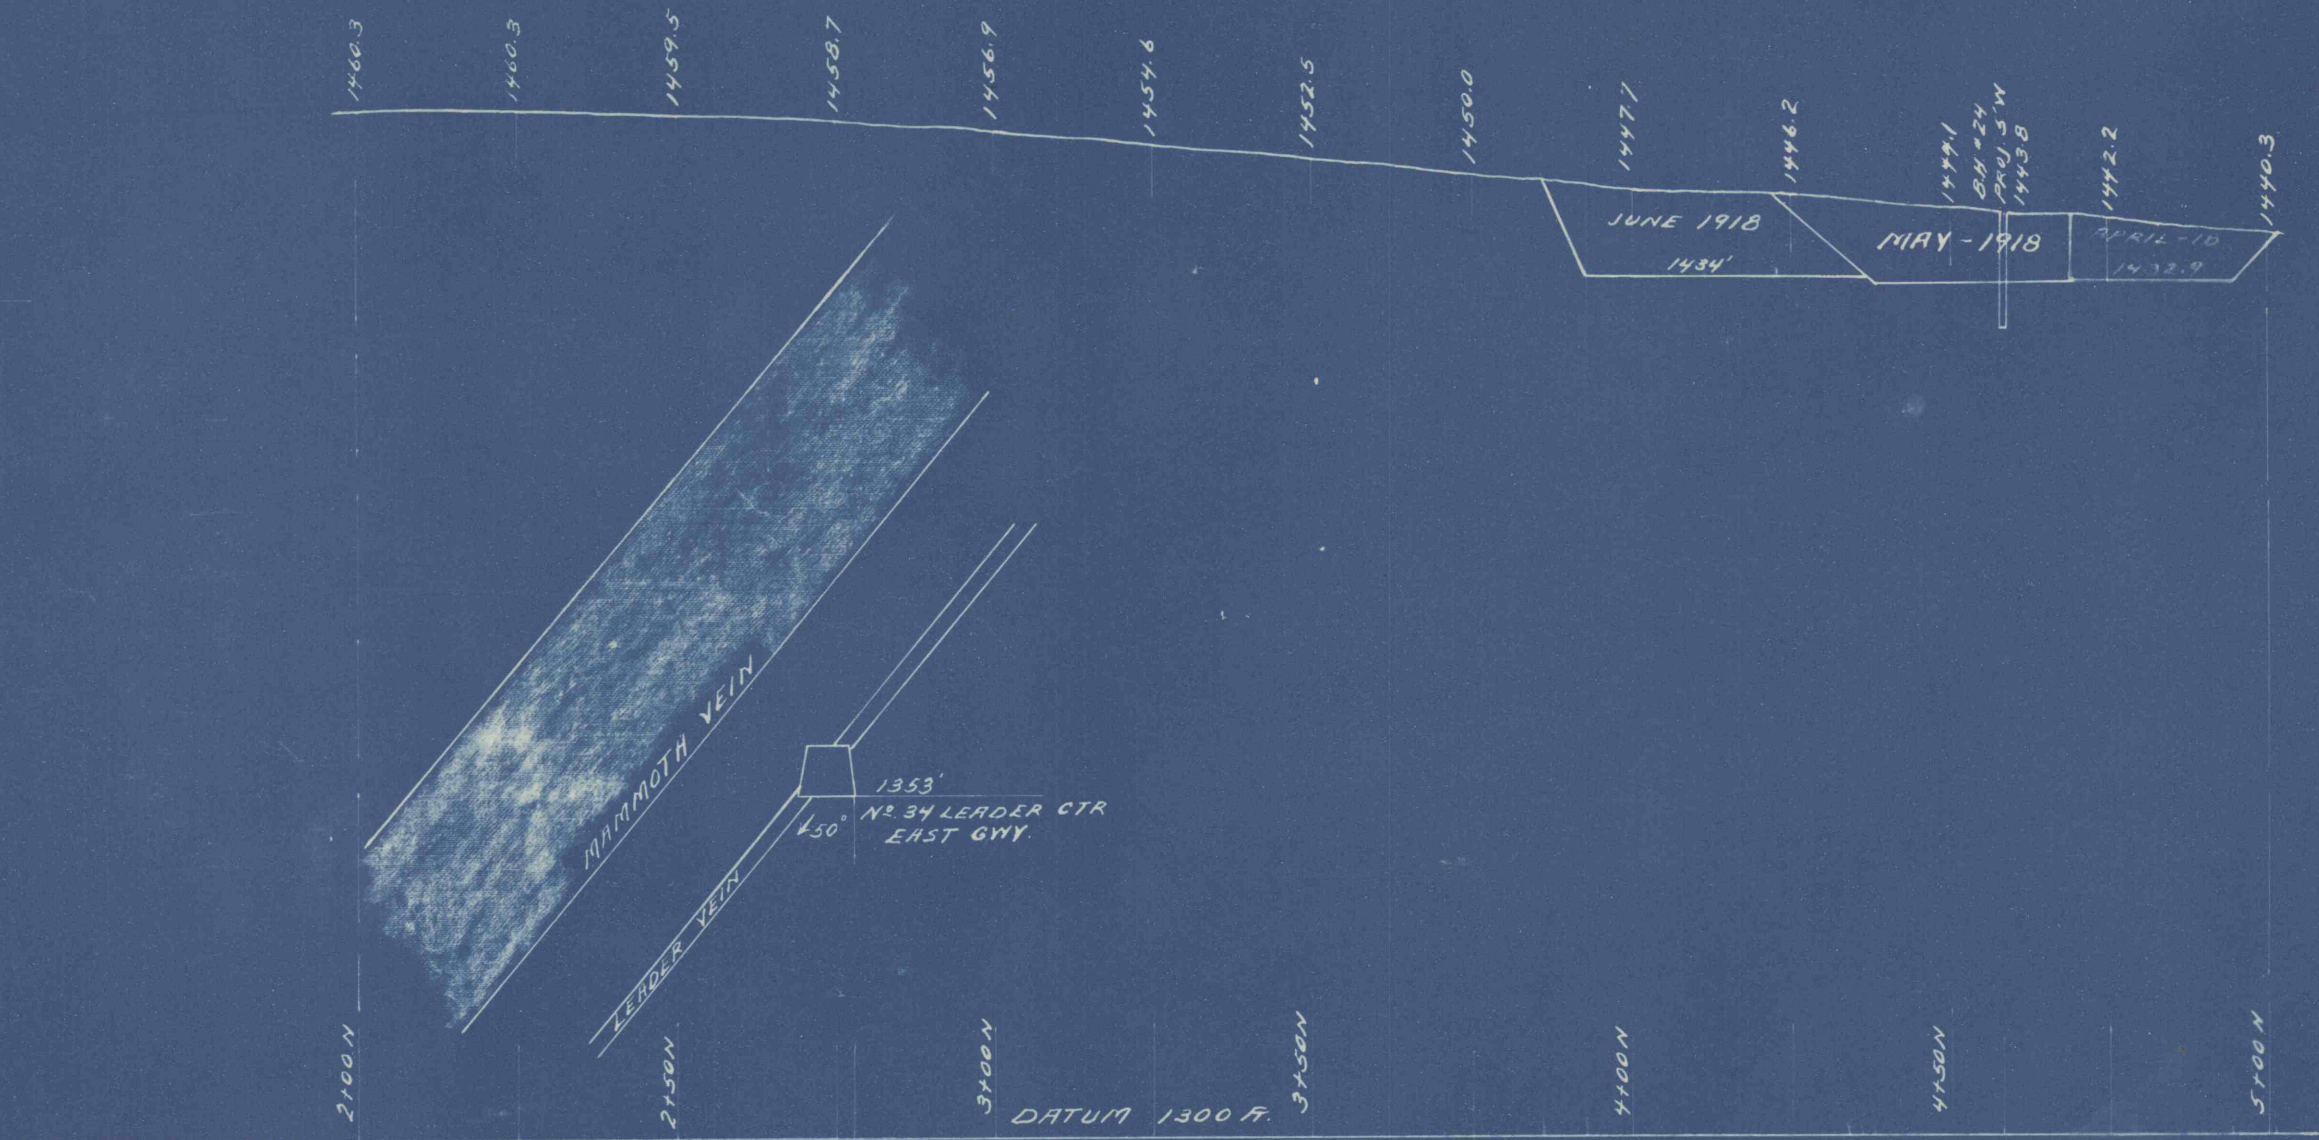

Section Looking West on Line 5+75 East