


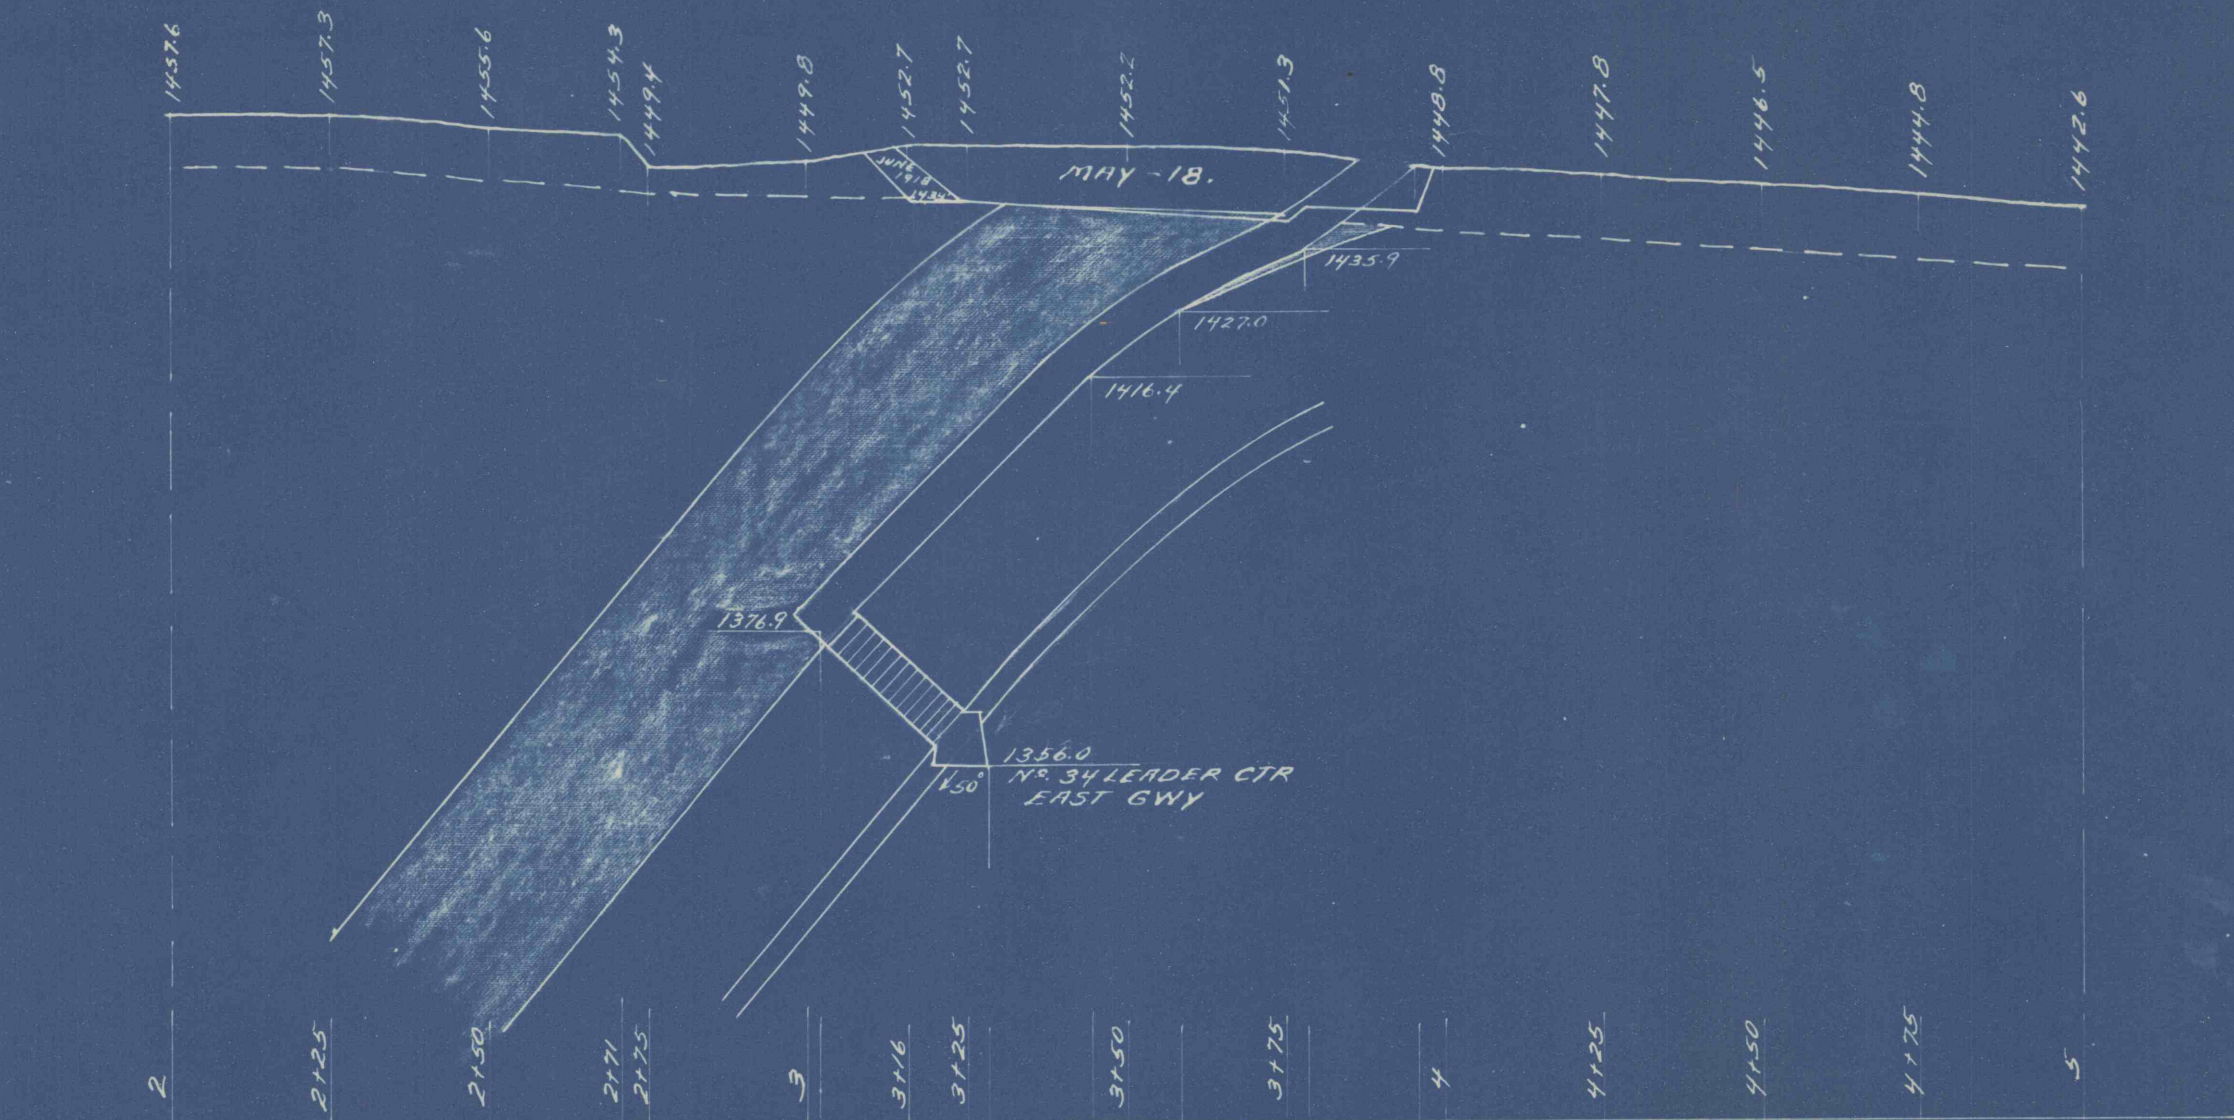

Section Looking West on Line 7+25 East