


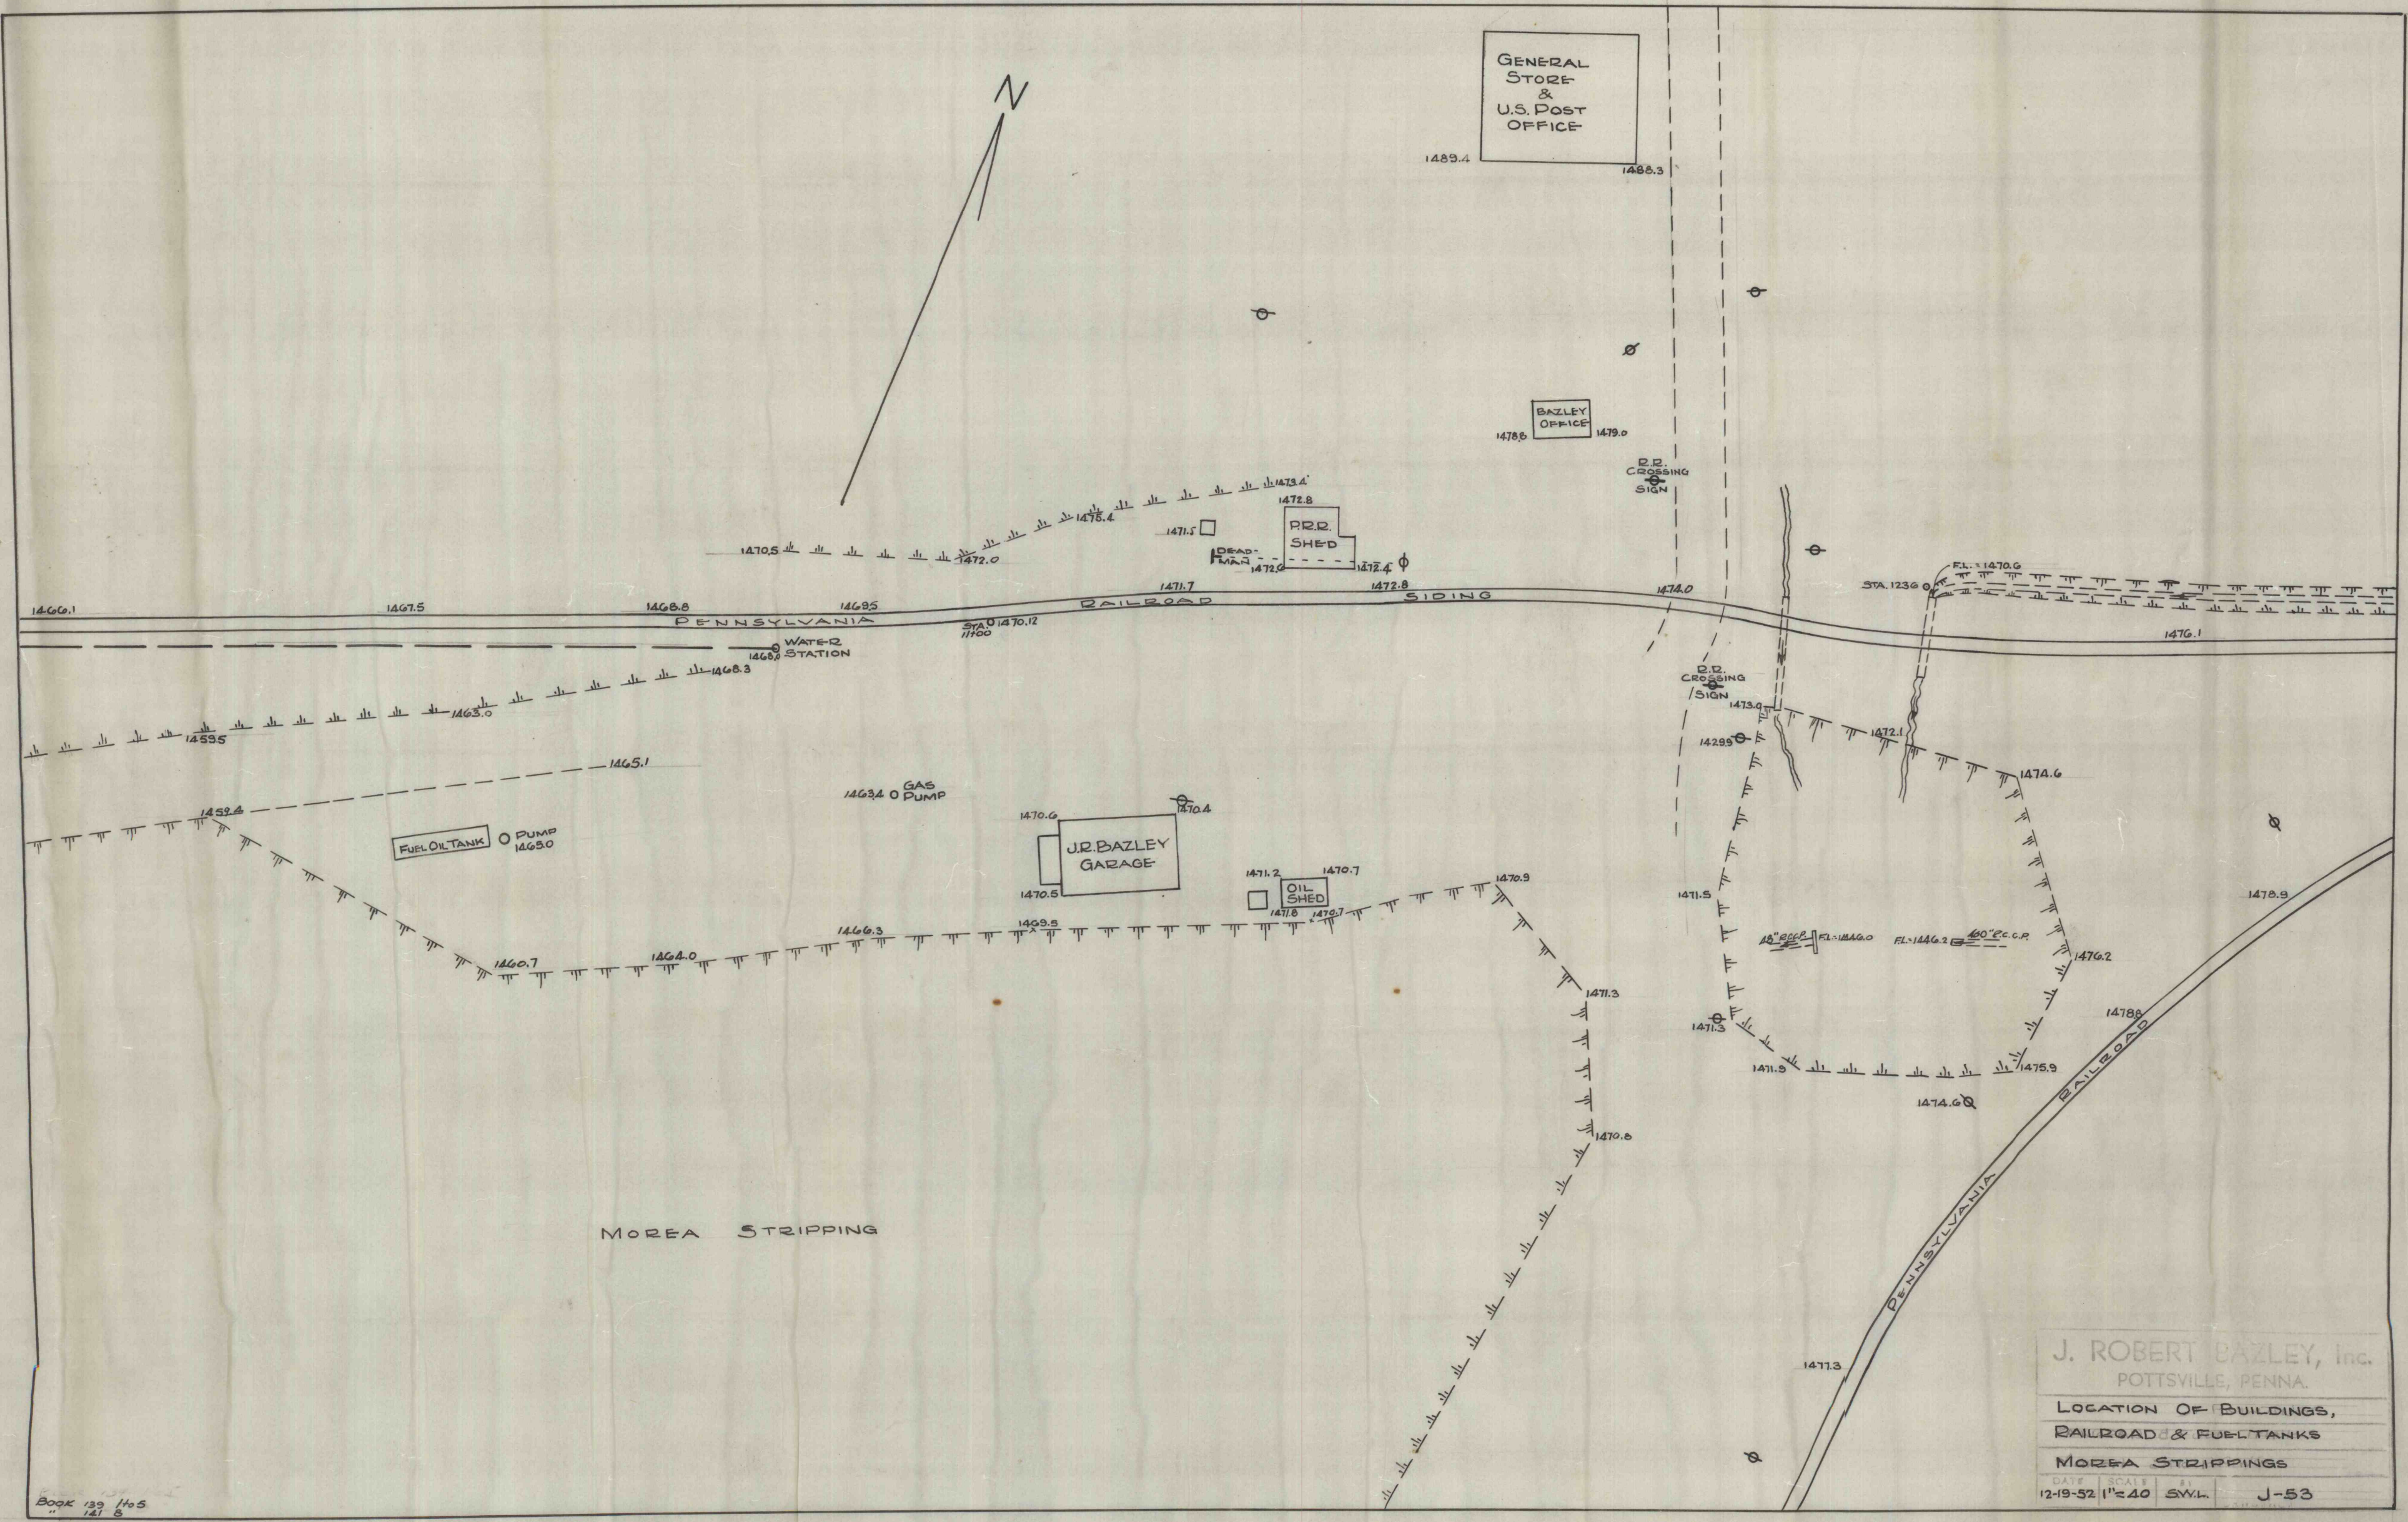

BOOK 139 1405
141 8

J. ROBERT BAZLEY, Inc.
POTTSVILLE, PENNA.

LOCATION OF BUILDINGS,
RAILROAD & FUEL TANKS
MOREA STRIPPINGS

DATE	SCALE	BY
12-19-52	1"=40'	SWL

J-53