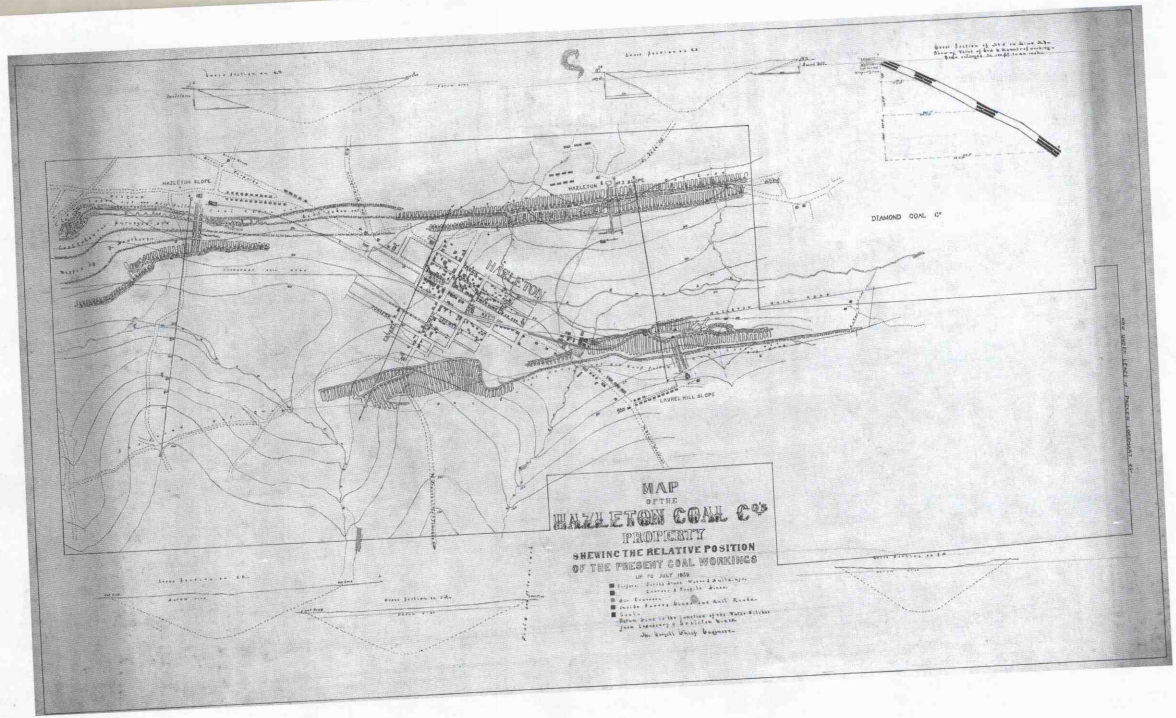

NMMR's oldest mine map: 1859 anthracite coal map from Hazleton Coal Co.