



Burned
32

377'

SCHOOL

OLD HIGHWAY
HAZLETON

STATE HIGHWAY (CONCRETE)

Fender House

#68 CAR REPAIR SHOP

#63 FAN

TOOL HOUSE

#55

TRANSFORMERS
#55
#60 COMPRESSOR
#61 ENGINE HOUSE

WAREHOUSE & DRINK WASH HOUSE

CHURCH

CARPENTER SHOP
#58
MAY 1937

SMITH SHOP (Steel)

#73
LOCO. HOUSE
(corr. brick J.M. Roof)


#62 TIPPLE
OIL PLATFORM
& PLATFORM
RAISED MAY 1937

Burned
32

BURN
#58
RAISED 7/21/37

#69 FAN HOUSE (BRICK)
180'
#65 FAN
RAISED
JAN 4/32
#57 TOOL HOUSE
NO. 2 SLOPE

#56 NO. 2 SLOPE
ENG. HOUSE
#66 TRANSFORMERS

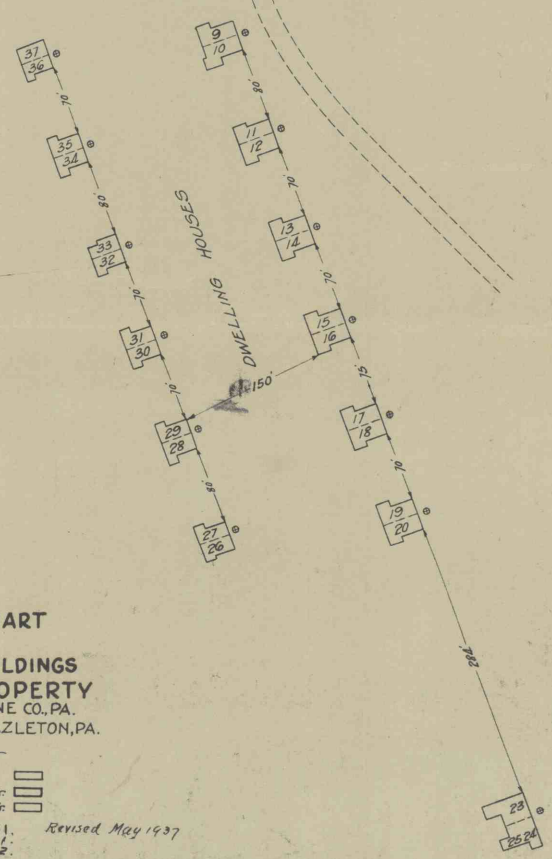

INSURANCE CHART
SHOWING
LOCATION OF BUILDINGS
HUMBOLDT PROPERTY
HAZLE TWP. LUZERNE CO., PA.
ENG. DEPT., L.V.C.O. HAZLETON, PA.
SCALE 1"=100'

~LEGEND~

FRAME BLDG.	[Outline]
BRICK OR STONE BLDG.	[Solid]
CORRUGATED IRON BLDG.	[Hatched]

REVISED JUNE 1, 1931. Revised May 1937

"	DEC.	1931.
"	MAY.	1932.
