


$$\begin{array}{r} 100 \\ 10 \\ \hline 110 \end{array}$$

$$\begin{array}{r} 126 \\ 12 \\ \hline 138 \end{array}$$

FIRST FLOOR PLAN.

1/4 in. = 1 ft. 11 in.

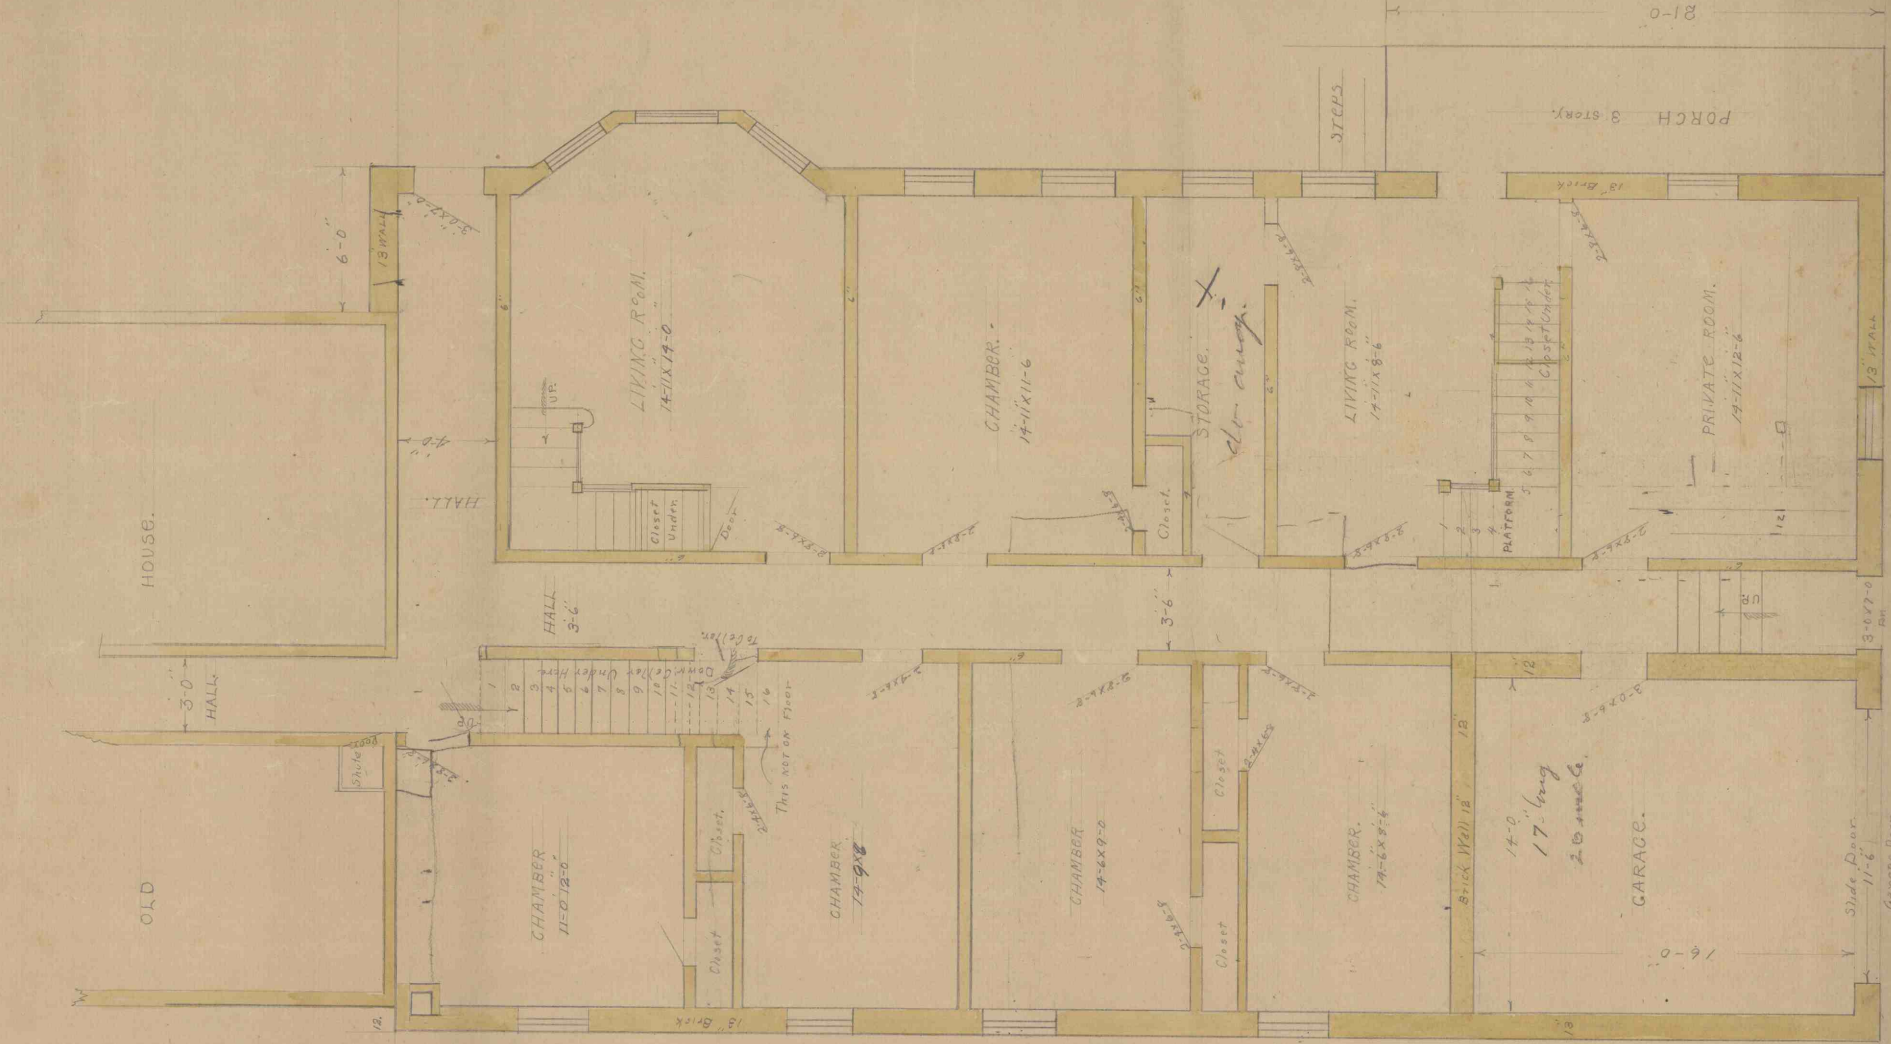

61-19