


John Kunkle

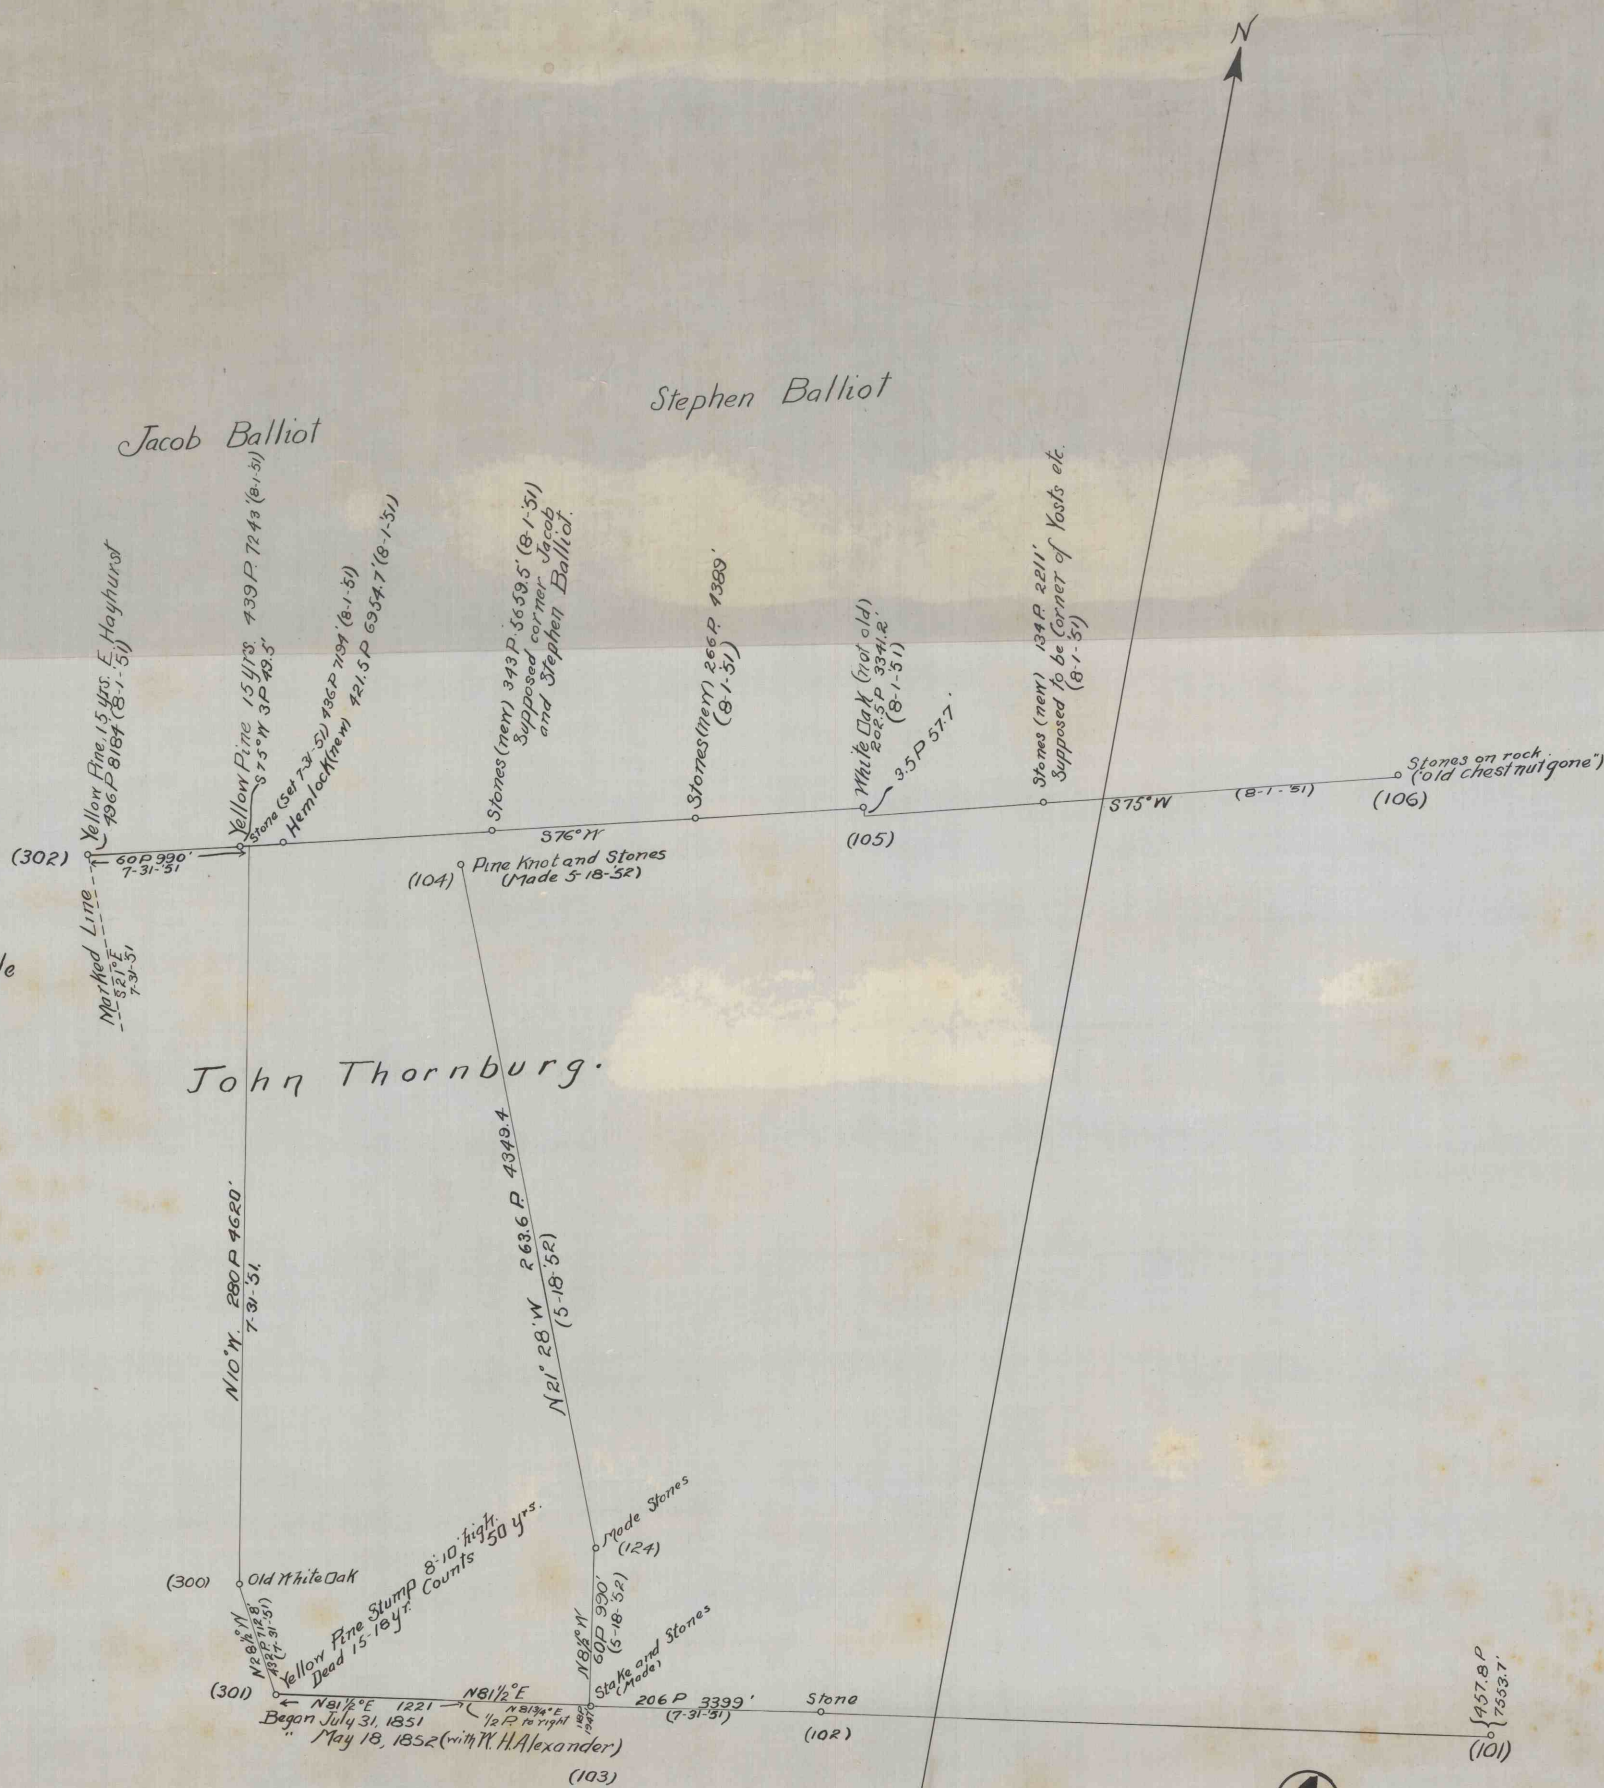

John Thornburg.

Peter Smith, Sr.

④
Plotted from Notes
of
Samuel Hoyt
July 31, and August 1, 1851.
and May 18, 1852.
Scale 1 inch = 600 feet.

Note. Figures in parentheses refer
to notes of L. E. Hartwell.

Map No. 16184
Pottsville, Penna.,
December, 1911.

James Archbald, Jr.
CONSULTING ENGINEER.