



DEED SELGRADE

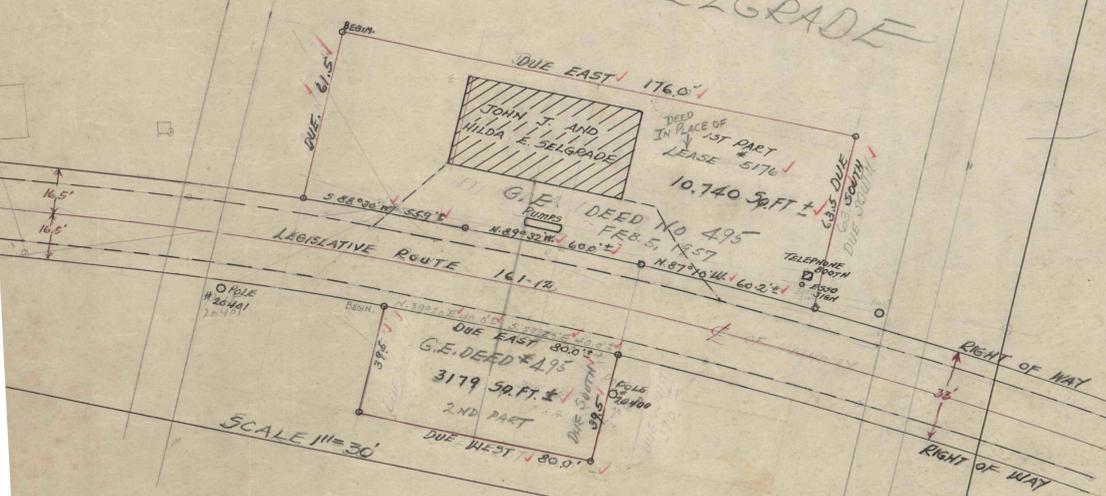

Vol. 681 P. 3
Scale 1" = 30'

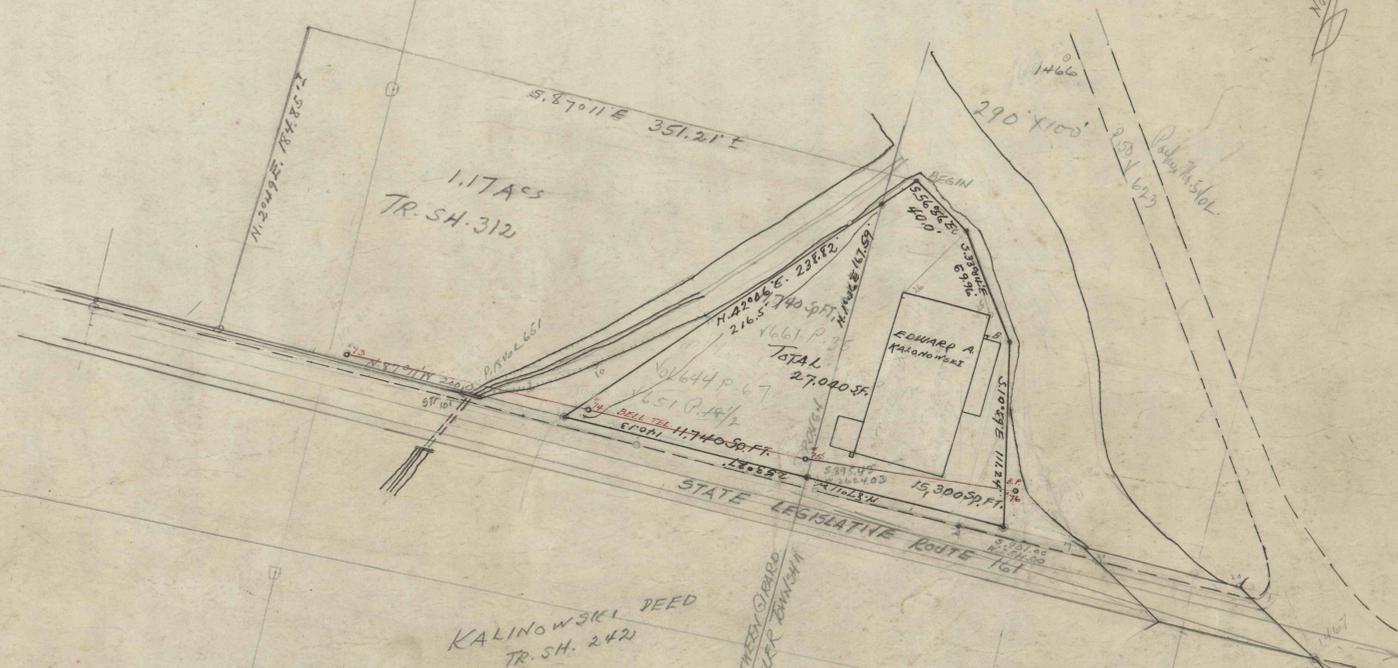

Scale 1" = 50'

TEAR LOT LEASE P. 78
 TOTAL AREA 27,040
 GR. 8000
 BUTLER TWP 15,300
 SEE VOL 681 P. 6

NORTH