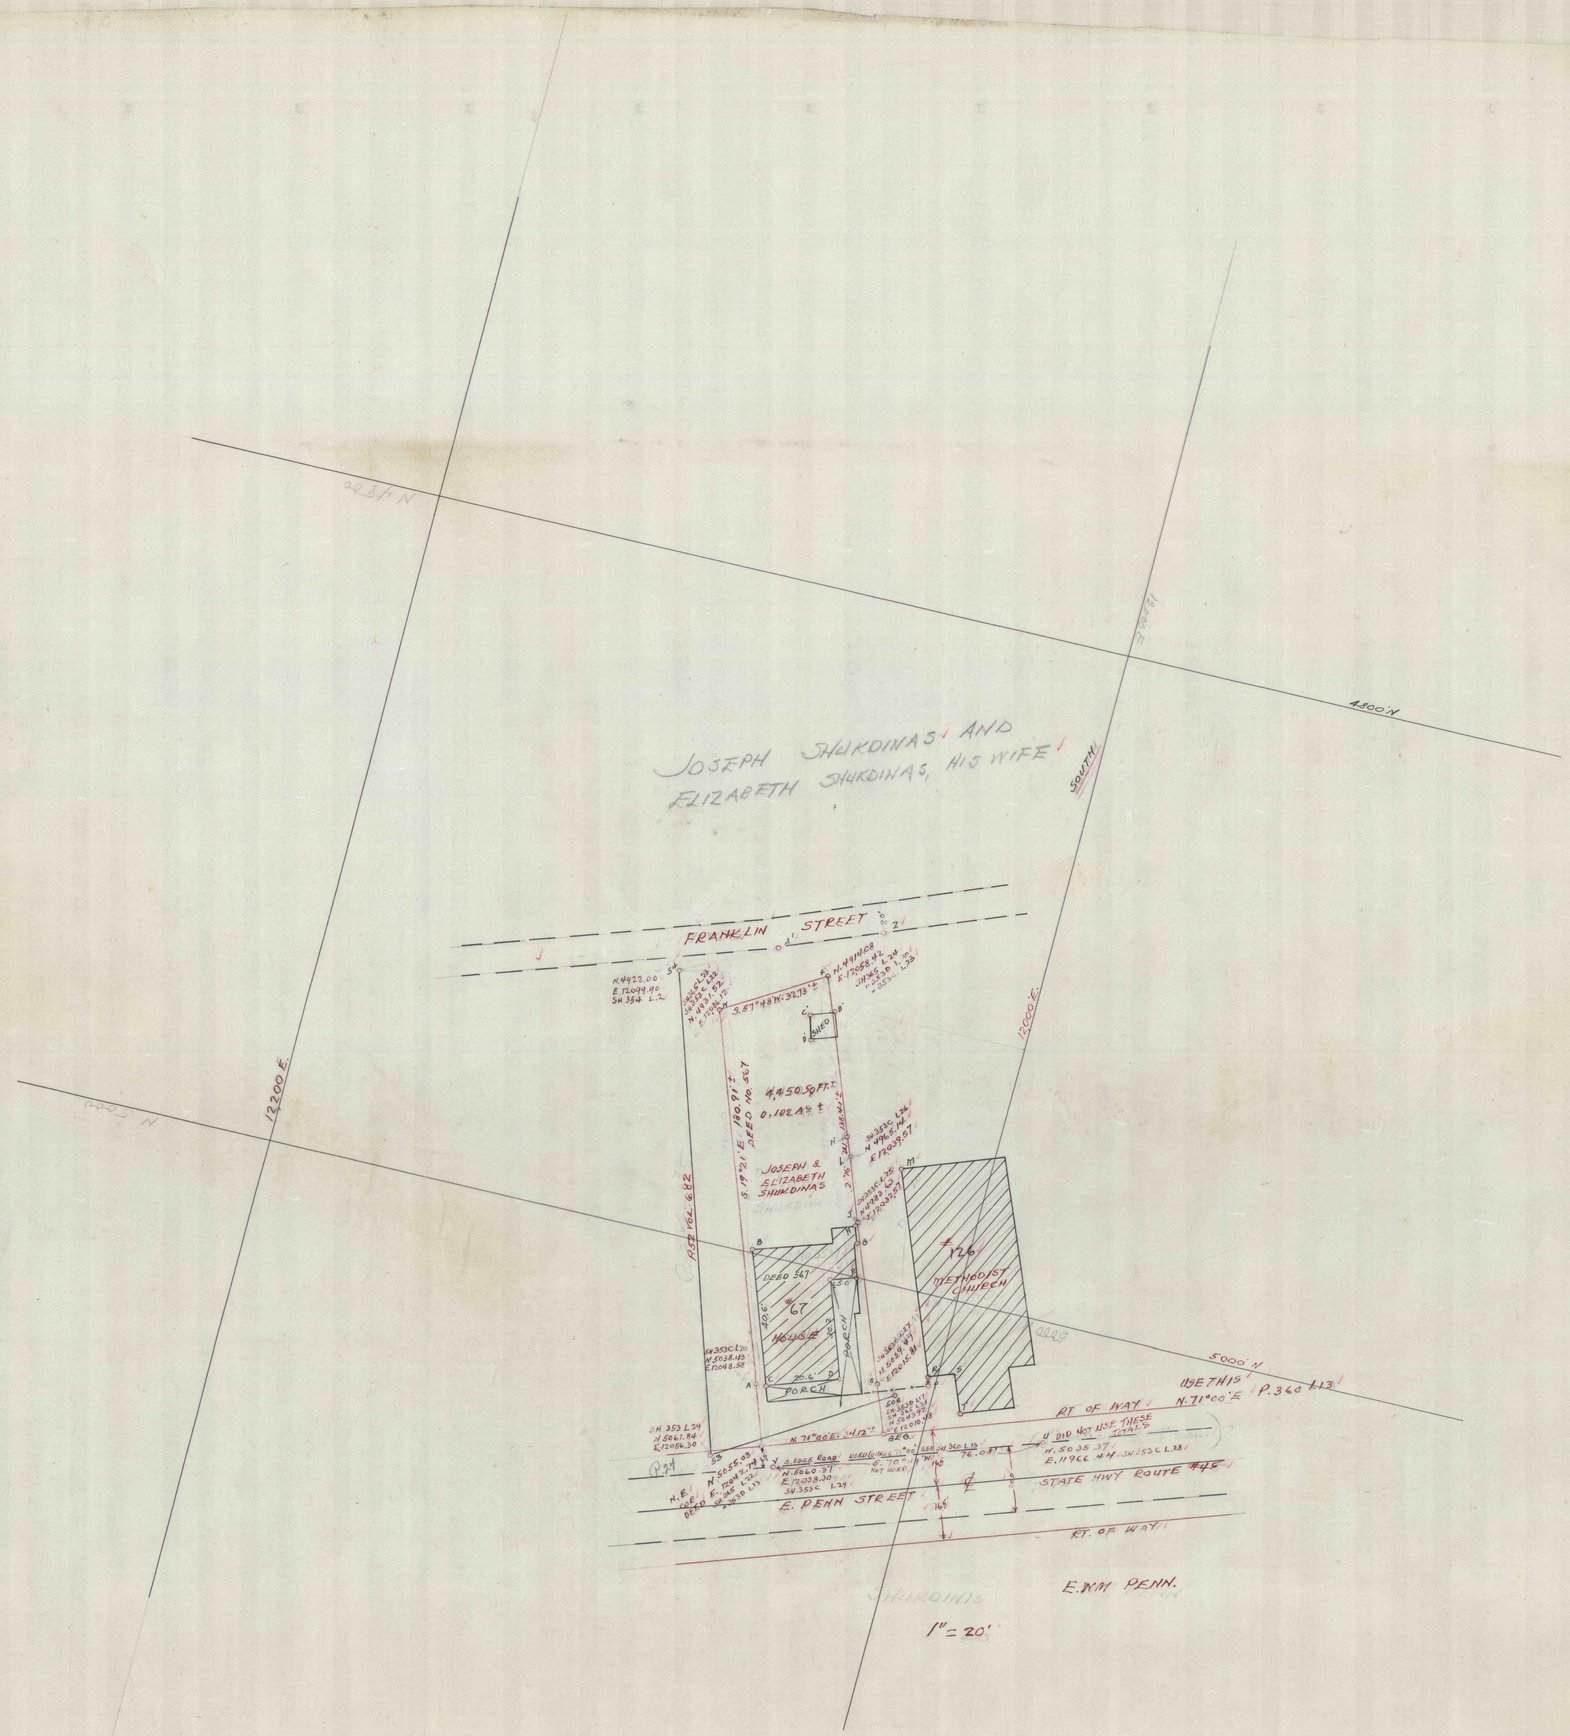

1" = 20'

SHUKOINAS - E. WM. PENN