


Section Looking West 

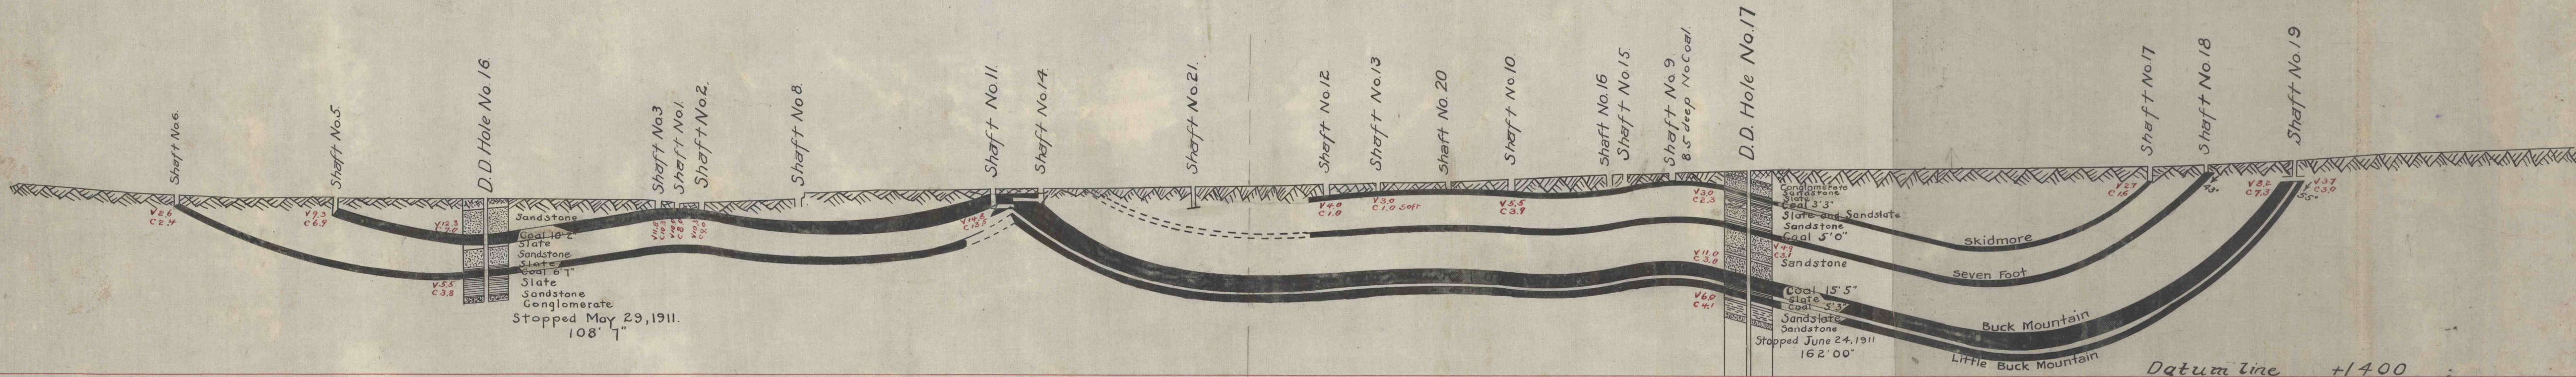

SECTION LINE L-M
Edward Lynch and Thomas P. Cope Tracts.
scale 1 inch = 100 feet.