


North

Course of

Scale 1 inch = 50 ft. Horiz.
50 ft. Vert.

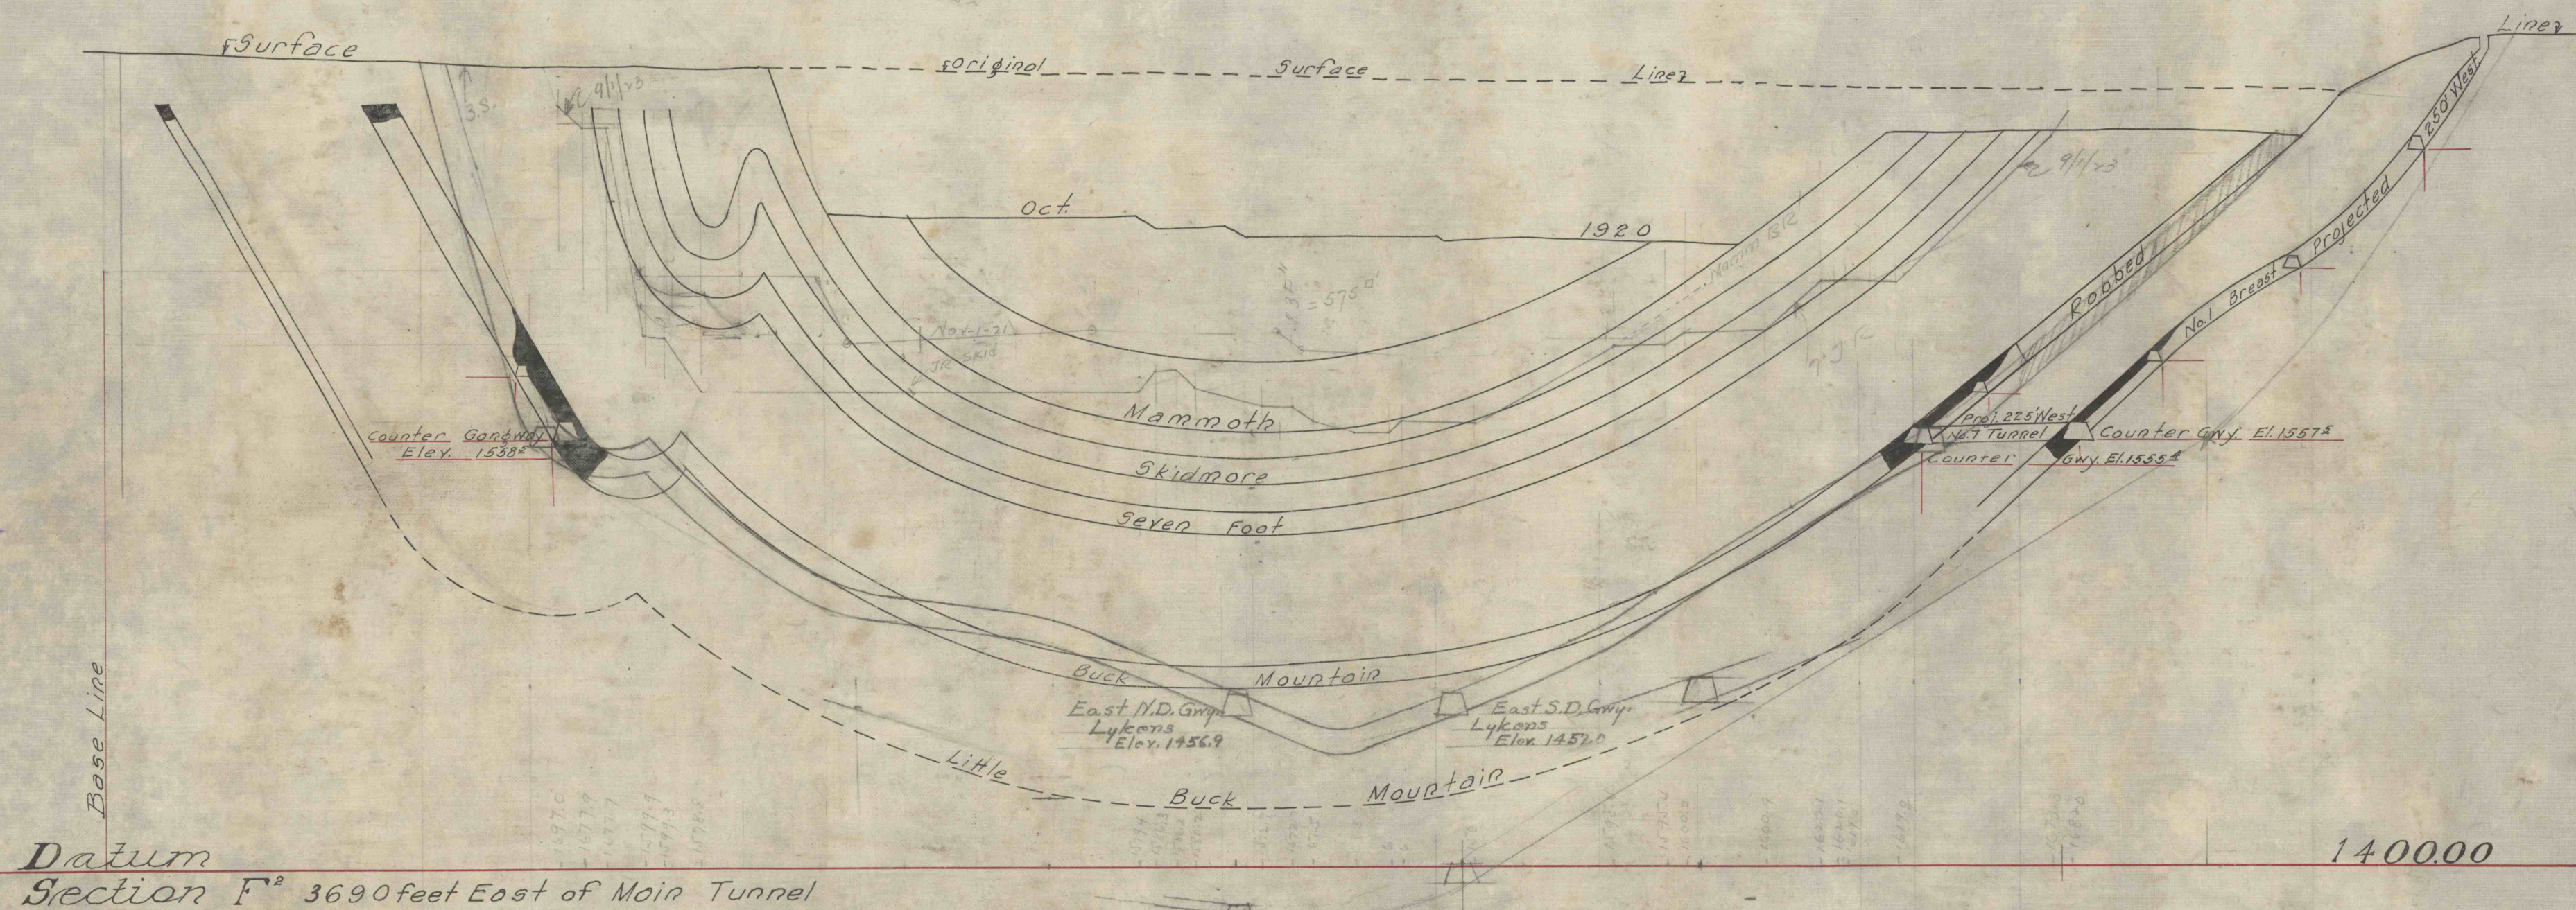

SECTION F^2