Scale 1"=50'
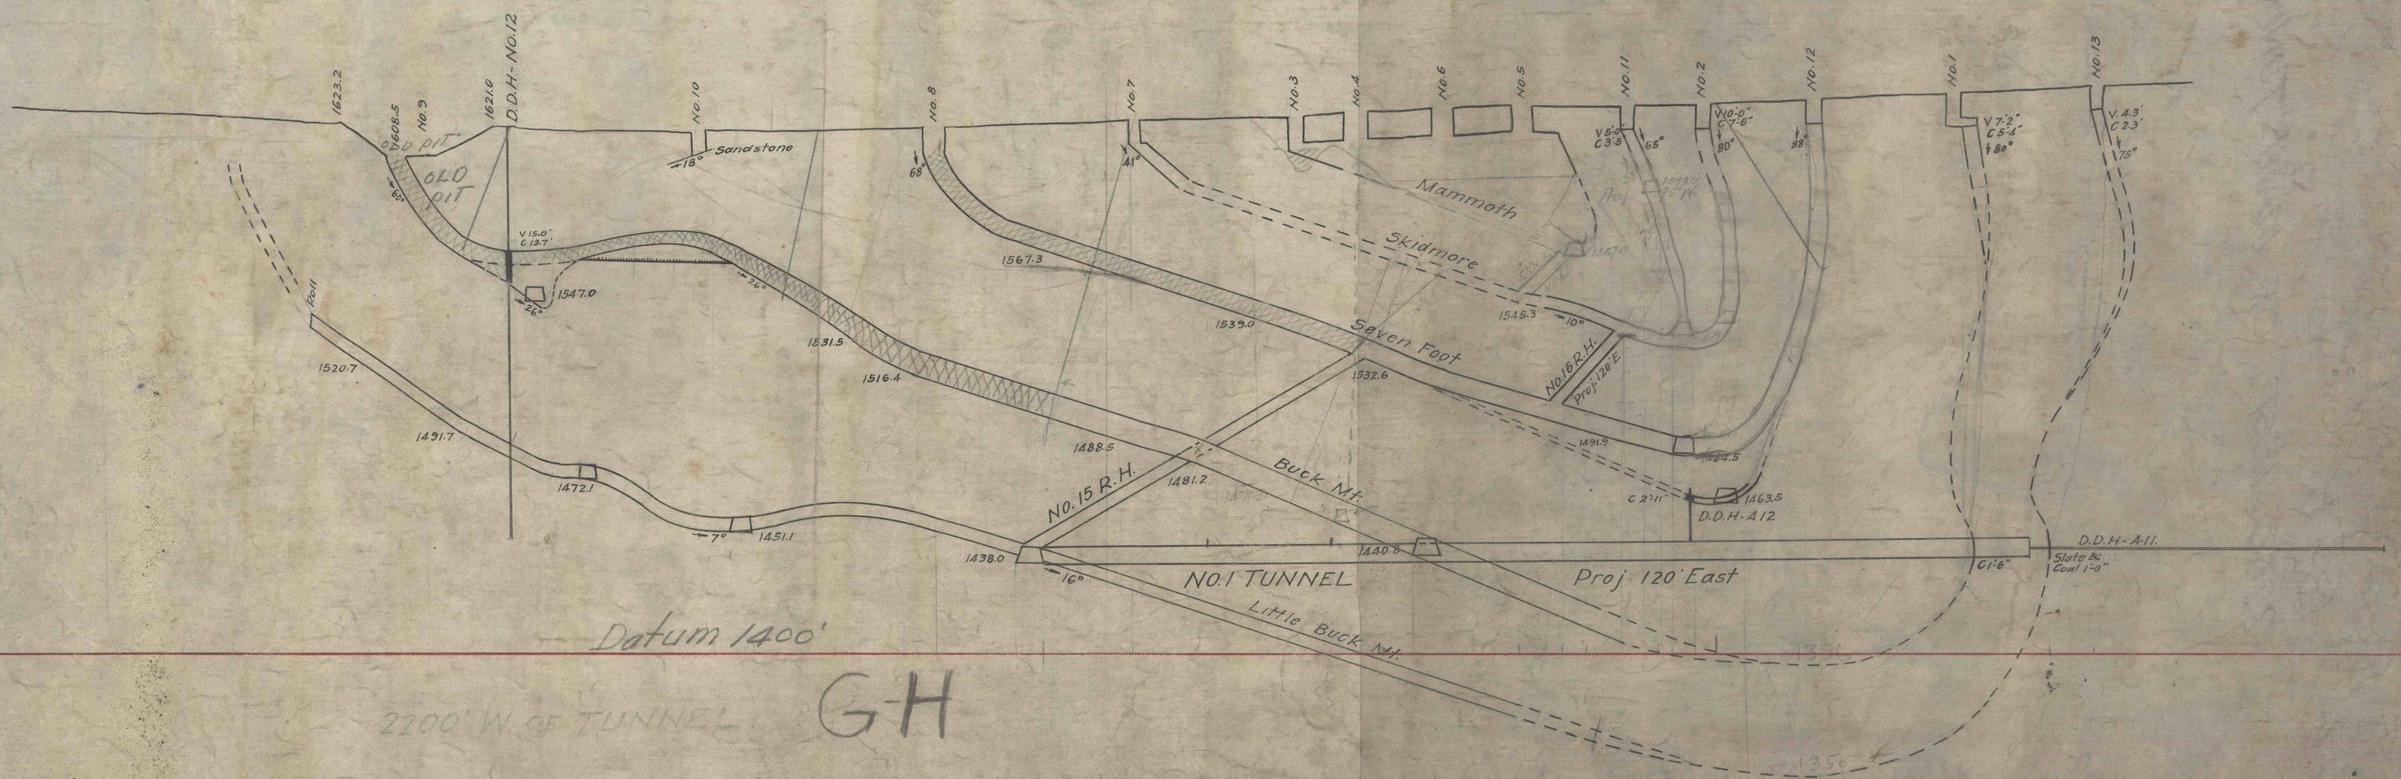
NORTH