


NEW SECTION

North

Scale 1 inch = 50 ft. Horiz
50 ft. Vert.

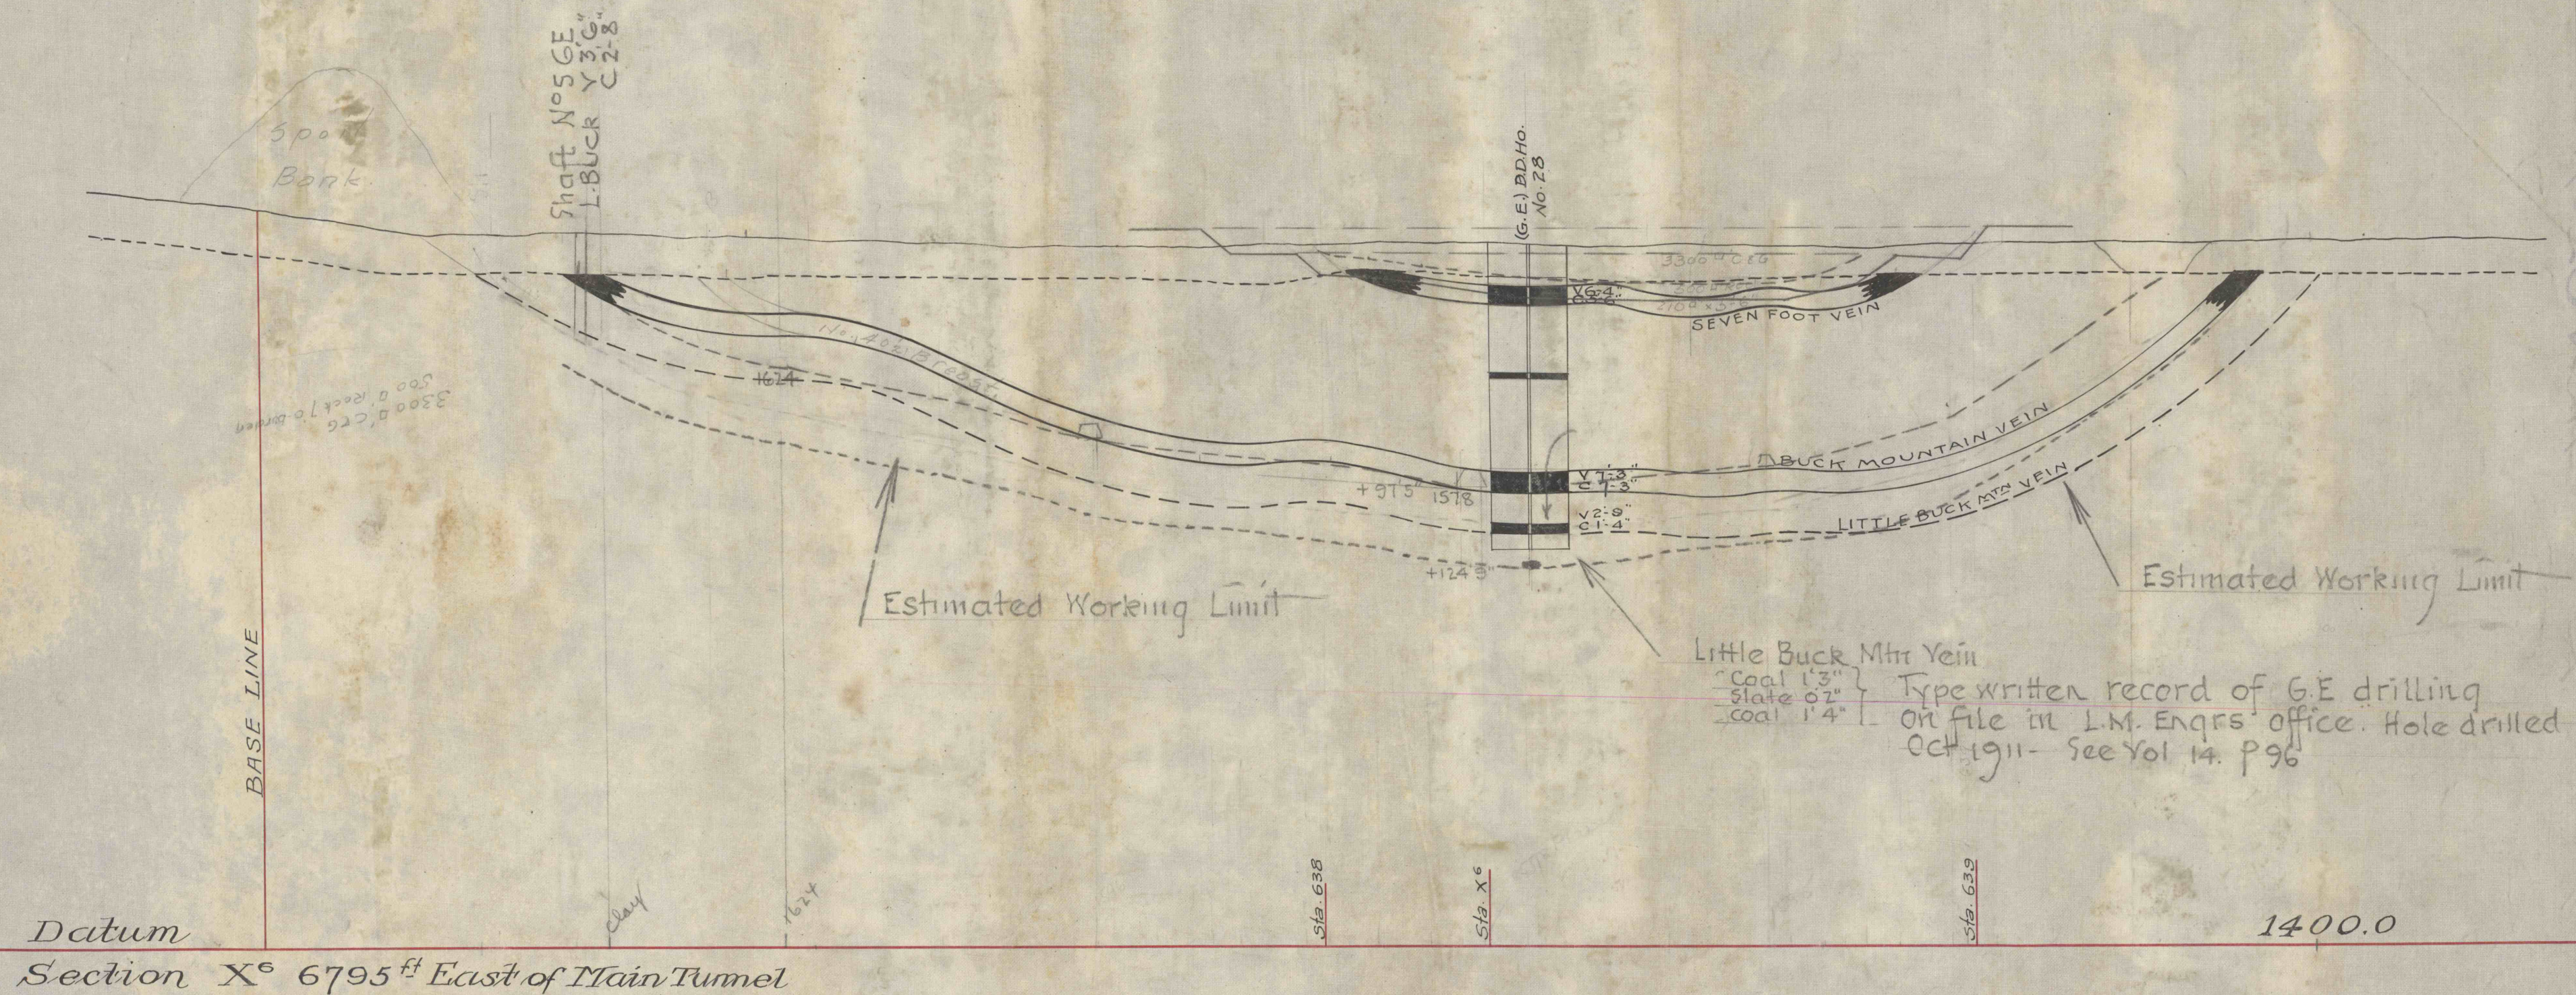

SECTION X⁶