


North
course of section 158°00'

Scale 1 inch = 50 ft. Horiz.
50 ft. Vert.

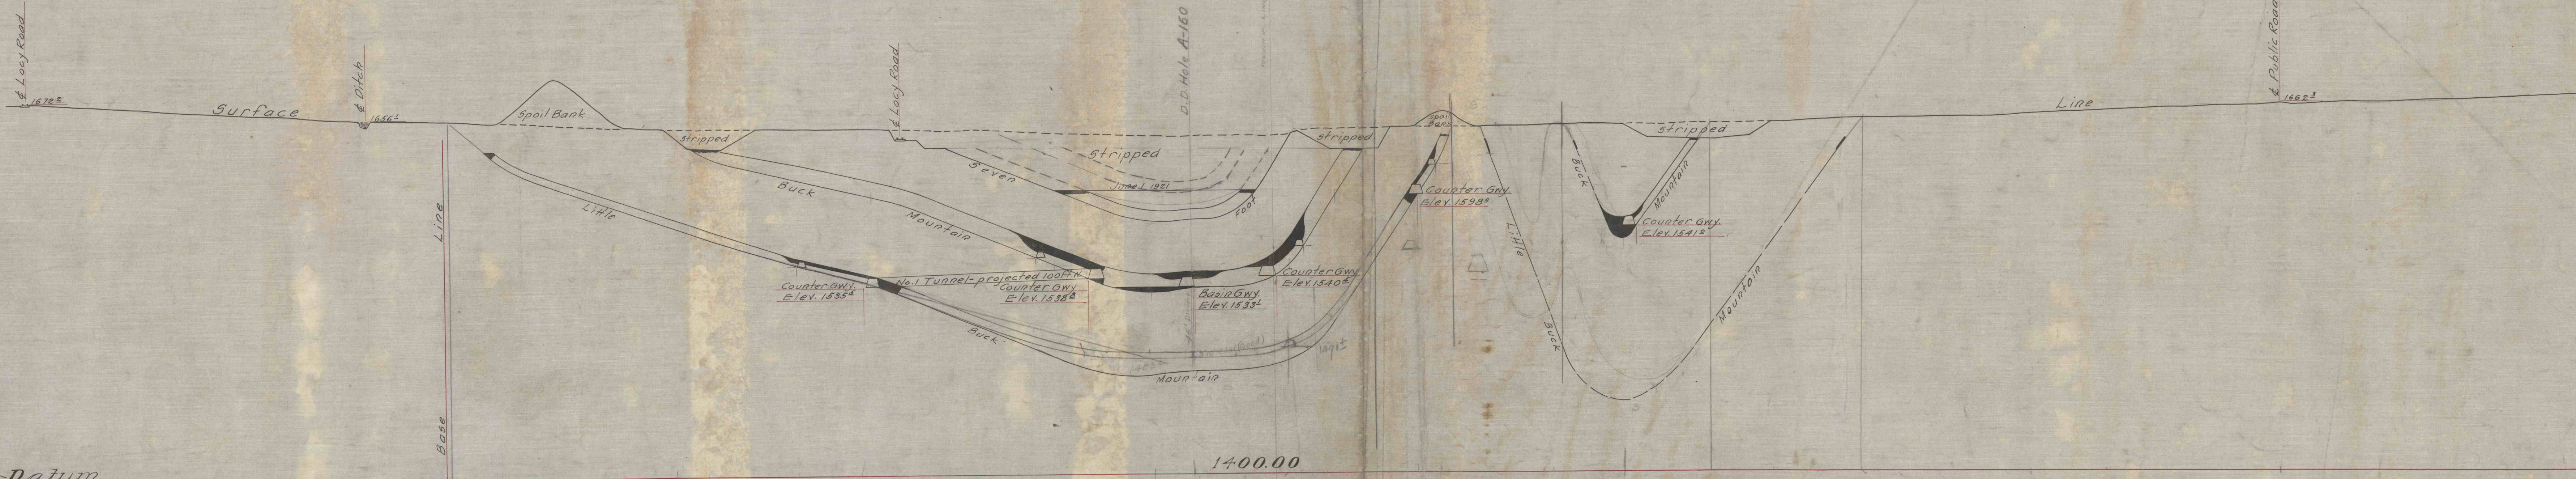

SECTION J¹⁰