


$$\begin{array}{r} + 380 = 1437 \\ + 495 = 1440 \\ + 805 = 1562 \end{array}$$

Scale 1 inch = 50 ft. Horiz.  
50 ft. Vert.

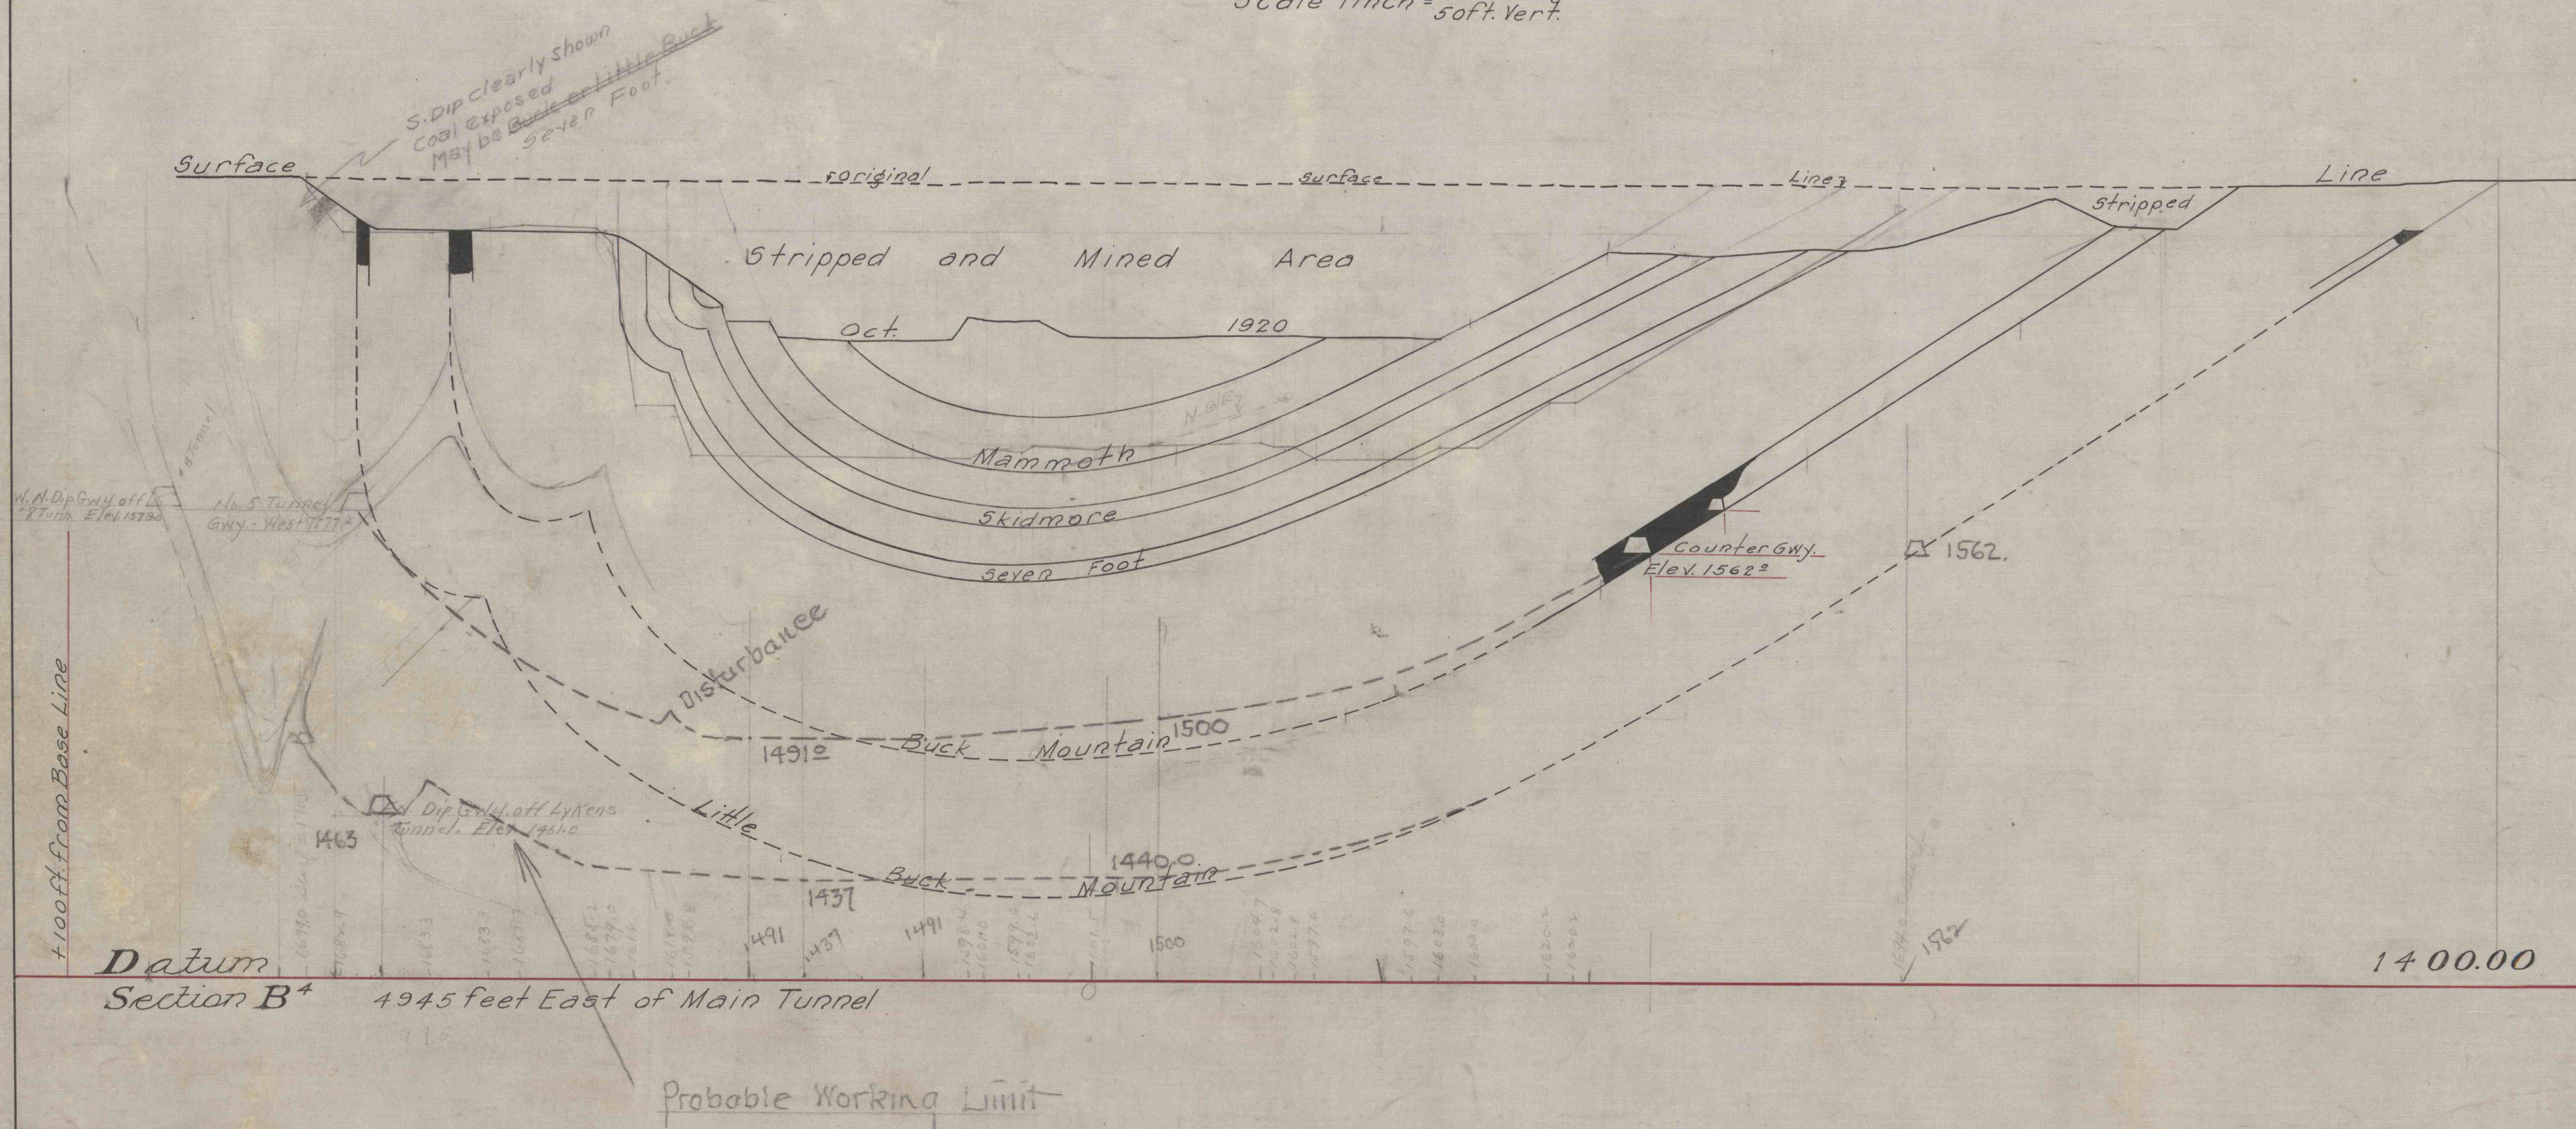

## SECTION B<sup>4</sup>