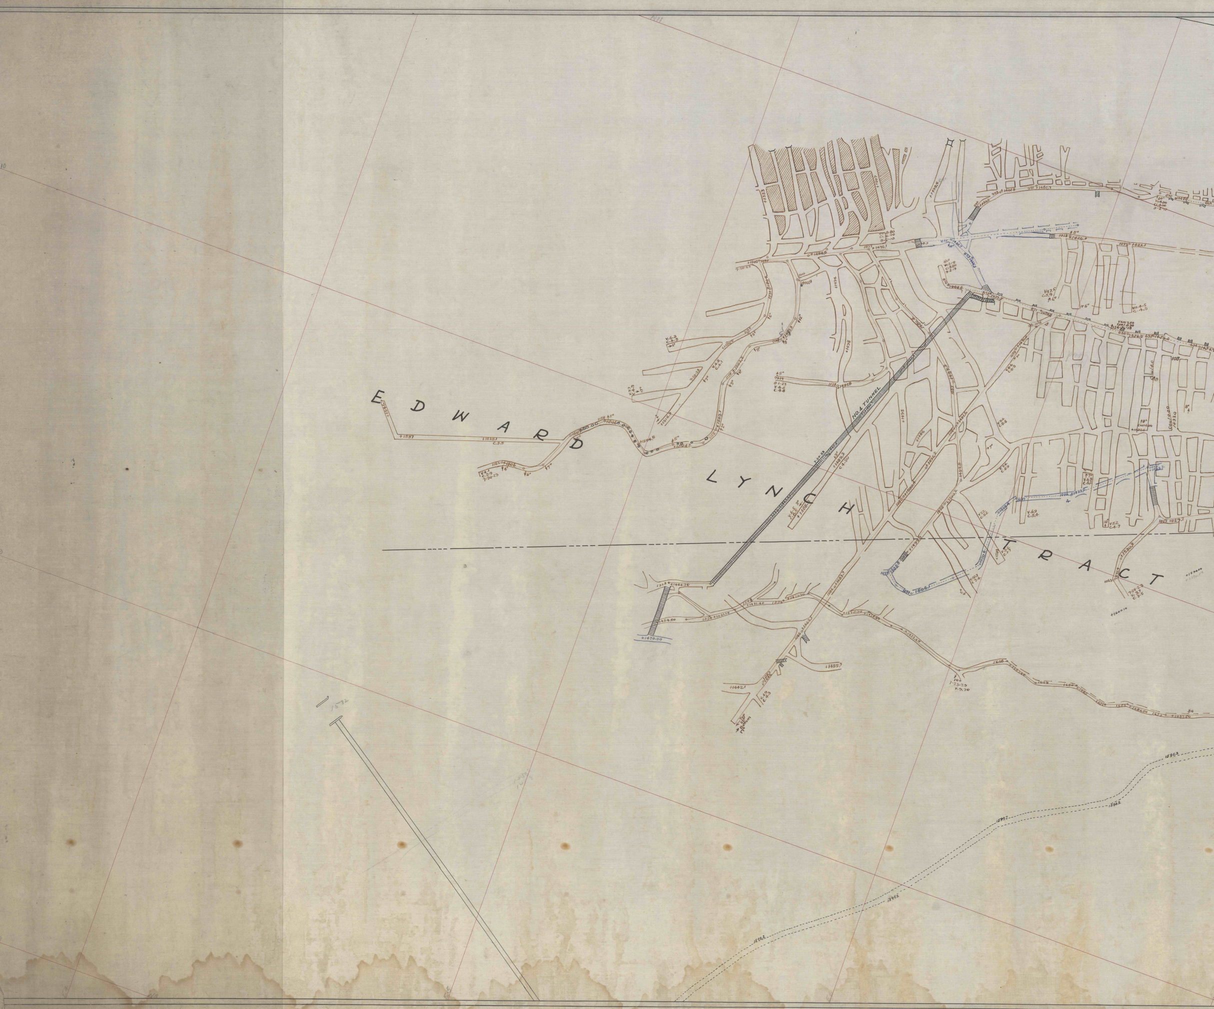
EDWARD LYNCH TRACT
No. 4 TUNNEL

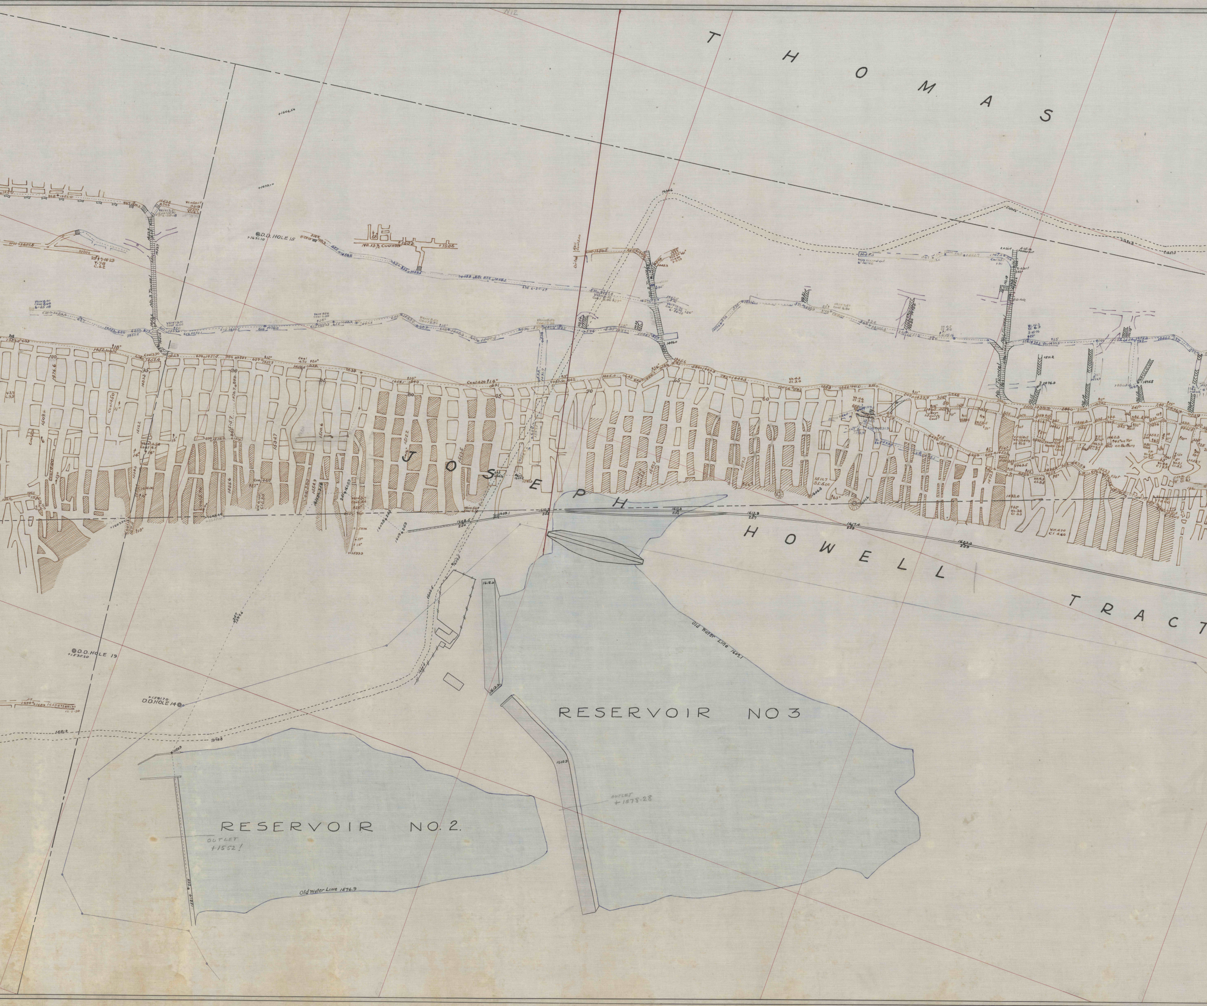N12
THOMAS
JOSEPH HOWELL TRACT
D.D. HOLE 15
+1631.10
+1635.10
No. 13½ Counter
+1502
+1506
D.D. HOLE 19
D.D. HOLE 14
RESERVOIR NO 3
RESERVOIR NO. 2.
Old Water Line 1609.1
Old Water Line 1576.9
OUTLET
+1552!
OUTLET
+1578.28

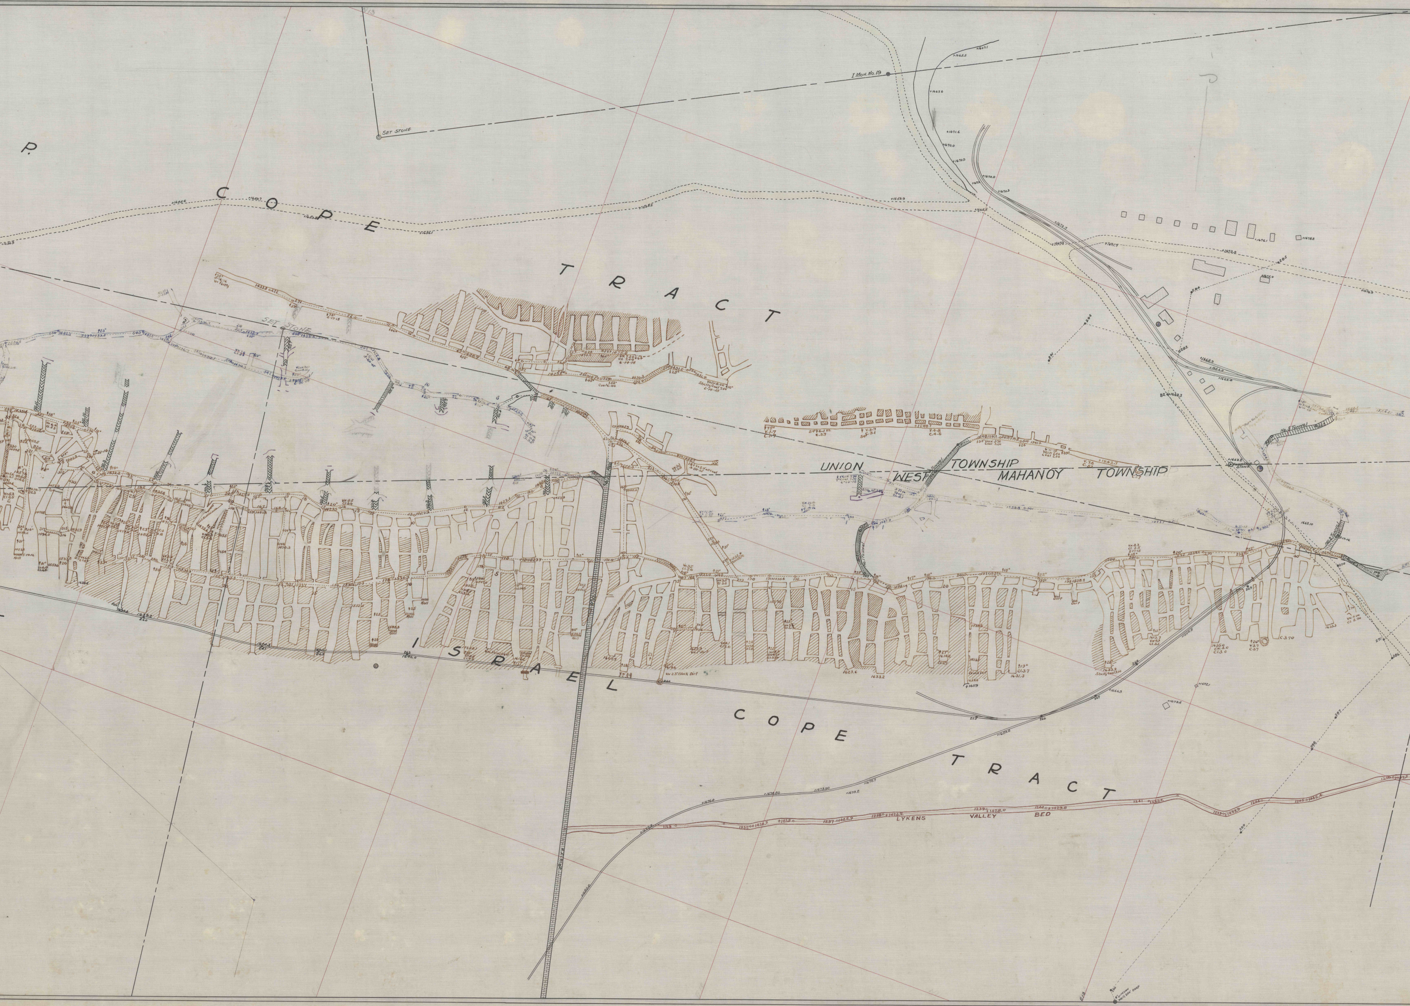
P.
COPE TRACT
SET STONE
I MON. No. 19
SET STONE
UNION TOWNSHIP
WEST MAHANOY TOWNSHIP
ISRAEL COPE TRACT
LYKENS VALLEY BED

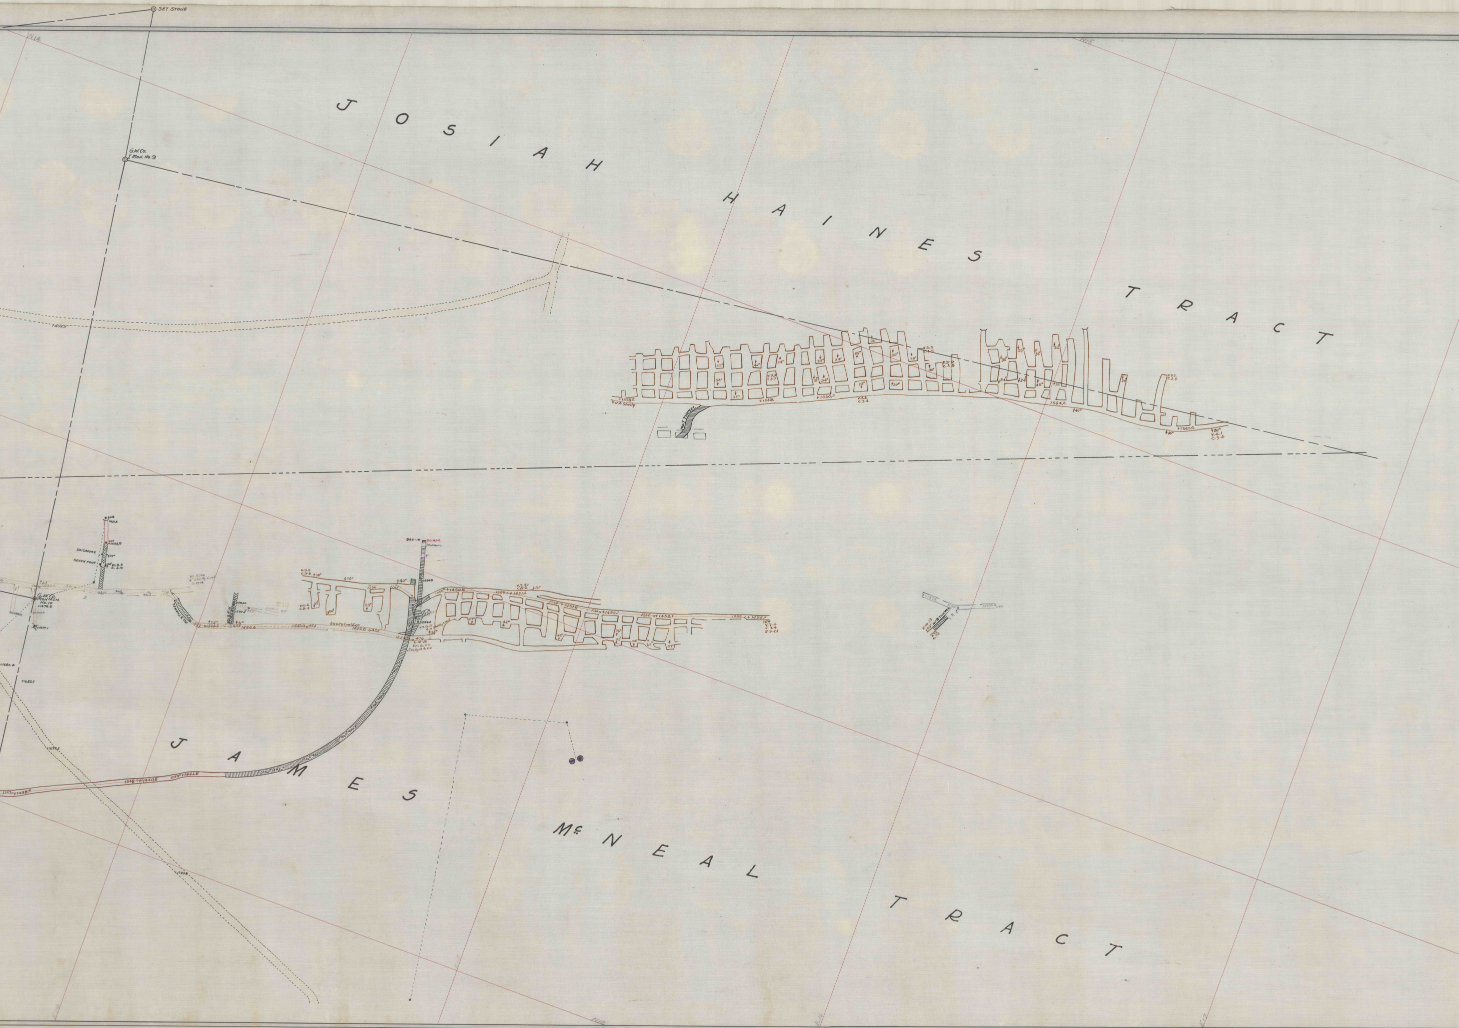
SET STONE
G.W.Co. I. Mon. No. 9
JOSIAH HAINES TRACT
No. 7 TUNNEL
+1558.2
V. 0.6 Shelly
+1558.
SKIDMORE
SEVEN FOOT
Vn. 8.3
C. 4.9
G.W.Co. IRON MON. No. 10 +1676.6
+1677.1
+1680.4
+1683.7
Wr. Rolly
6" Shelly Coal
5-17-16
No. 3 TUNNEL
Shelly Coal 5.00
826-19
Skidmore
Vn. 6.00
Shelly @ 4.00
No. 8 TUNNEL
9-26-23
V. 7.5
C. 7.5
+1575
1593.6
JAMES McNEAL TRACT