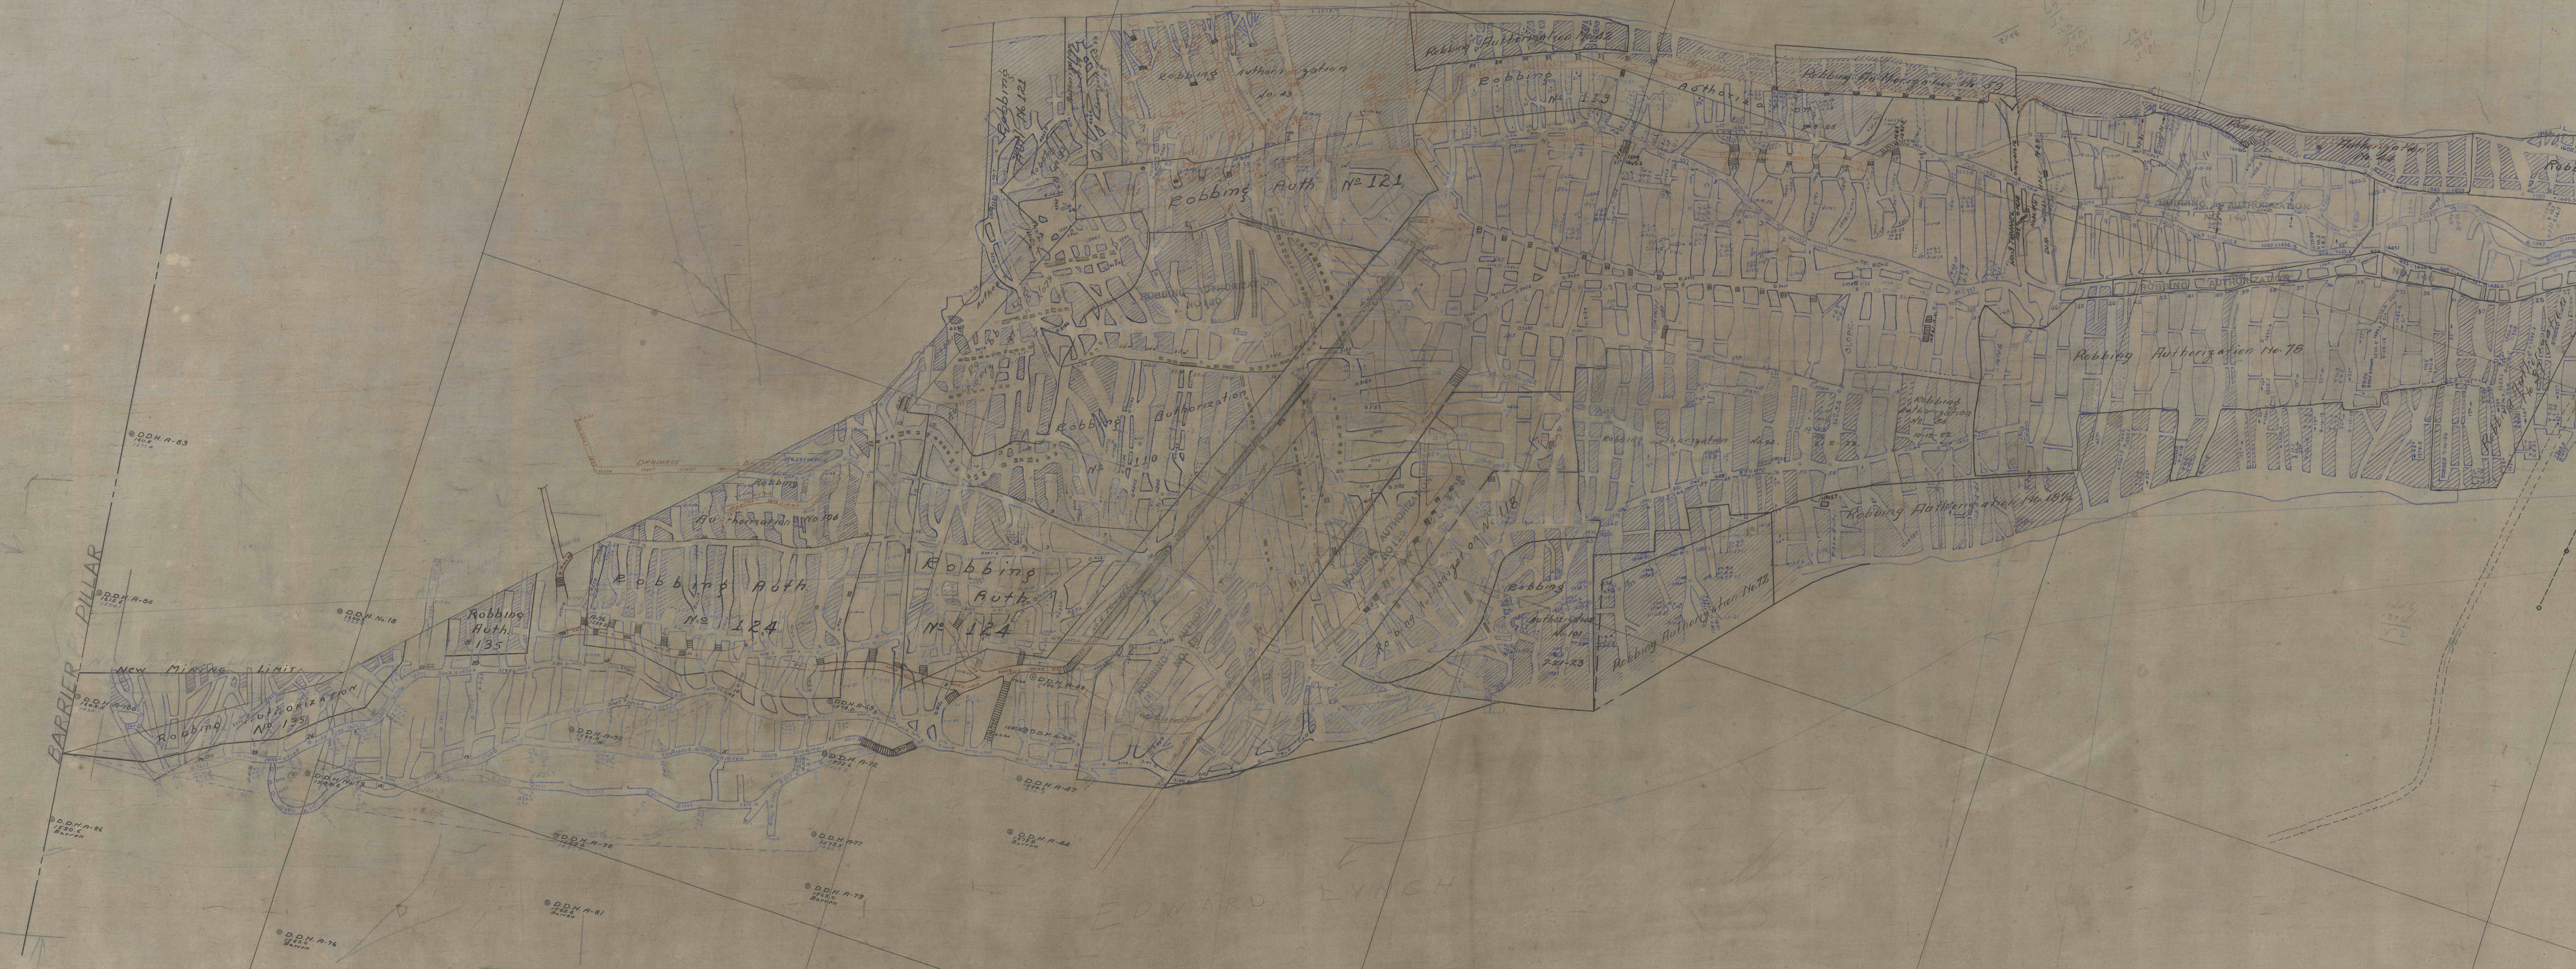
BARRIER PILLAR
New Mining Limit
Robbing Authorization No. 135
Robbing Auth. #135
Robbing Auth. No 124
Robbing Auth. No 124
Robbing Authorization No 106
DRAINAGE
Robbing Authorization No 110
Robbing Auth No 121
Robbing Auth No. 121
Robbing Authorization No. 43
Robbing Authorization No. 42
Robbing Authorization No 113
Robbing Authorization No. 53
Robbing Authorization No. 44
Robbing Authorization No. 148
Robbing Authorization No. 146
Robbing Authorization No. 120
Robbing Authorization No. 78
Robbing Authorization No. 92
Robbing Authorization No. 81 10-12-27
Robbing Authorization No. 118
Robbing Authorization No. 101 7-21-23
Robbing Authorization No. 72
Robbing Authorization No. 181
SLOPE
D.D.H. A-83 1611.5
D.D.H. A-84 1612.6
D.D.H. No. 18 1600.7
D.D.H. A-100 1609.5
D.D.H. No. 19 1588.8
D.D.H. A-86 1590.6 Barren
D.D.H. A-73 1580.3
D.D.H. A-69.5 1578.0
D.D.H. A-72 1572.6
D.D.H. A-78 1588.4
D.D.H. A-77 1573.5
D.D.H. A-76 1583.0 Barren
D.D.H. A-81 1562.8 Barren
D.D.H. A-79 1569.0 Barren
D.D.H. A-49
D.D.H. A-45
D.D.H. A-47 1594.3
D.D.H. A-44 1579.9 Barren
J
L