


TO ACCOMPANY REPORT R.R. PART II.

PLATE No. XII.

SECOND GEOLOGICAL SURVEY OF PENNSYLVANIA.
J. P. LESLEY, STATE GEOLOGIST.
Chas. A. Ashburner, Assistant Geologist.

MAP OF
THE DAGUS MINES
OF THE
NORTH WESTERN MINING AND EXCHANGE COMPANY
IN
FOX TOWNSHIP, ELK COUNTY
SHOWING
EXTENT OF MINING UP TO SEPTEMBER 1884
AND THE
TOPOGRAPHY OF THE SURFACE BY TWENTY FOOT CONTOUR CURVE LINES
D. ROBERTSON, SUPERINTENDENT.
W. A. MAY, Mining Engineer.
Scale 400 ft to 1 inch.

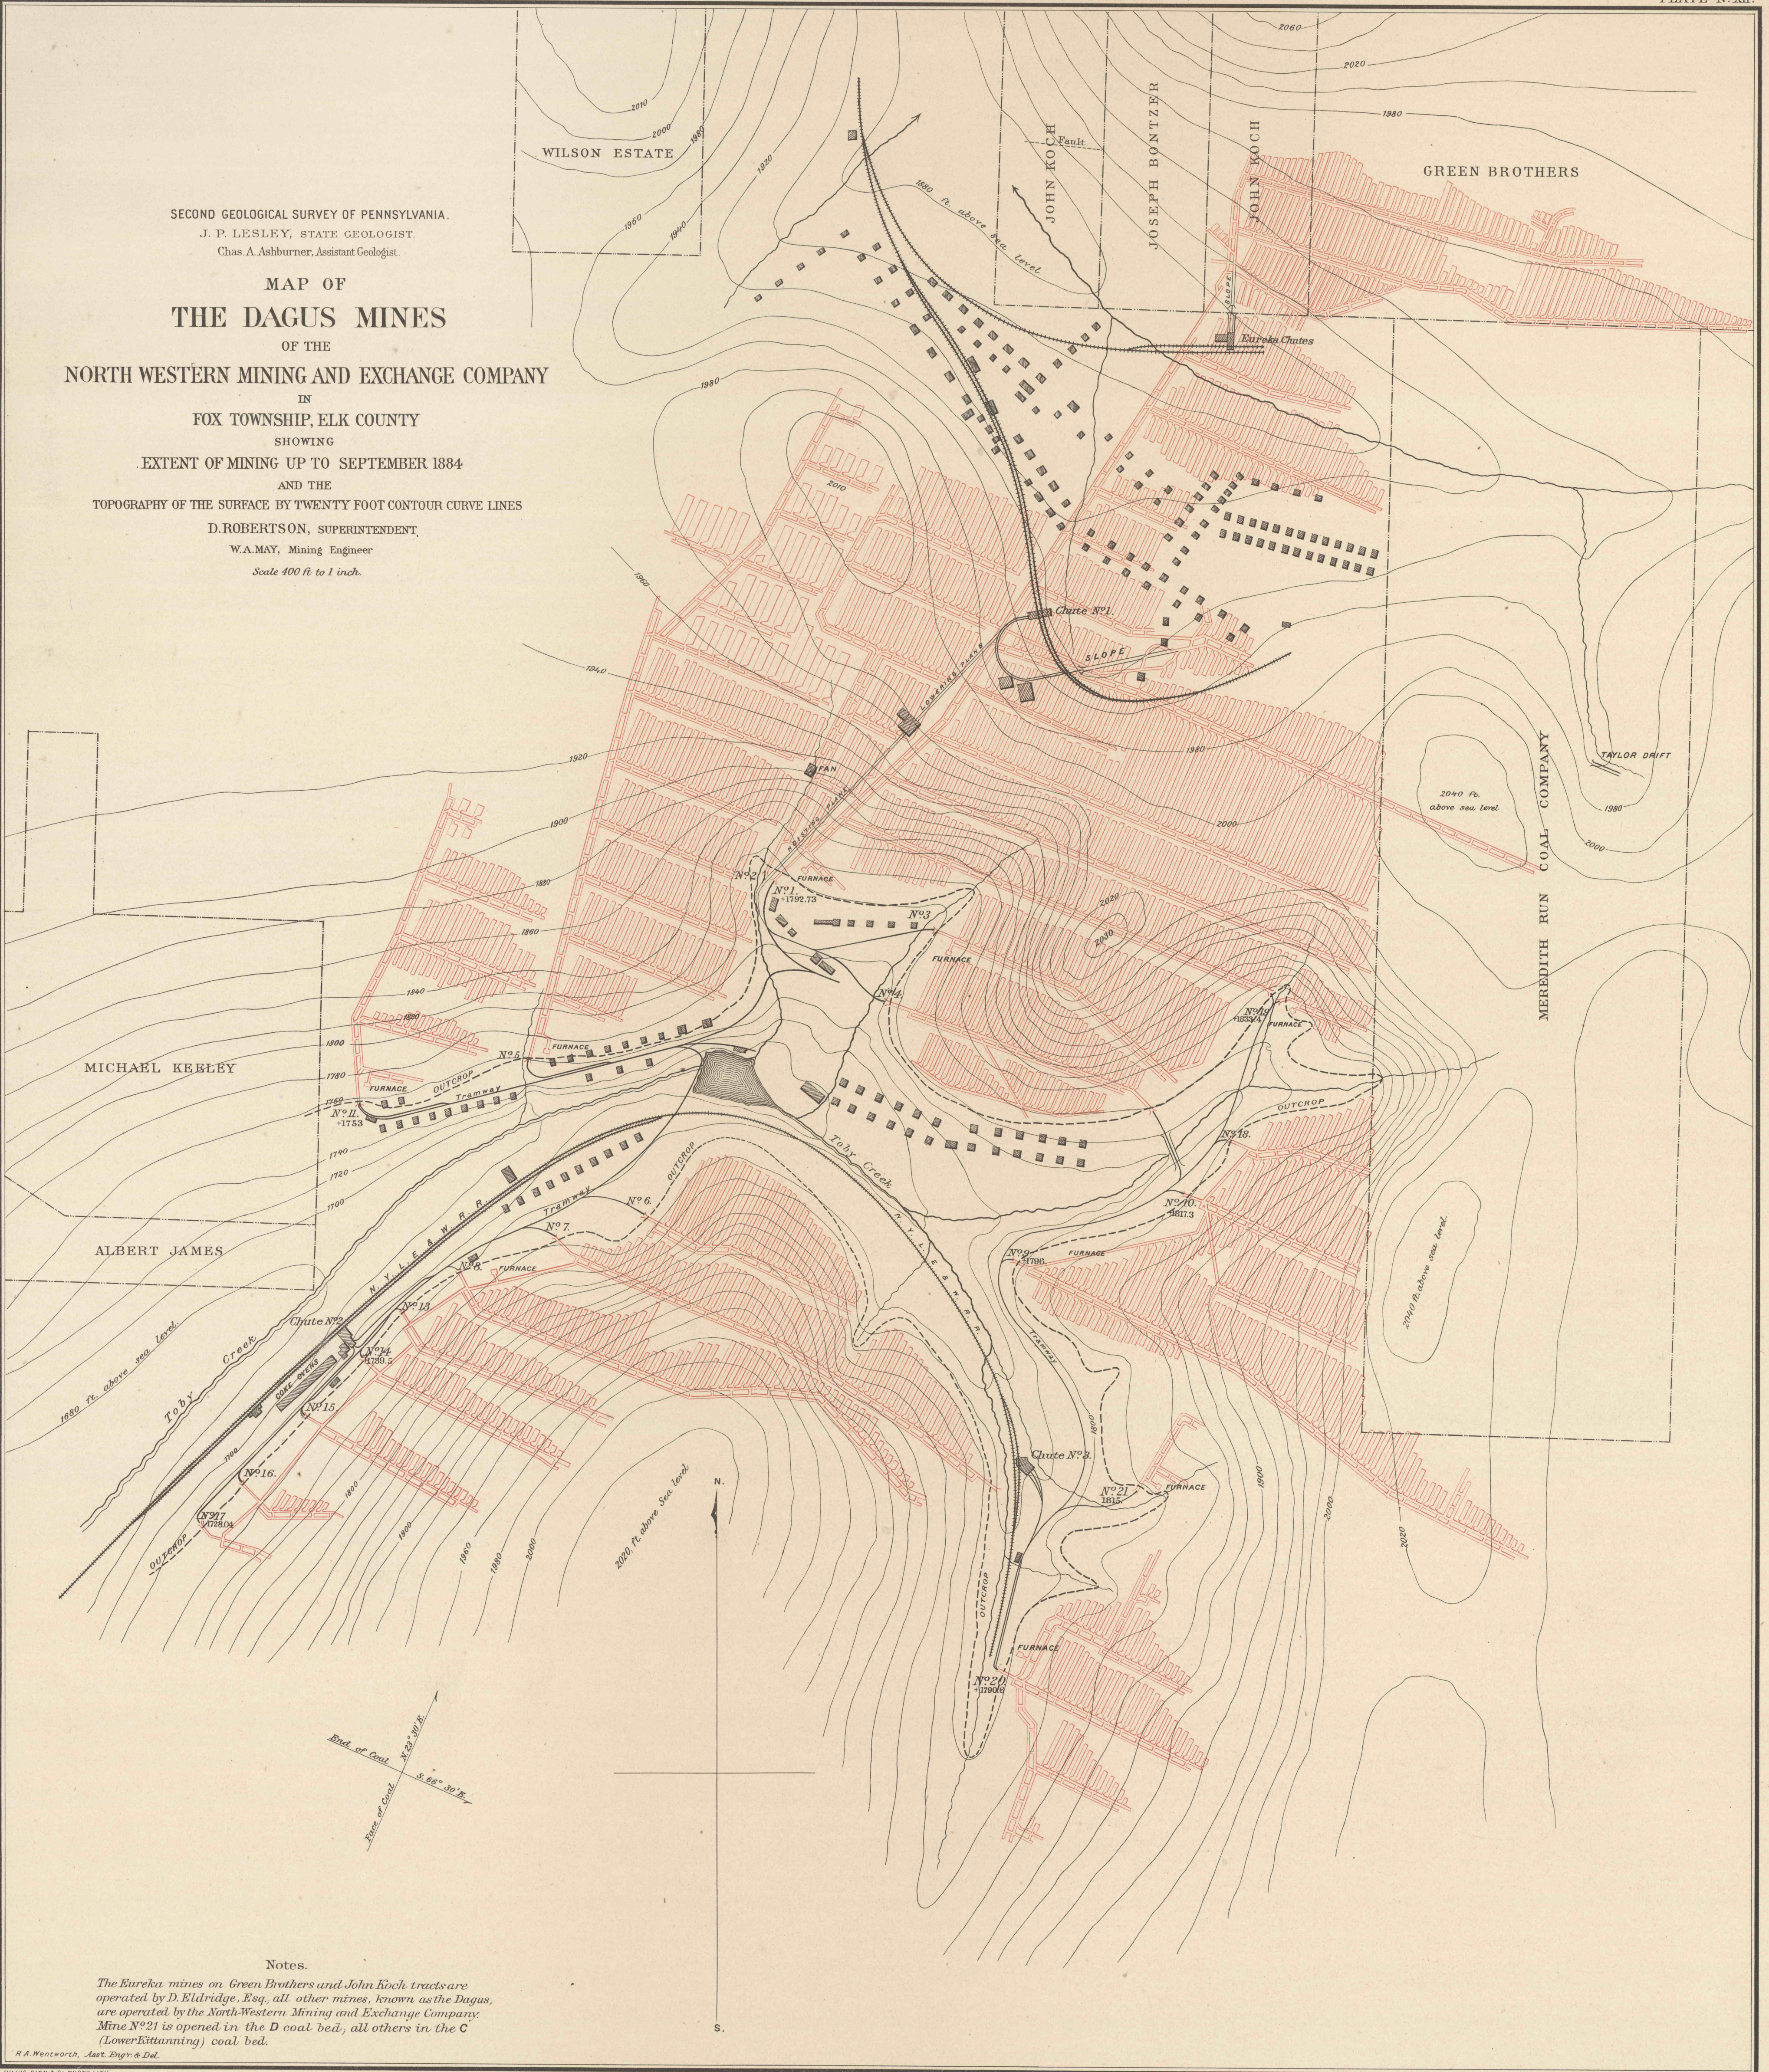


Notes.

The Eureka mines on Green Brothers and John Koch tracts are operated by D. Eldridge, Esq., all other mines, known as the Dagus, are operated by the North-Western Mining and Exchange Company. Mine No. 21 is opened in the D coal bed, all others in the C (Lower Kittanning) coal bed.

H. A. Wentworth, Asst. Engr. & Del.

JULIUS BIEN & CO. PHOTO LITH.

Scale - 400 Feet to 1 Inch

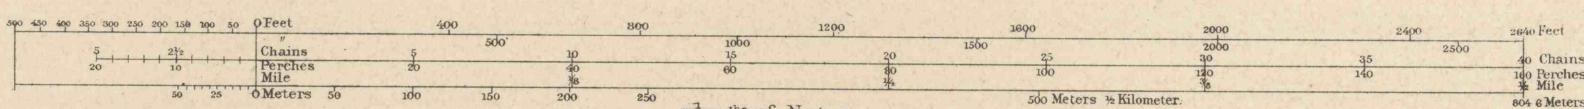

SEPTEMBER 1884.

LARUE S. HART, STATE PRINTER.