
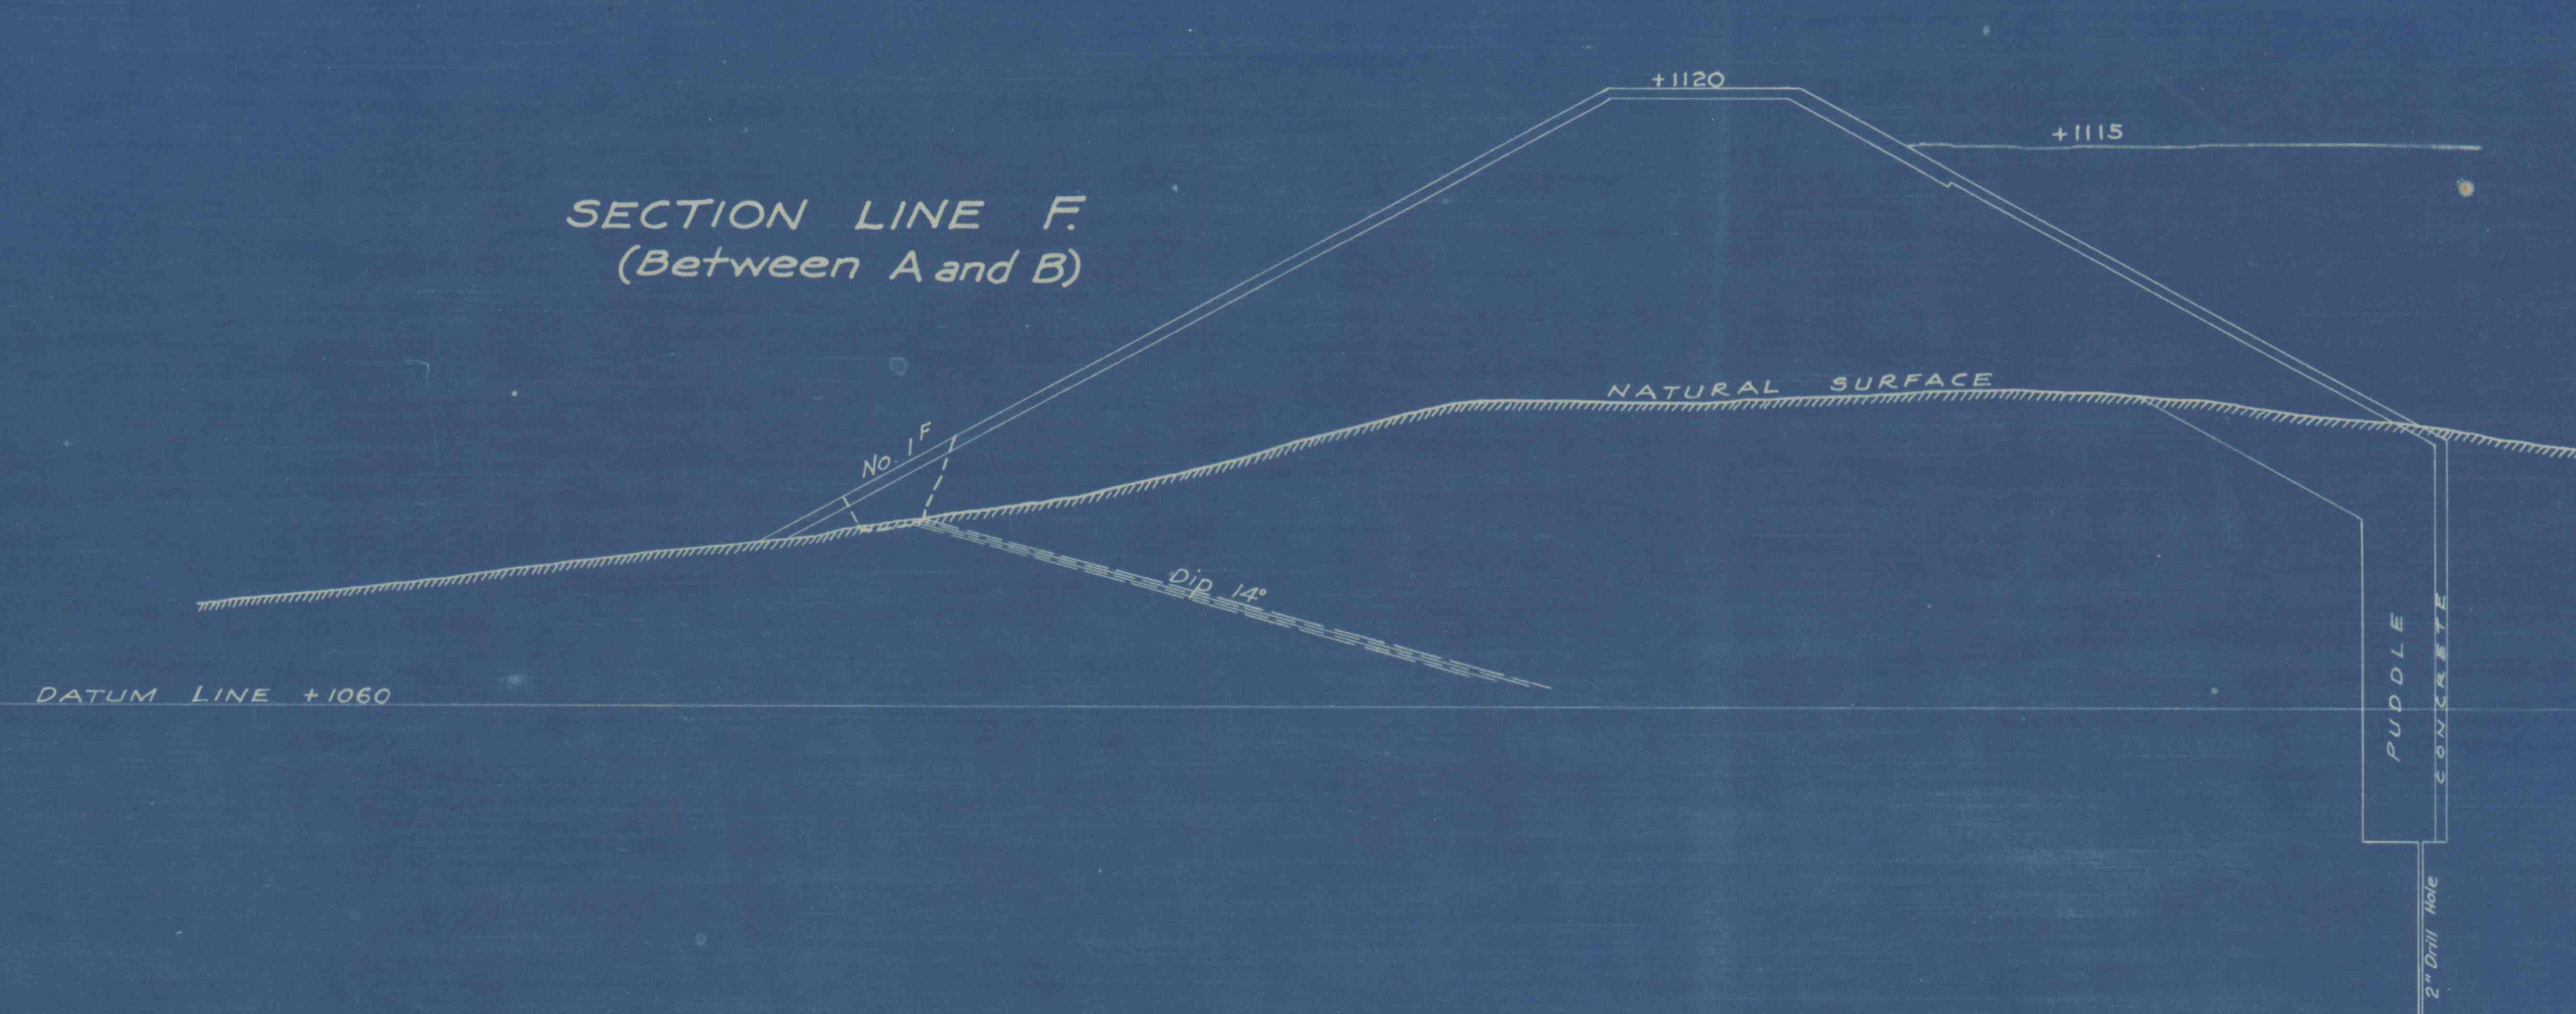
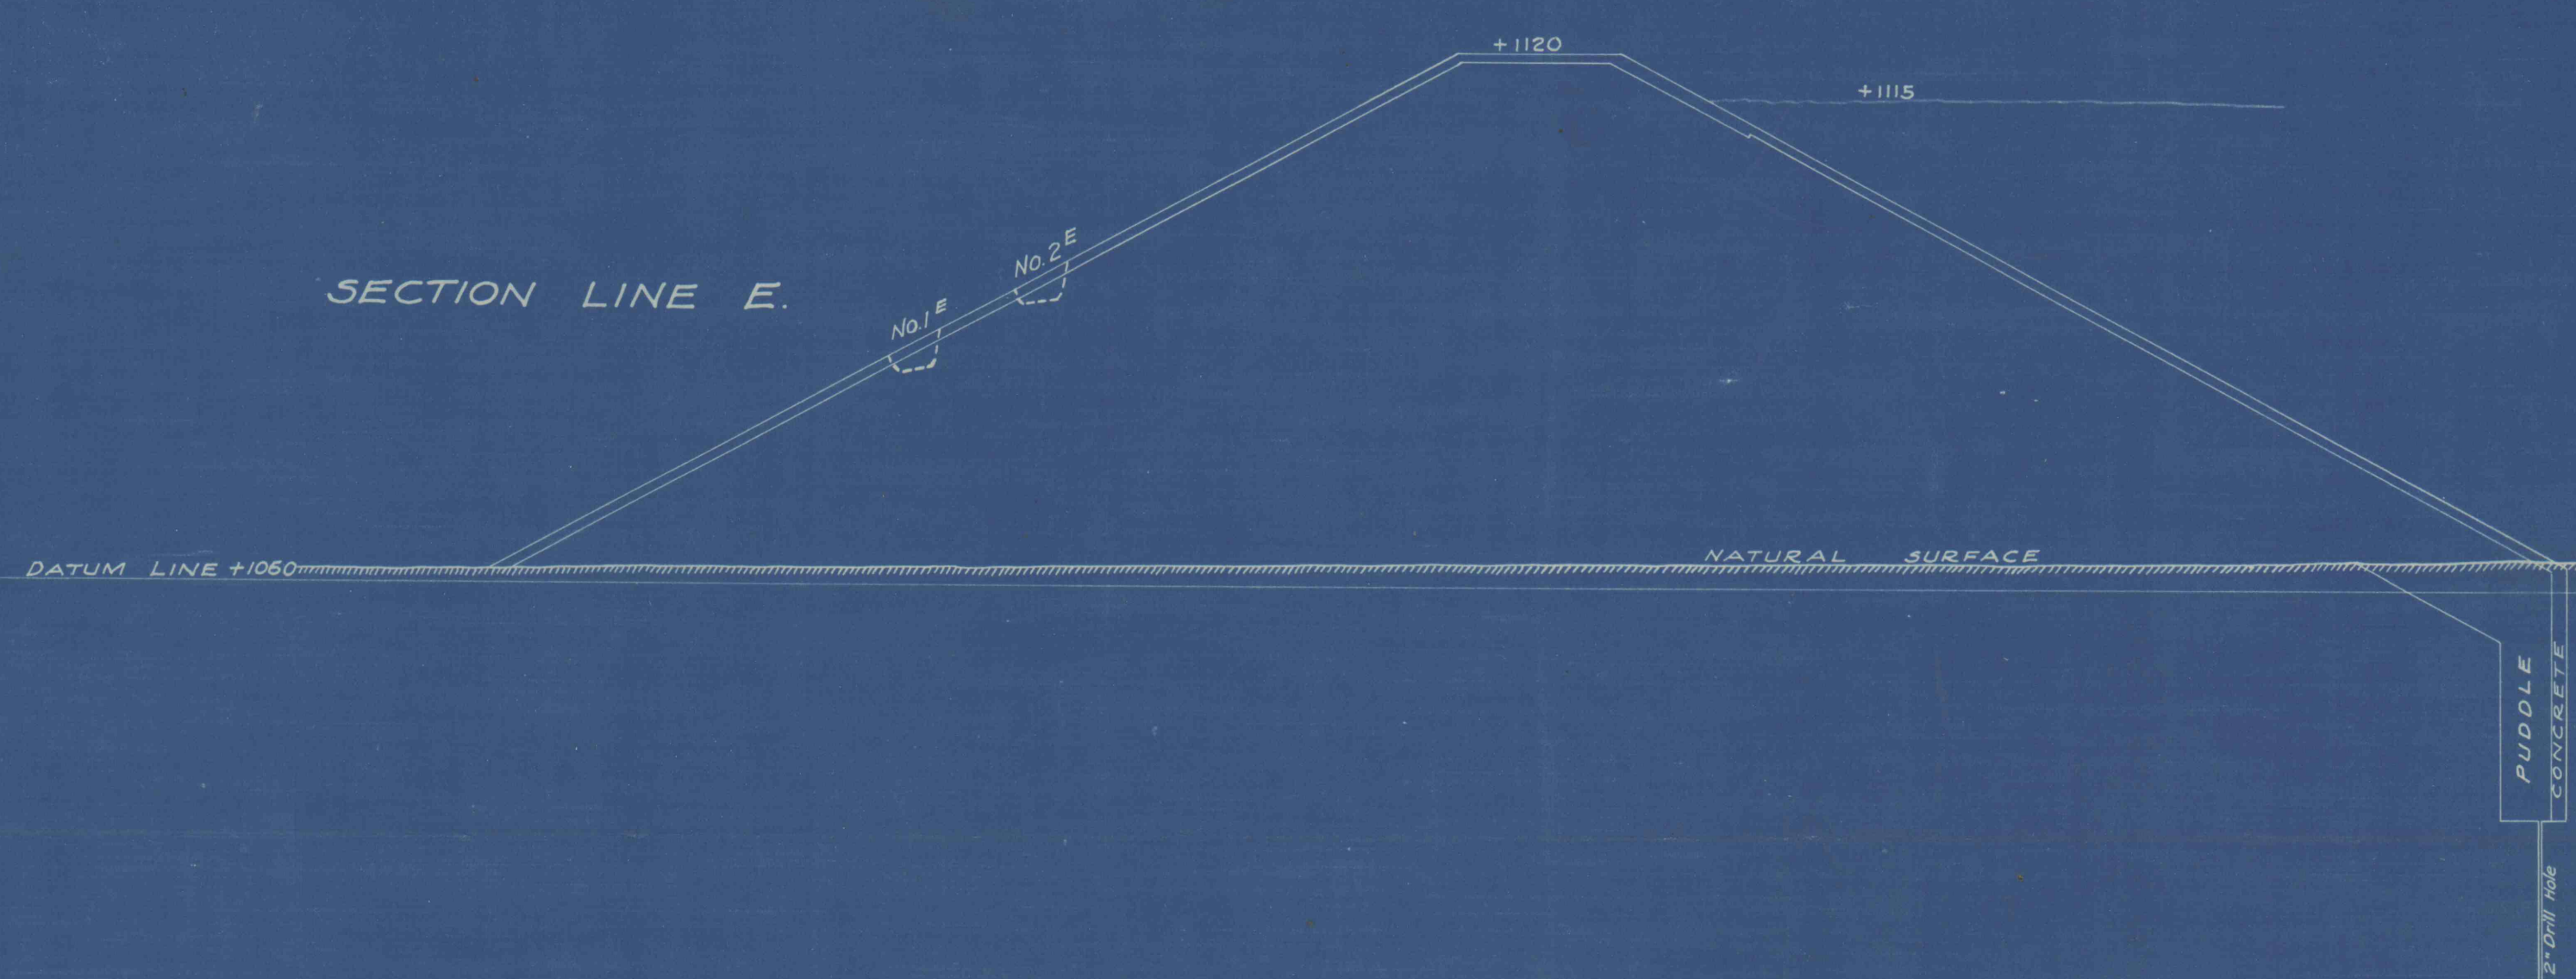
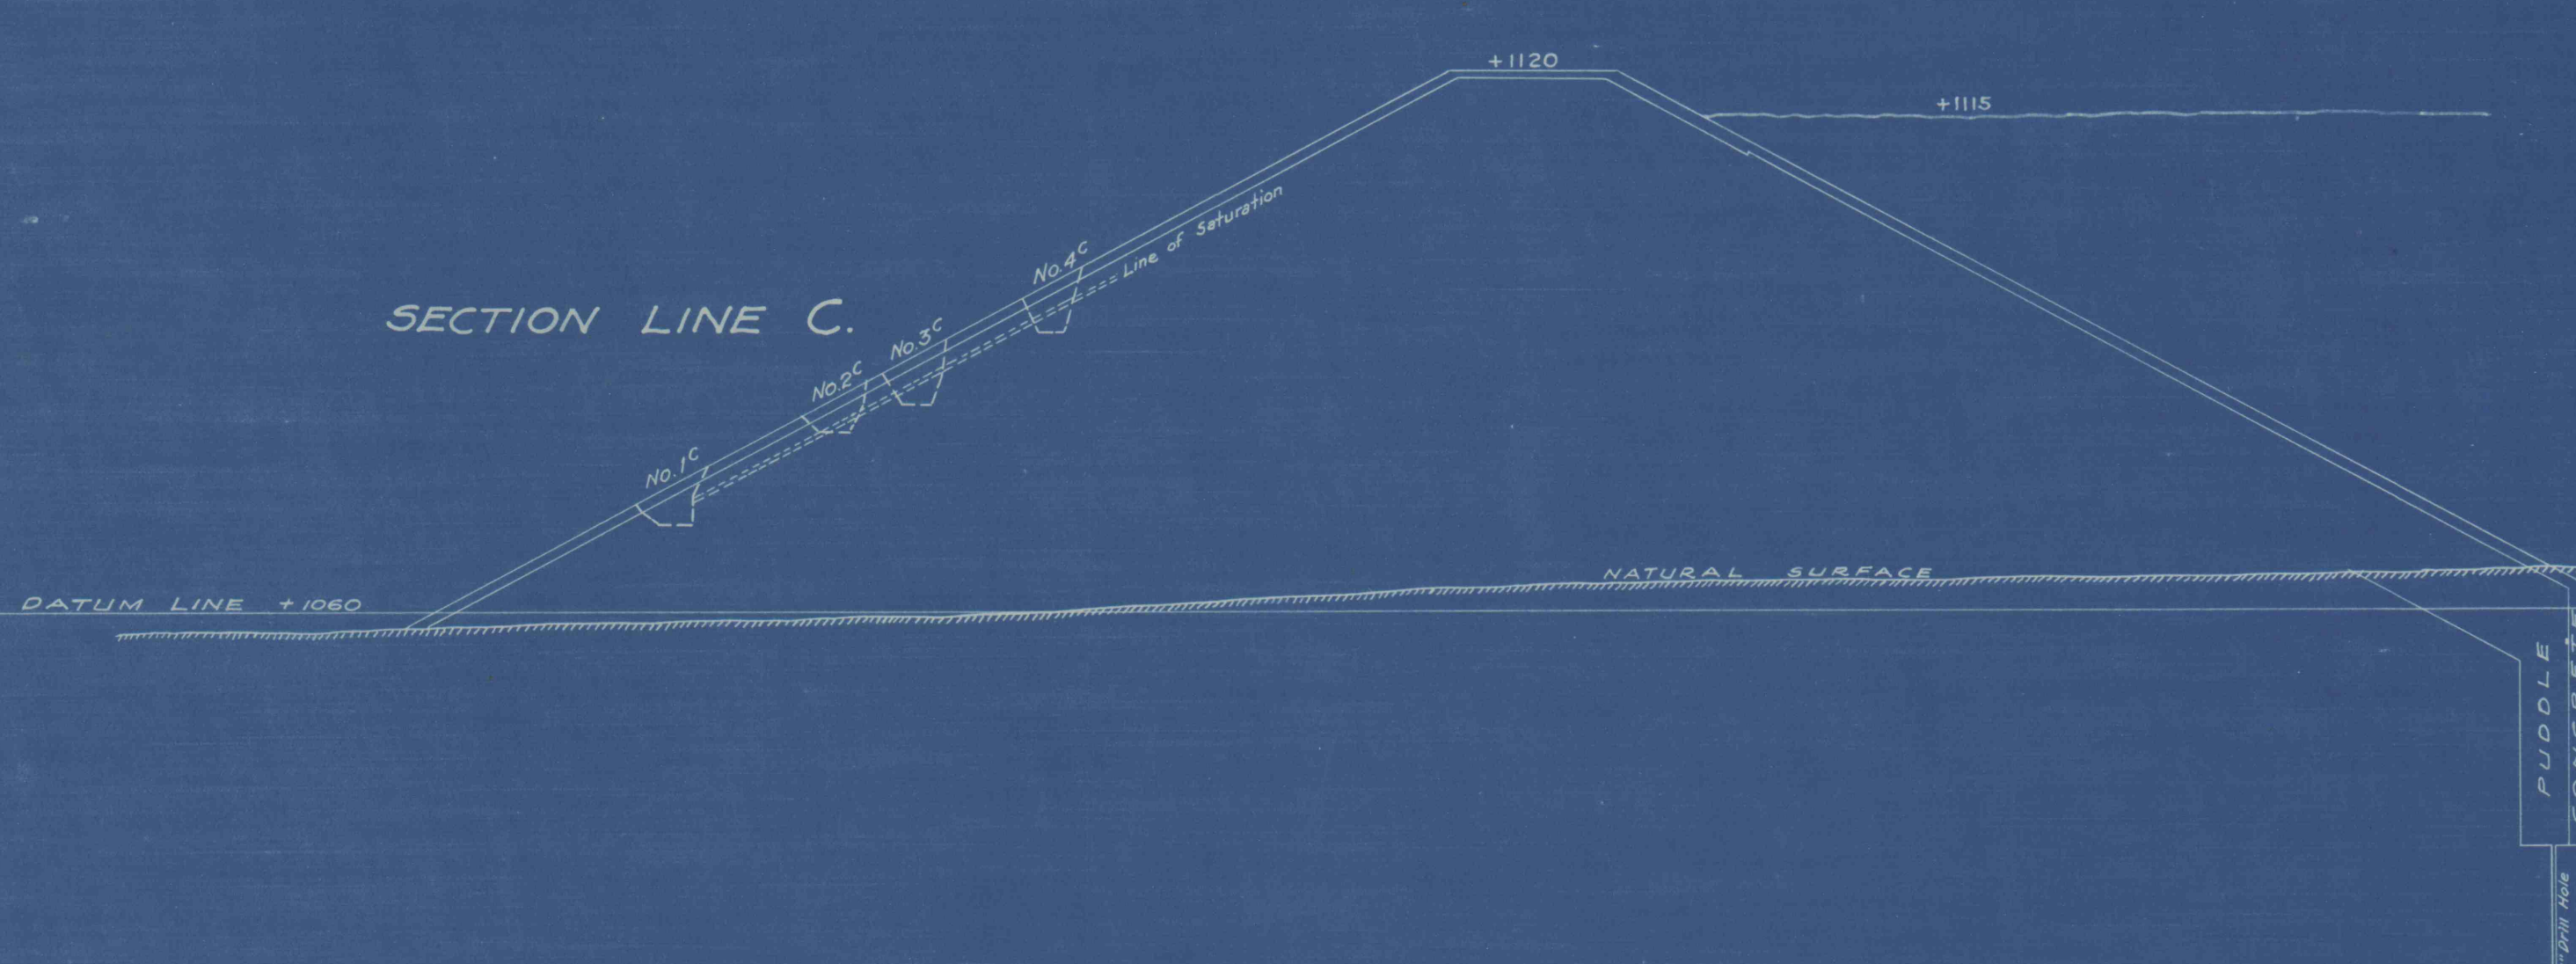
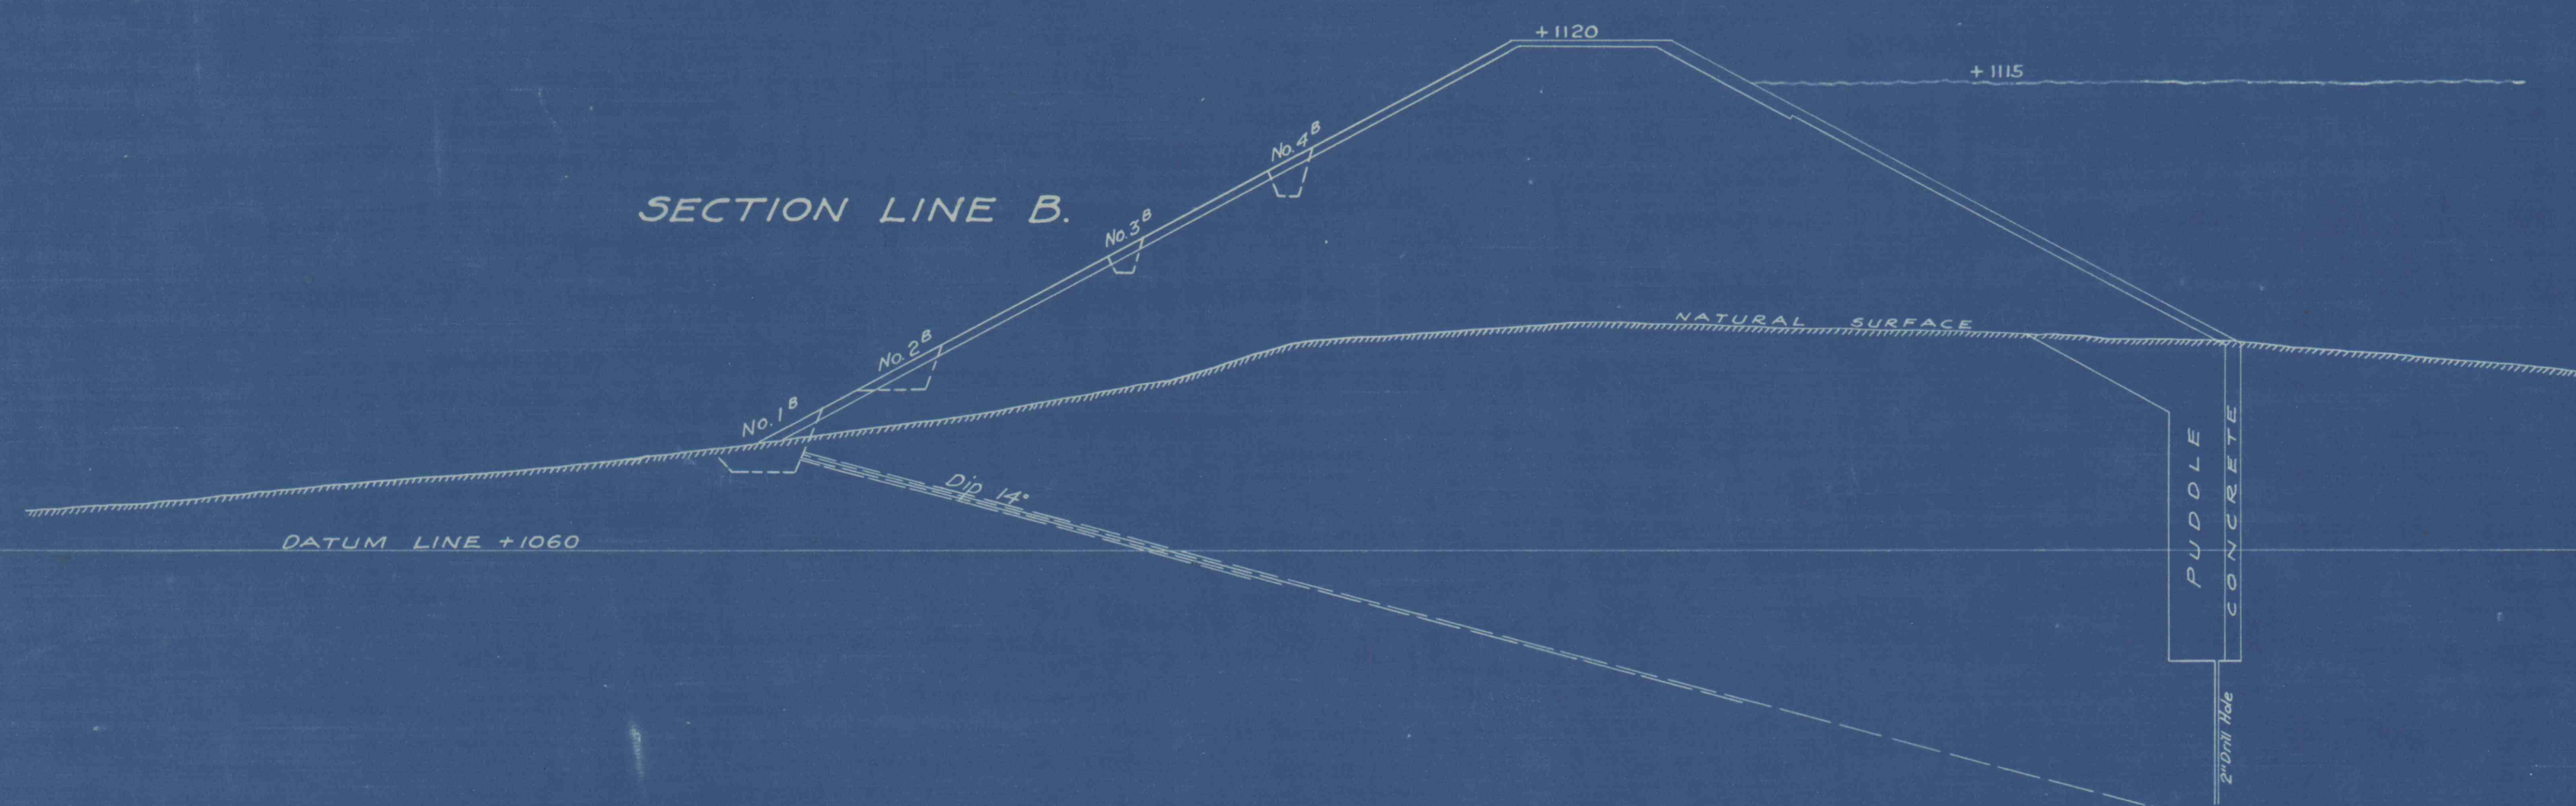


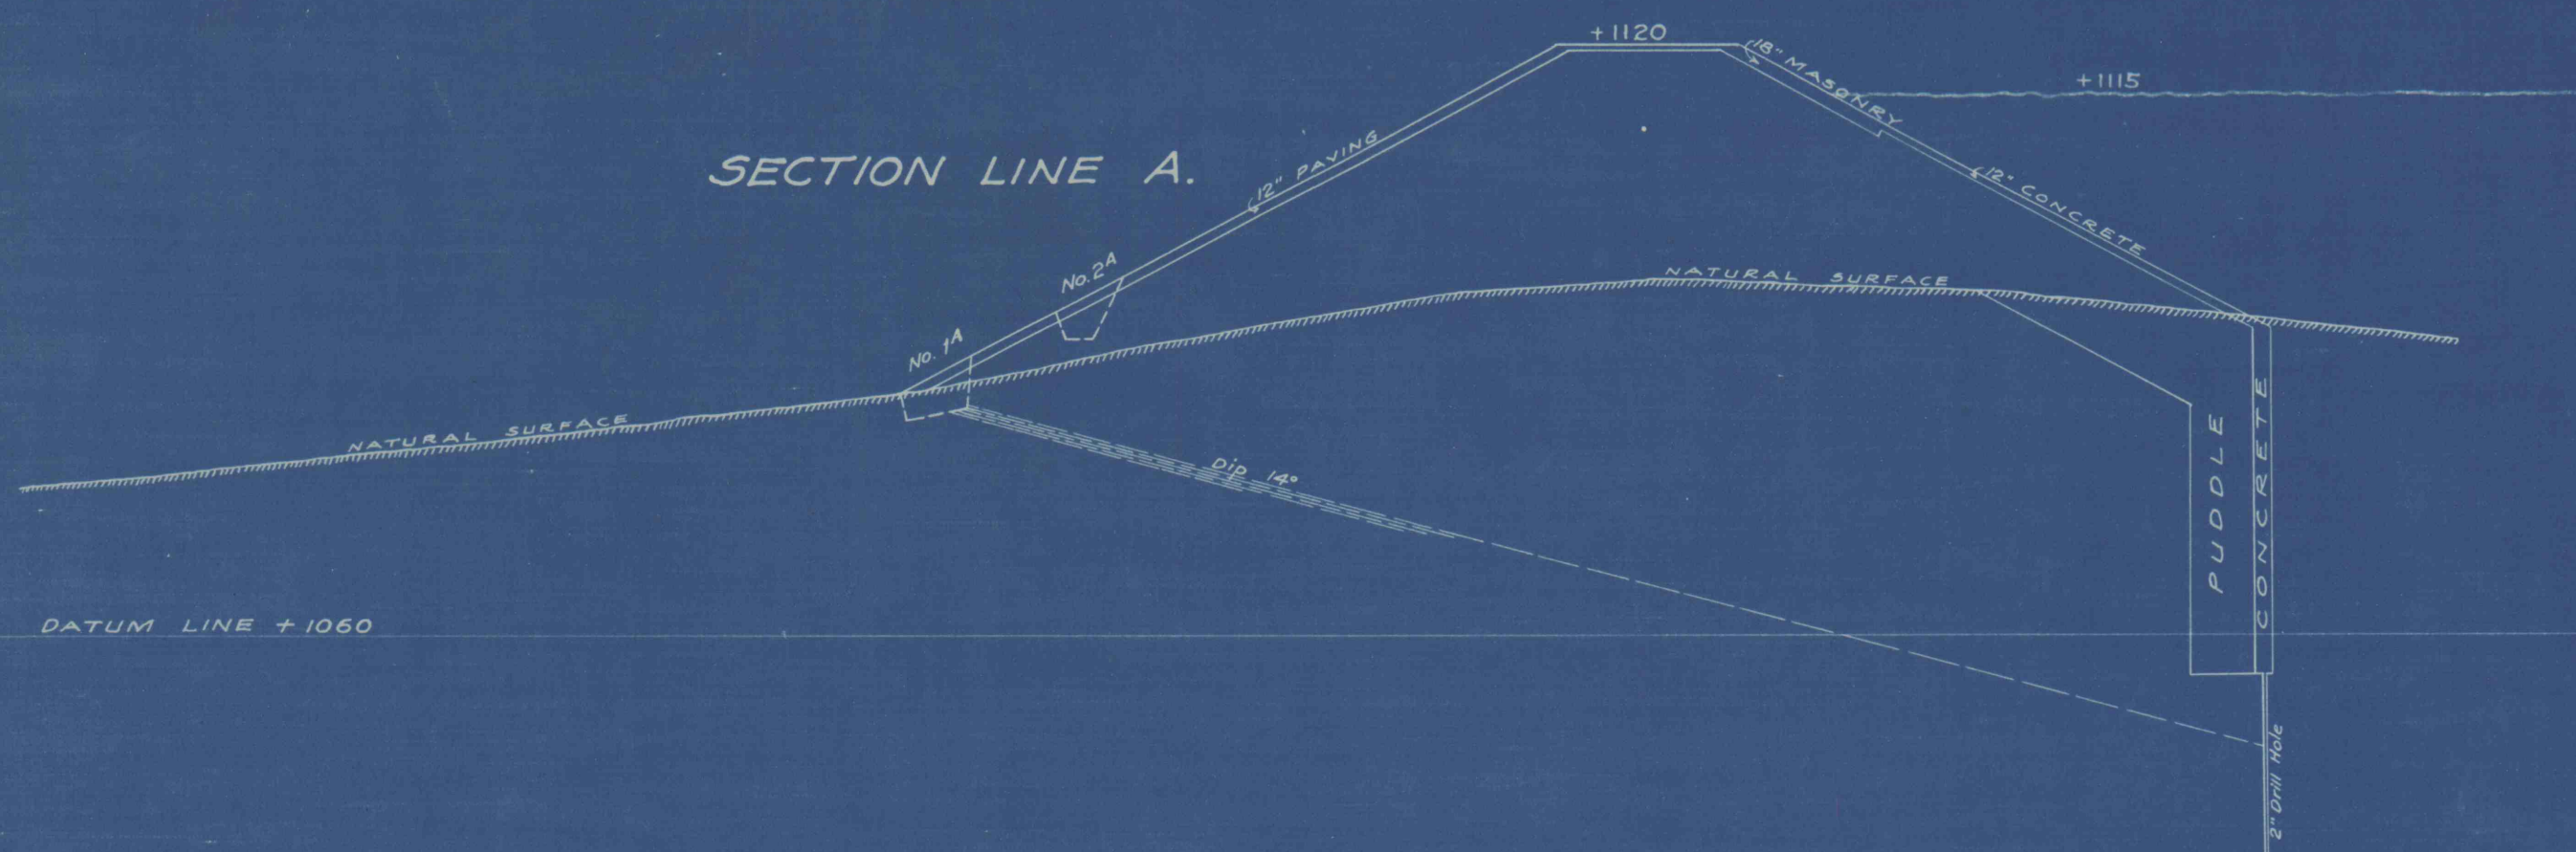

RESERVOIR No. 5
 SECTIONS SHOWING PITS DUG TO TEST
 SEEPAGE AND SATURATION
 Scale 1 inch = 20 feet Pottsville, Pa. James Archbald,
 June 14, 1918. GENERAL MANAGER,
 GIRARD WATER COMPANY.