


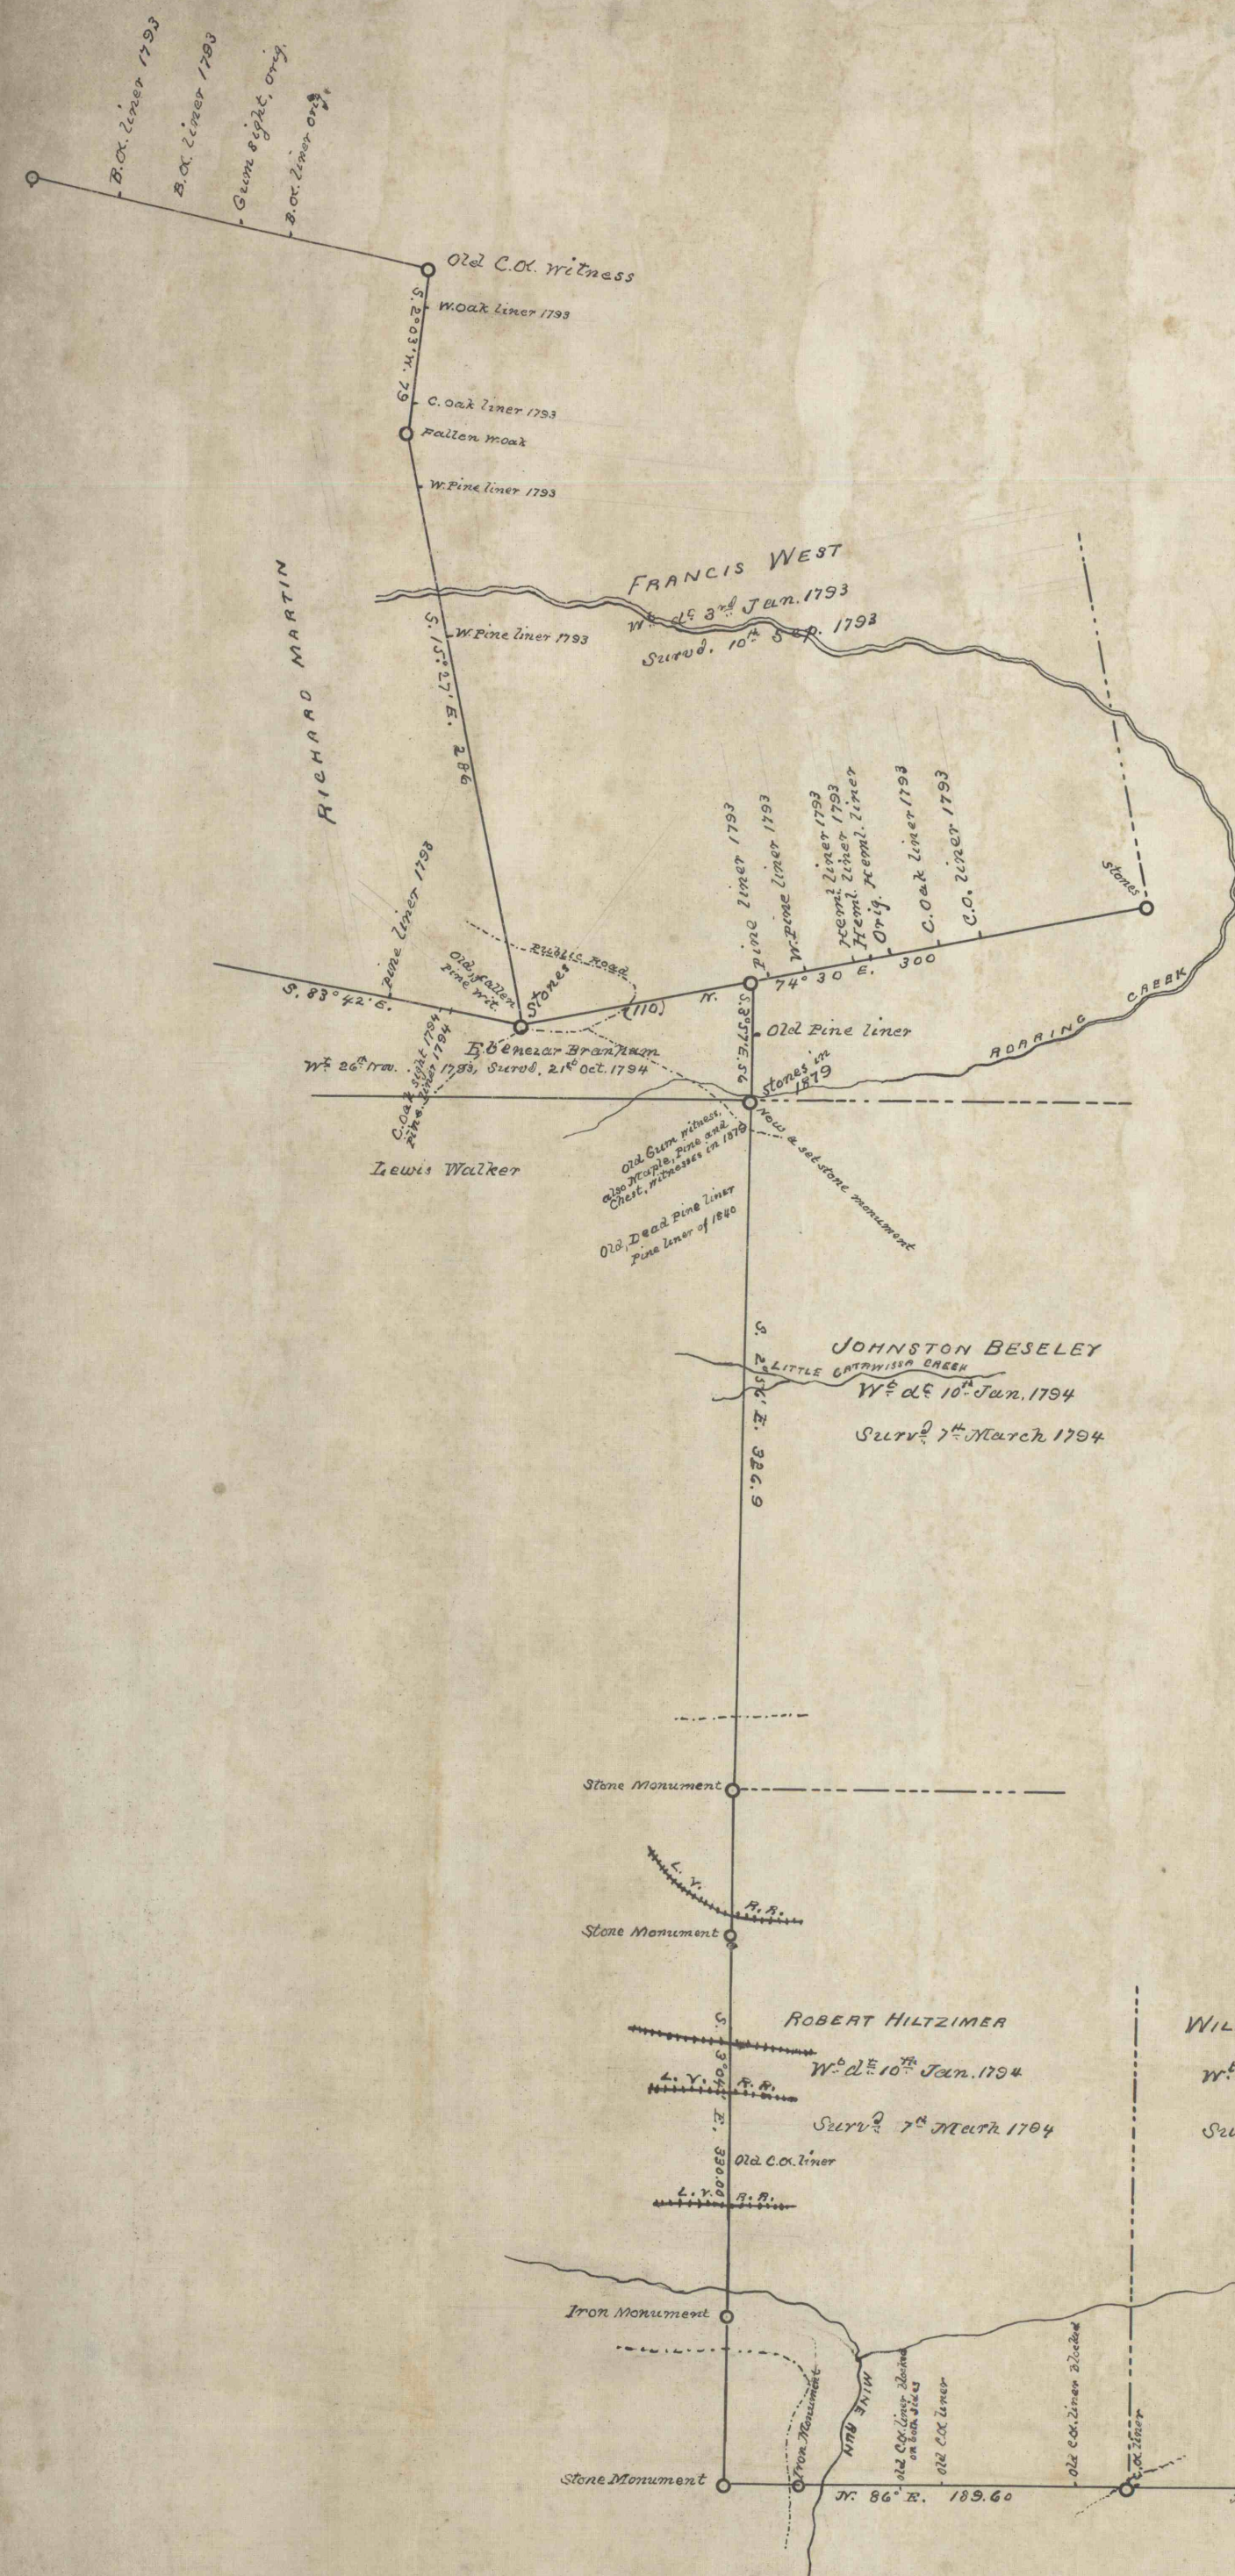

MAP
SHOWING LANDS IN SCHUYLKILL COUNTY PA.
BELONGING TO THE GIRARD ESTATE.
Resurveyed in July & August
1912.
W^m P. Mitchell
Scale 80 rods = 1 inch.

AMOS WICKERSHAM

THOMAS BARNES JR.
W^d 10th Jan. 1794
Surv^d 8th March 1794

ISAAC NORRIS
W^d dated 10th Jan. 1794
Surv^d 8th March 1794

THOMAS P. COPE
W^d 10th Jan. 1794
Surv^d 3rd March 1794

JOSIAH HAINES
W^d 10th Jan. 1794
Surv^d 1st March 1794

ROBERT HILTZIMER
W^d 10th Jan. 1794
Surv^d 7th March 1794

WILLIAM SHANNON
W^d 10th Jan. 1794
Surv^d 7th March 1794

GEORGE BICKHAM
W^d 10th Jan. 1794
Surv^d 7th March 1794

PETER BENSON
W^d 10th Jan. 1794
Surv^d 6th March 1794

JOHN BARRON JR.
W^d 10th Jan. 1794
Surv^d 8th March 1794

ANDREW KENNEDY
W^d 10th Jan. 1794
Surv^d 5th March 1794

EDWARD LYNCH
W^d 10th Jan. 1794
Surv^d 4th March 1794

JOSEPH HOWELL
W^d 10th Jan. 1794
Surv^d 4th March 1794

ISAAC COPE
W^d 10th Jan. 1794
Surv^d 3rd March 1794

JAMES WENDEL
W^d 10th Jan. 1794
Surv^d 3rd March 1794

MATTHEW HENDERSON
W^d 1st July 1784
Surv^d 23rd Nov. 1784

MARY LOVE
W^d 24th Sep. 1793
Surv^d 15th Nov. 1793

WILLIAM CARTIGUES
W^d 4th Feb. 1793
Surv^d 13th Feb. 1793

JOHN BURK
W^d 18th March 1793
Surv^d 28th March 1793

Old Chest Co. cor.
1794