


CATAWISSA RAILROAD.

EAST UNION TOWNSHIP,
SCHUYLKILL COUNTY, PA.

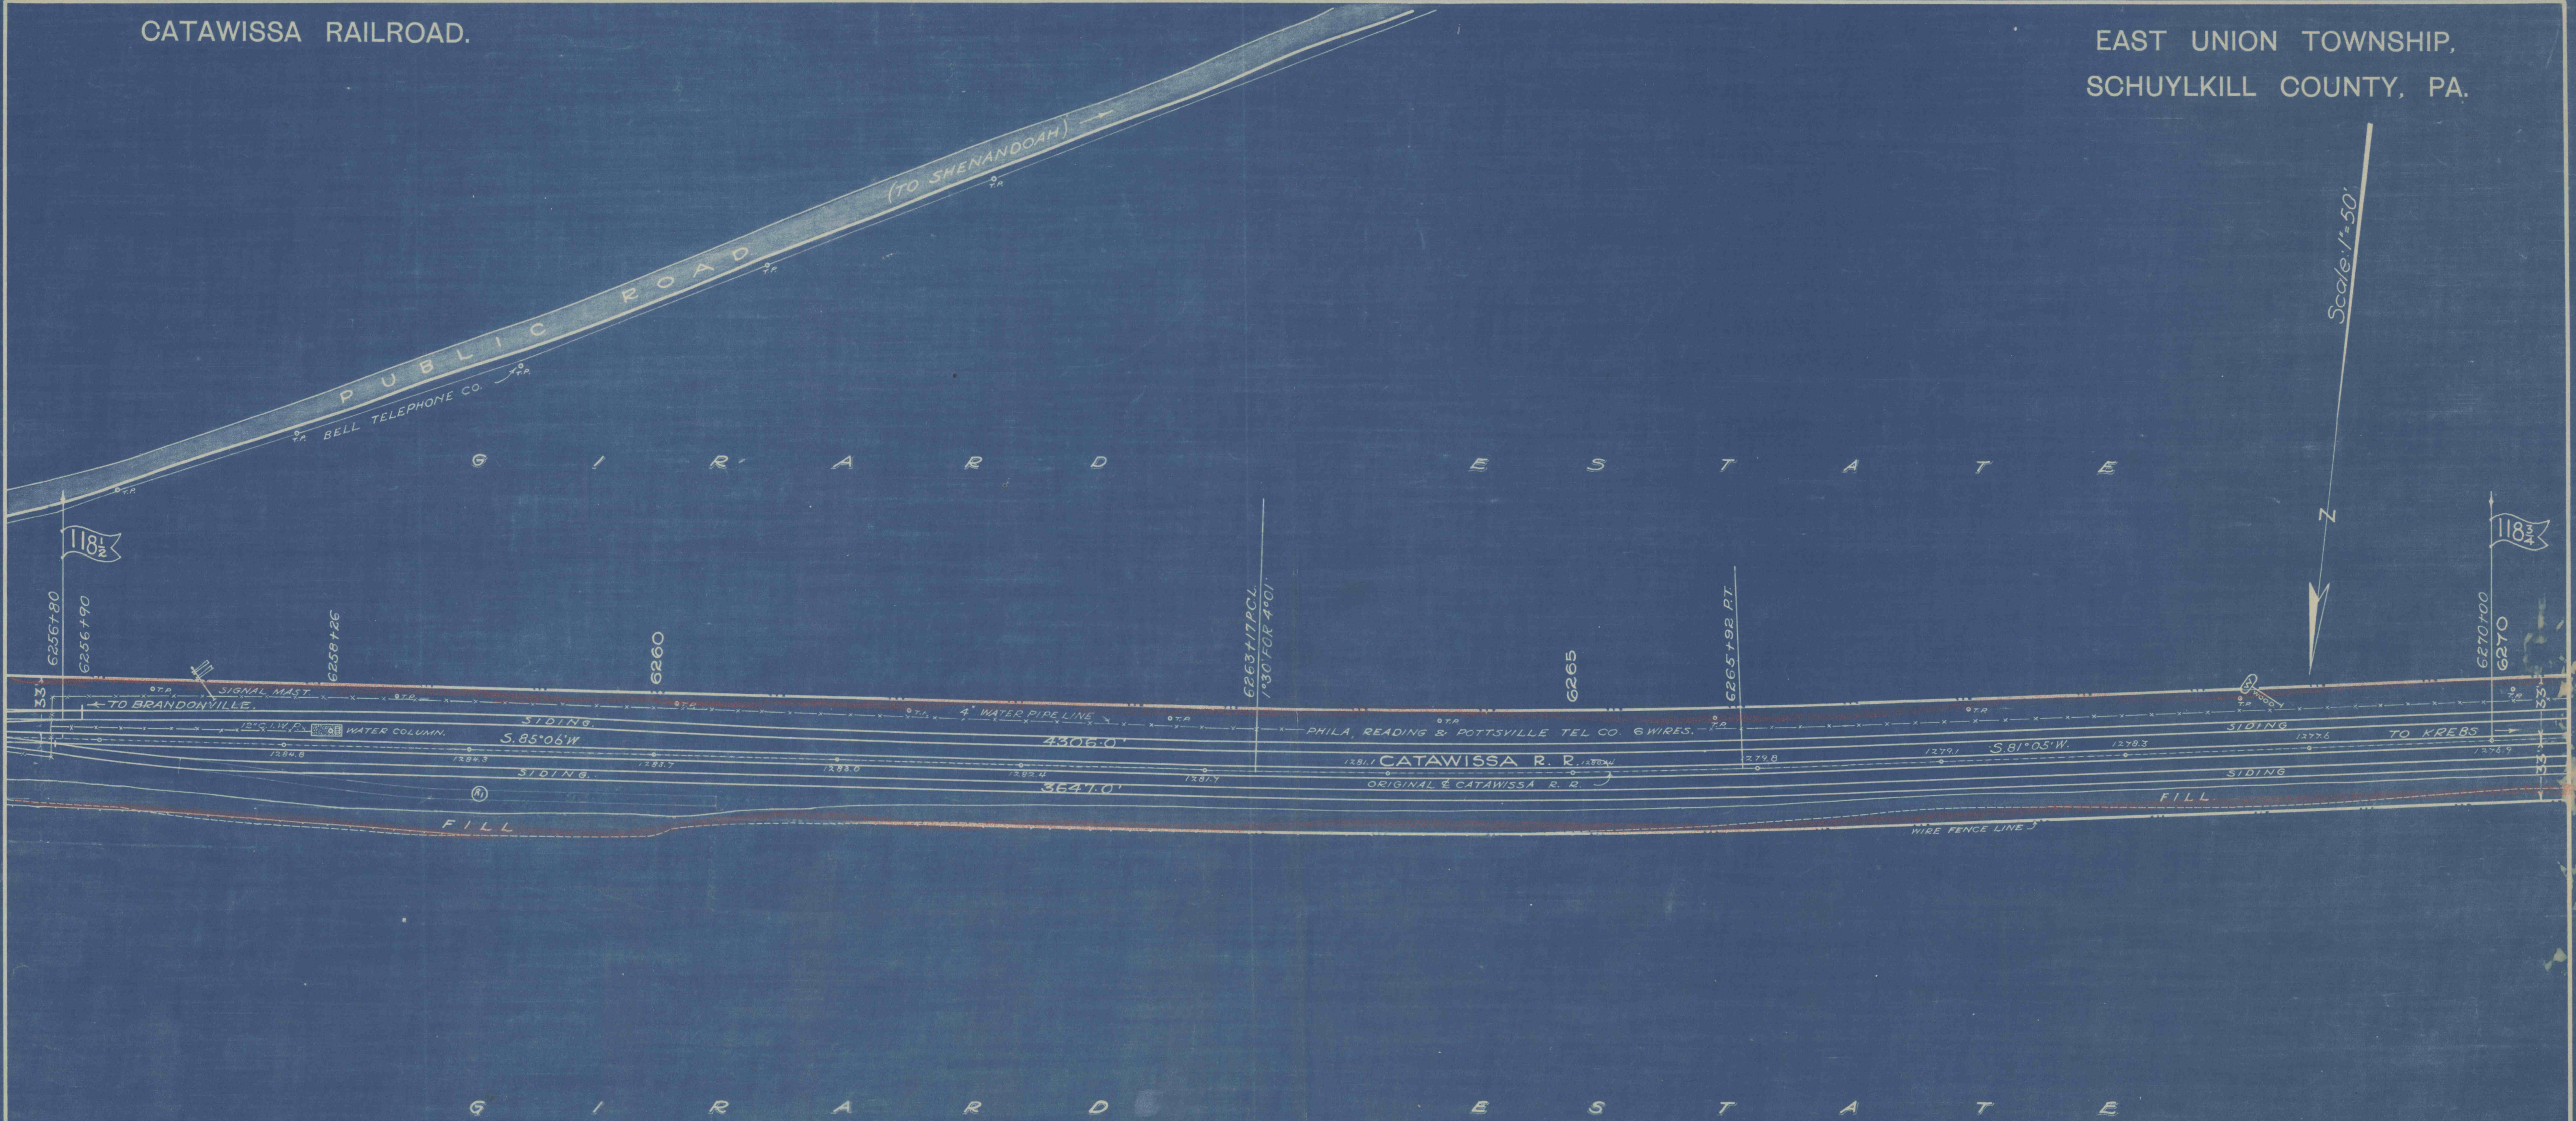

Track Elevations are top of rail.

④	SIDING REMOVED	9-20-22	E. B. & G. S.	C. R. R. N. 2	SEPTEMBER 1922
N. 2	REVISION OF TRACING	DATE	REVISED BY	NOTE BOOK	FEBRUARY 1916