


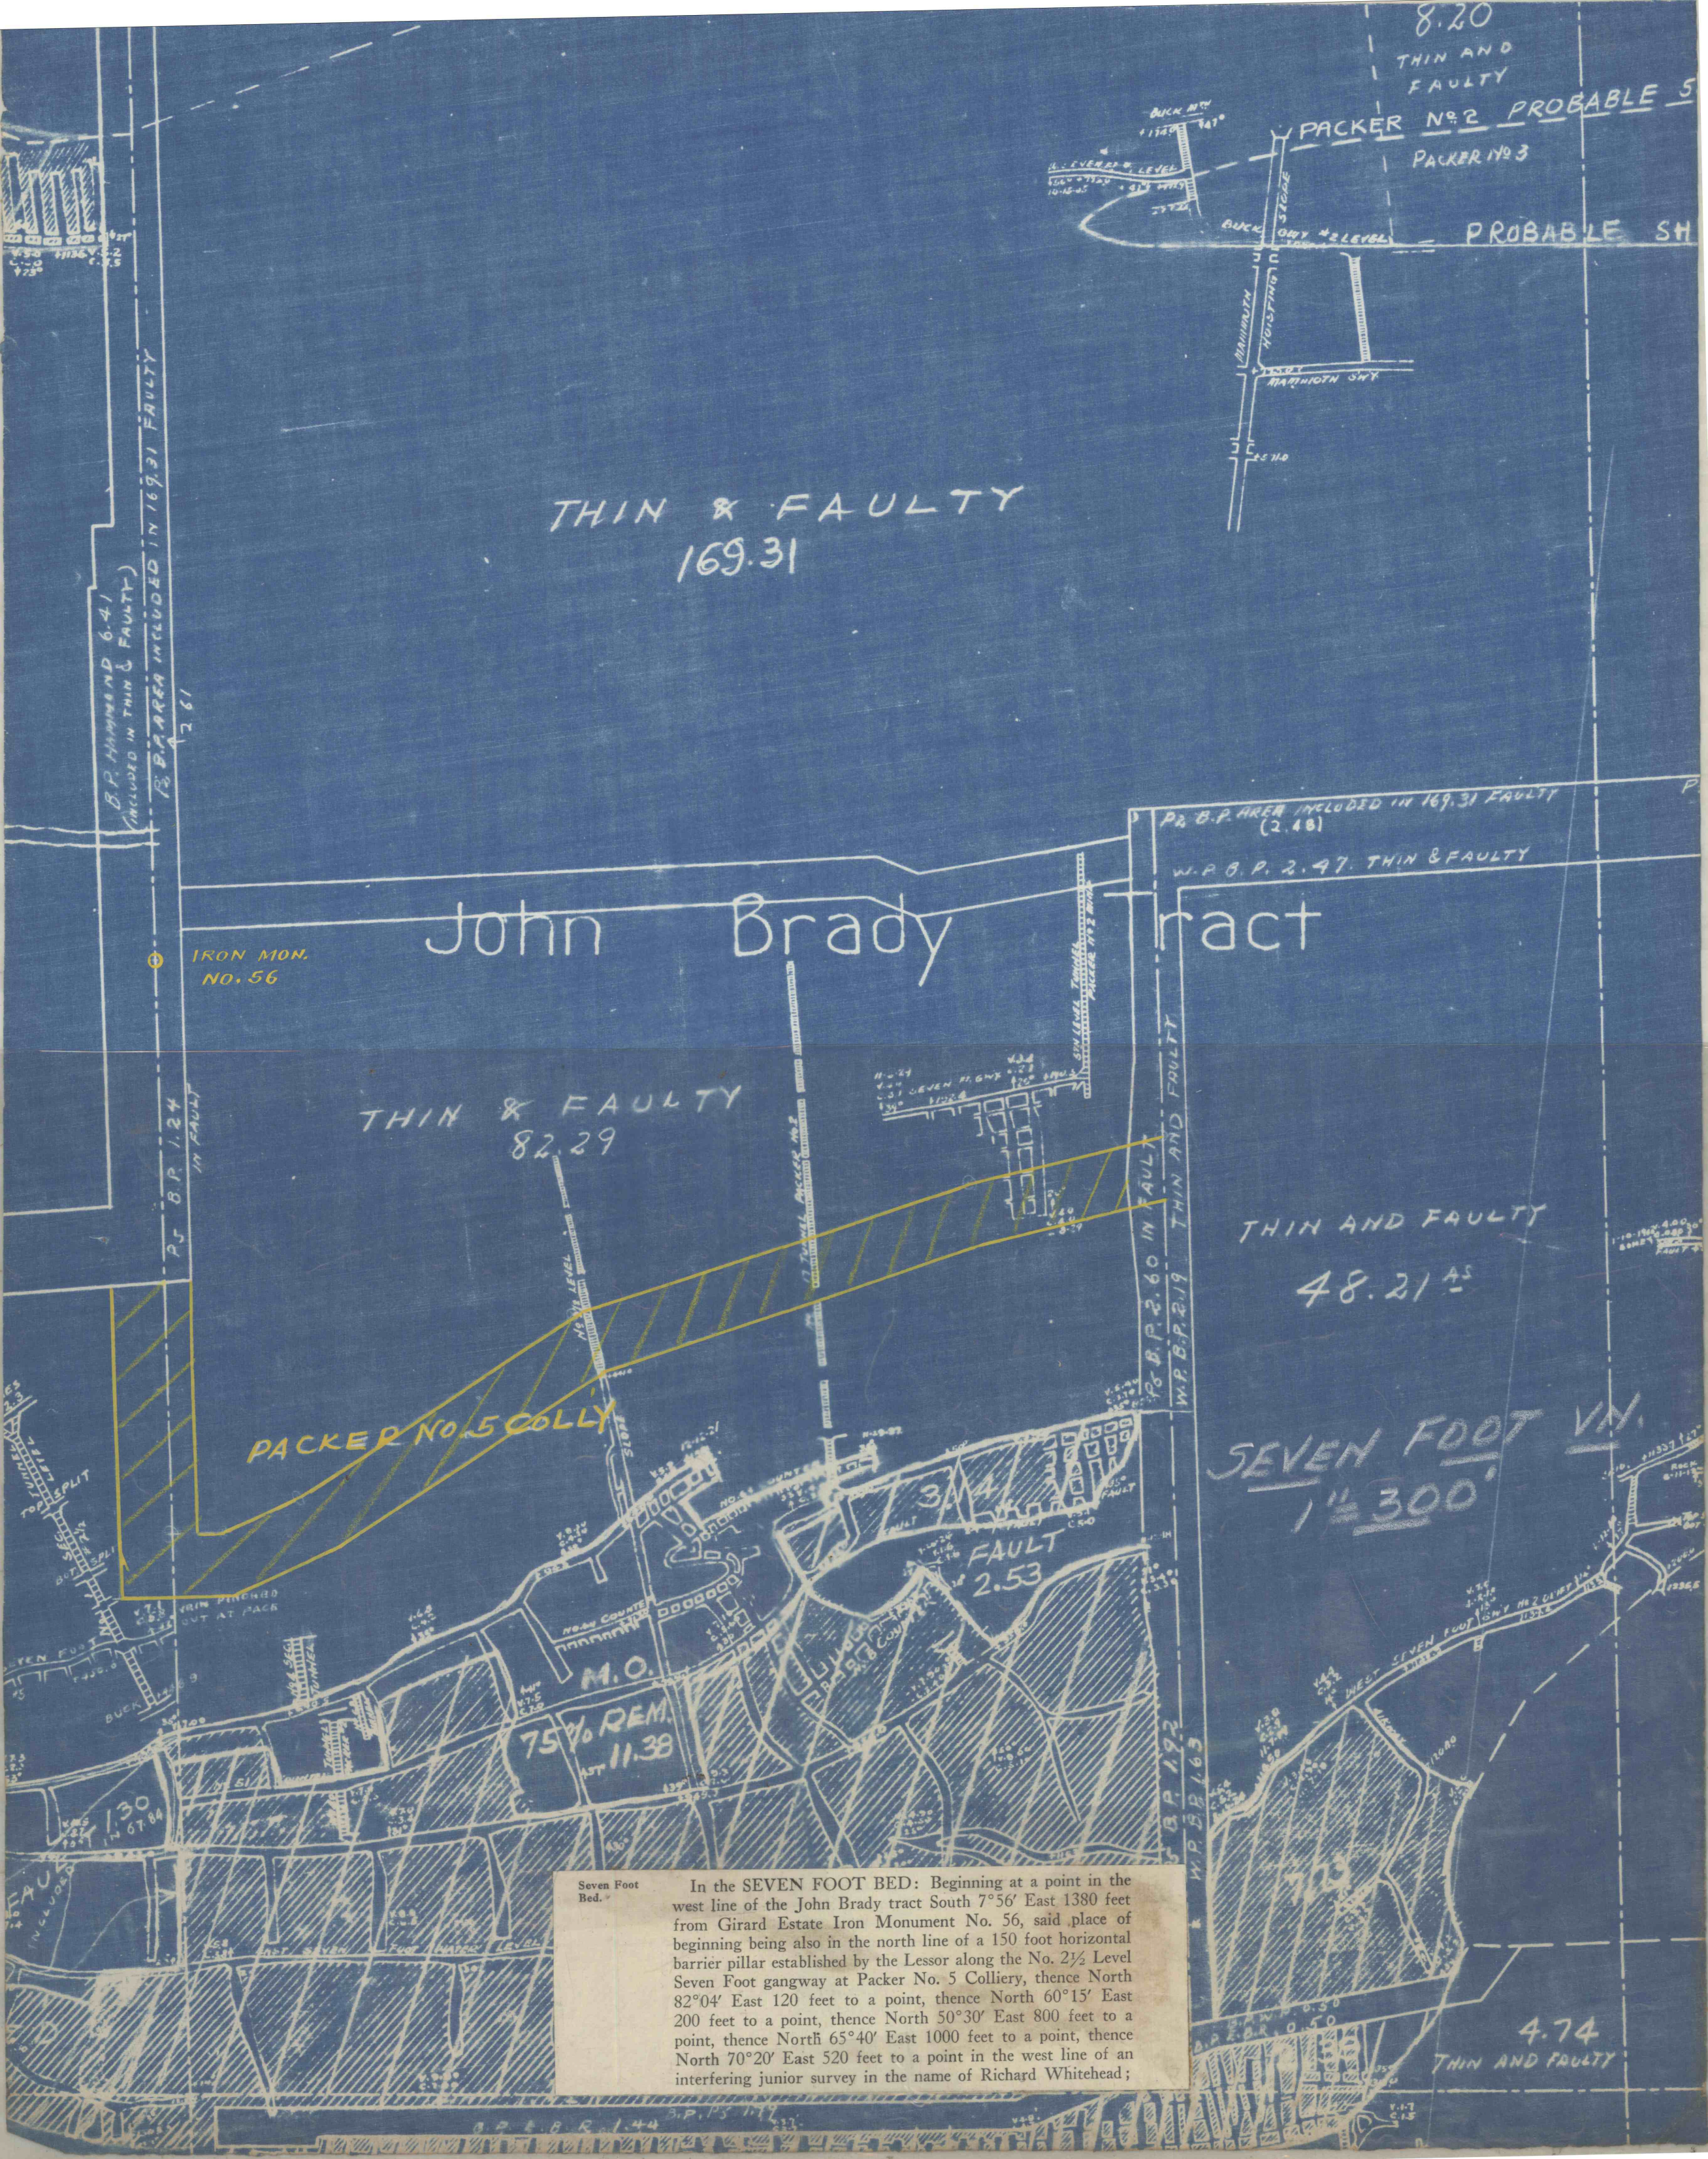

THIN & FAULTY
169.31

John Brady tract

THIN & FAULTY
82.29

THIN AND FAULTY
48.21

SEVEN FOOT VN.
1 1/2 300'

THIN AND FAULTY
4.74

Seven Foot
Bed.

In the SEVEN FOOT BED: Beginning at a point in the west line of the John Brady tract South 7°56' East 1380 feet from Girard Estate Iron Monument No. 56, said place of beginning being also in the north line of a 150 foot horizontal barrier pillar established by the Lessor along the No. 2 1/2 Level Seven Foot gangway at Packer No. 5 Colliery, thence North 82°04' East 120 feet to a point, thence North 60°15' East 200 feet to a point, thence North 50°30' East 800 feet to a point, thence North 65°40' East 1000 feet to a point, thence North 70°20' East 520 feet to a point in the west line of an interfering junior survey in the name of Richard Whitehead;