


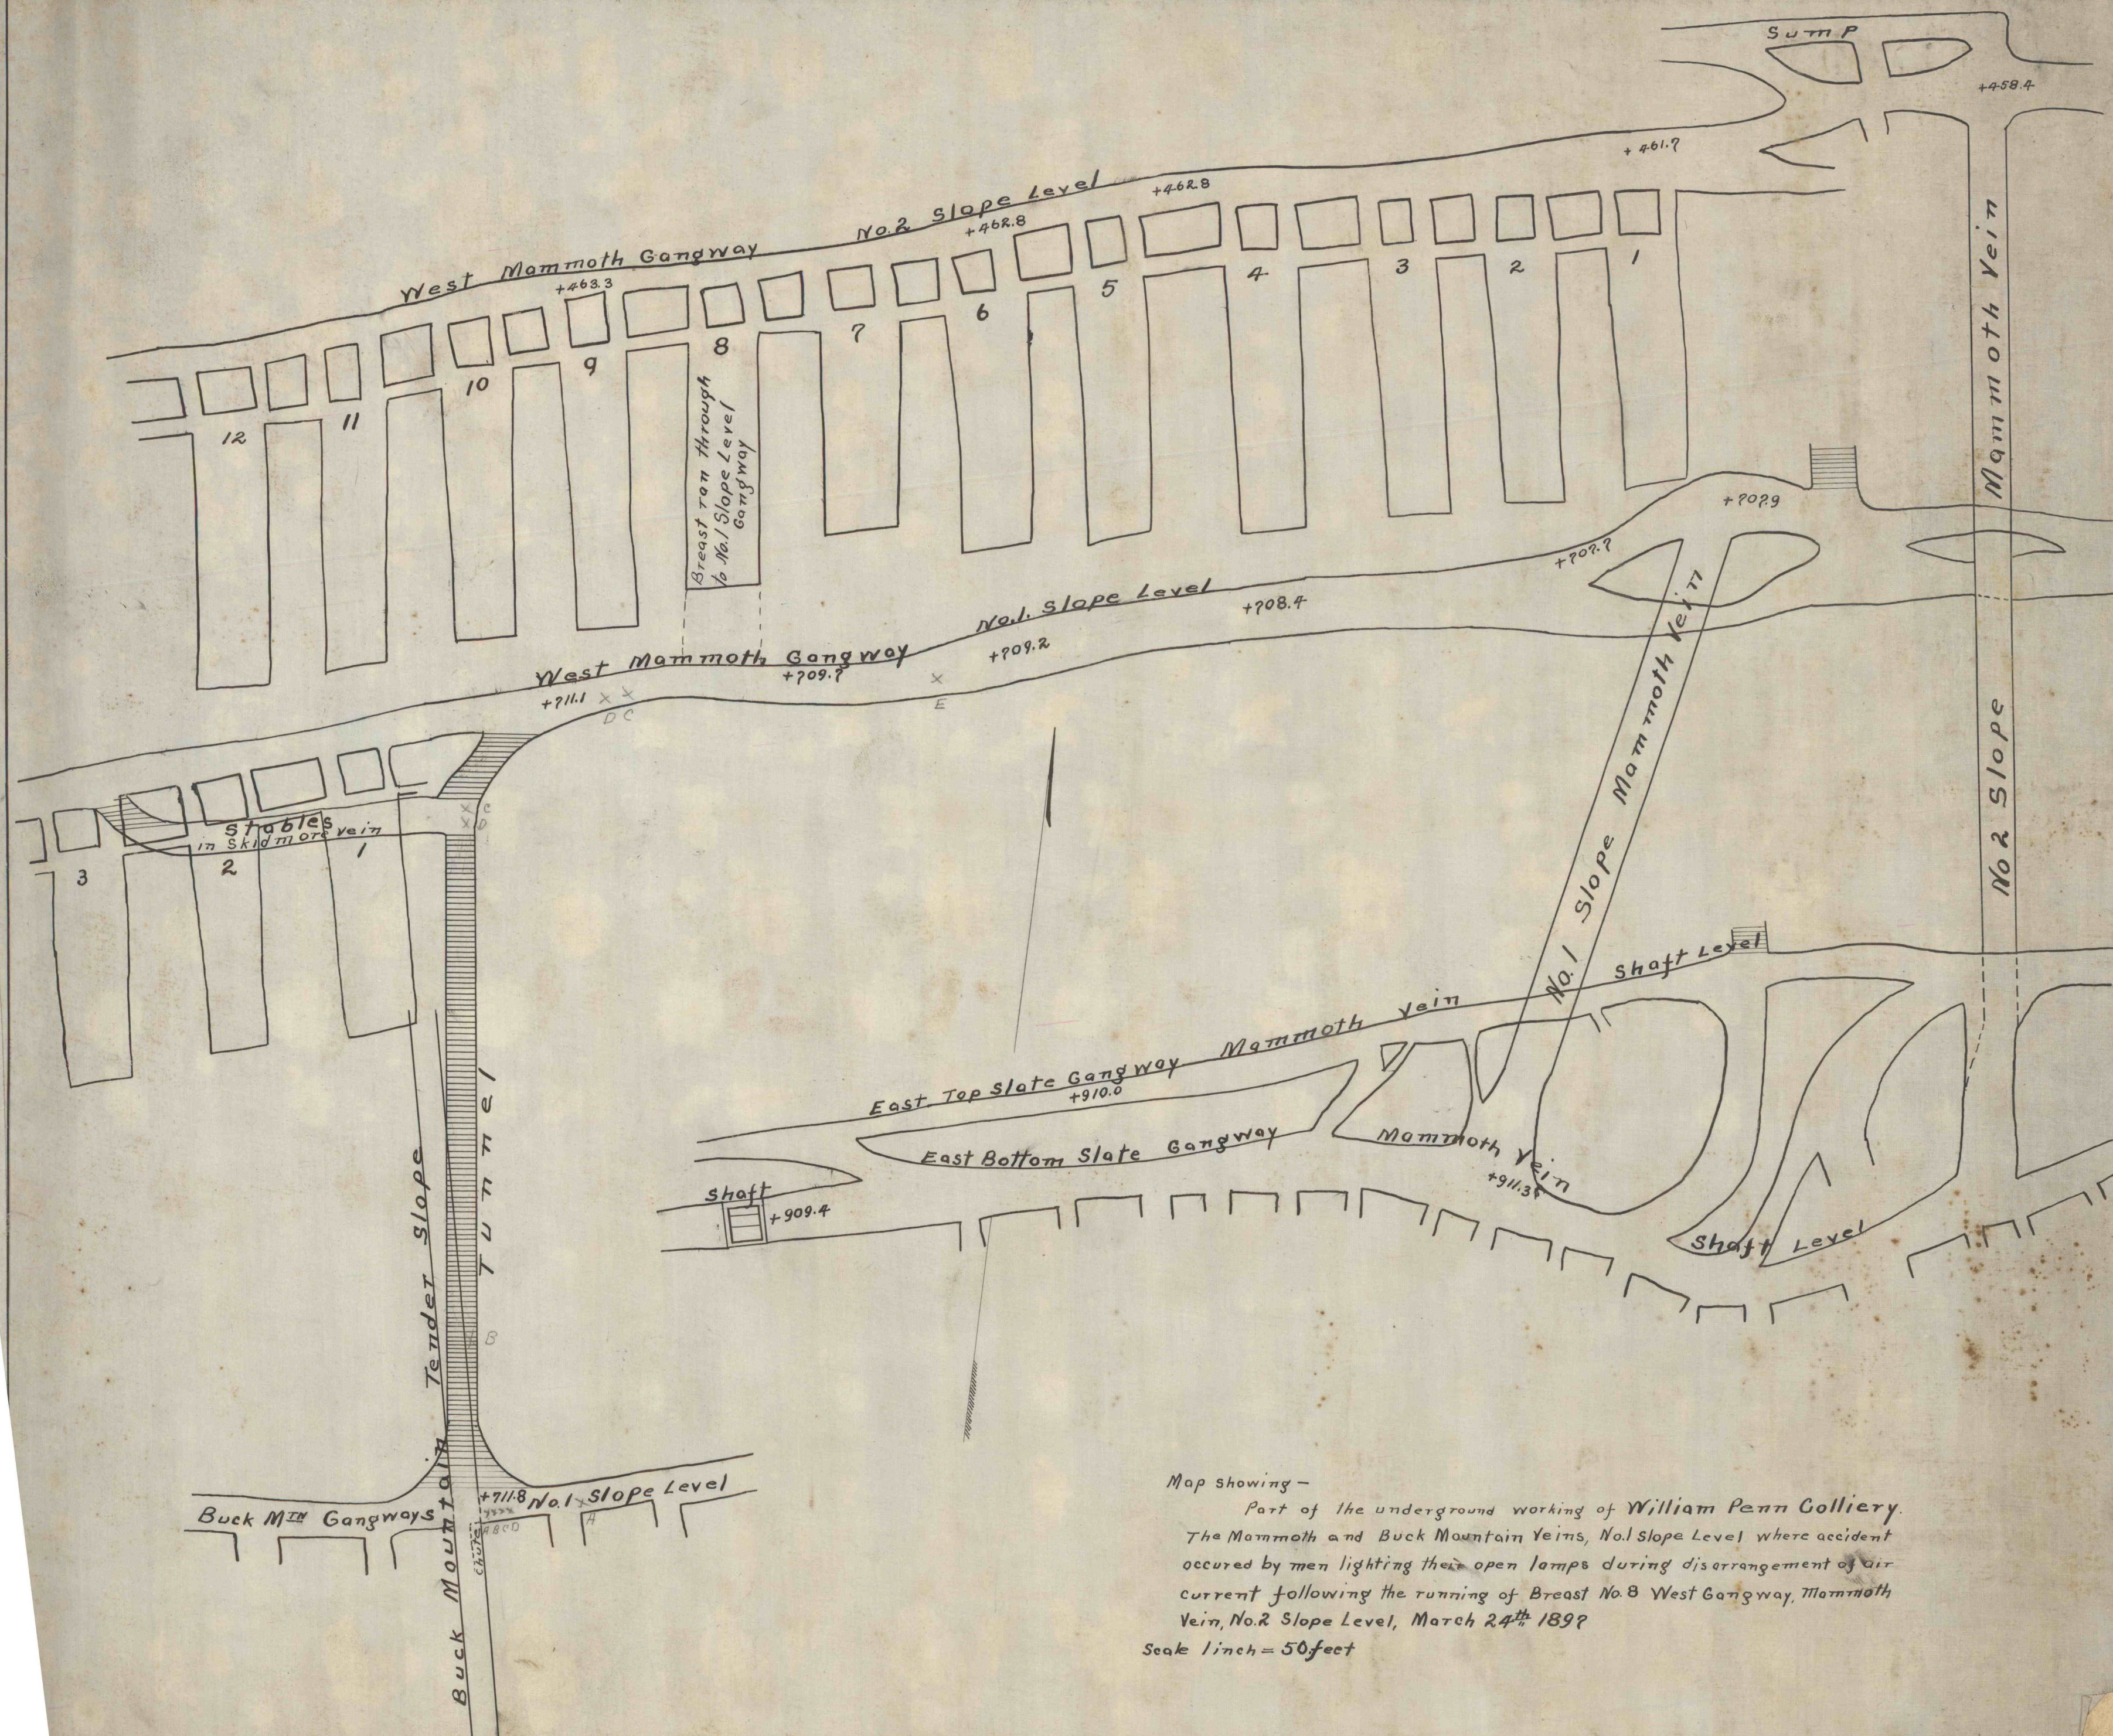

Map showing -
 Part of the underground working of William Penn Colliery.
 The Mammoth and Buck Mountain Veins, No. 1 Slope Level where accident
 occurred by men lighting their open lamps during disarrangement of air
 current following the running of Breast No. 8 West Gangway, Mammoth
 Vein, No. 2 Slope Level, March 24th 1897
 Scale 1 inch = 50 feet