


Looking East East

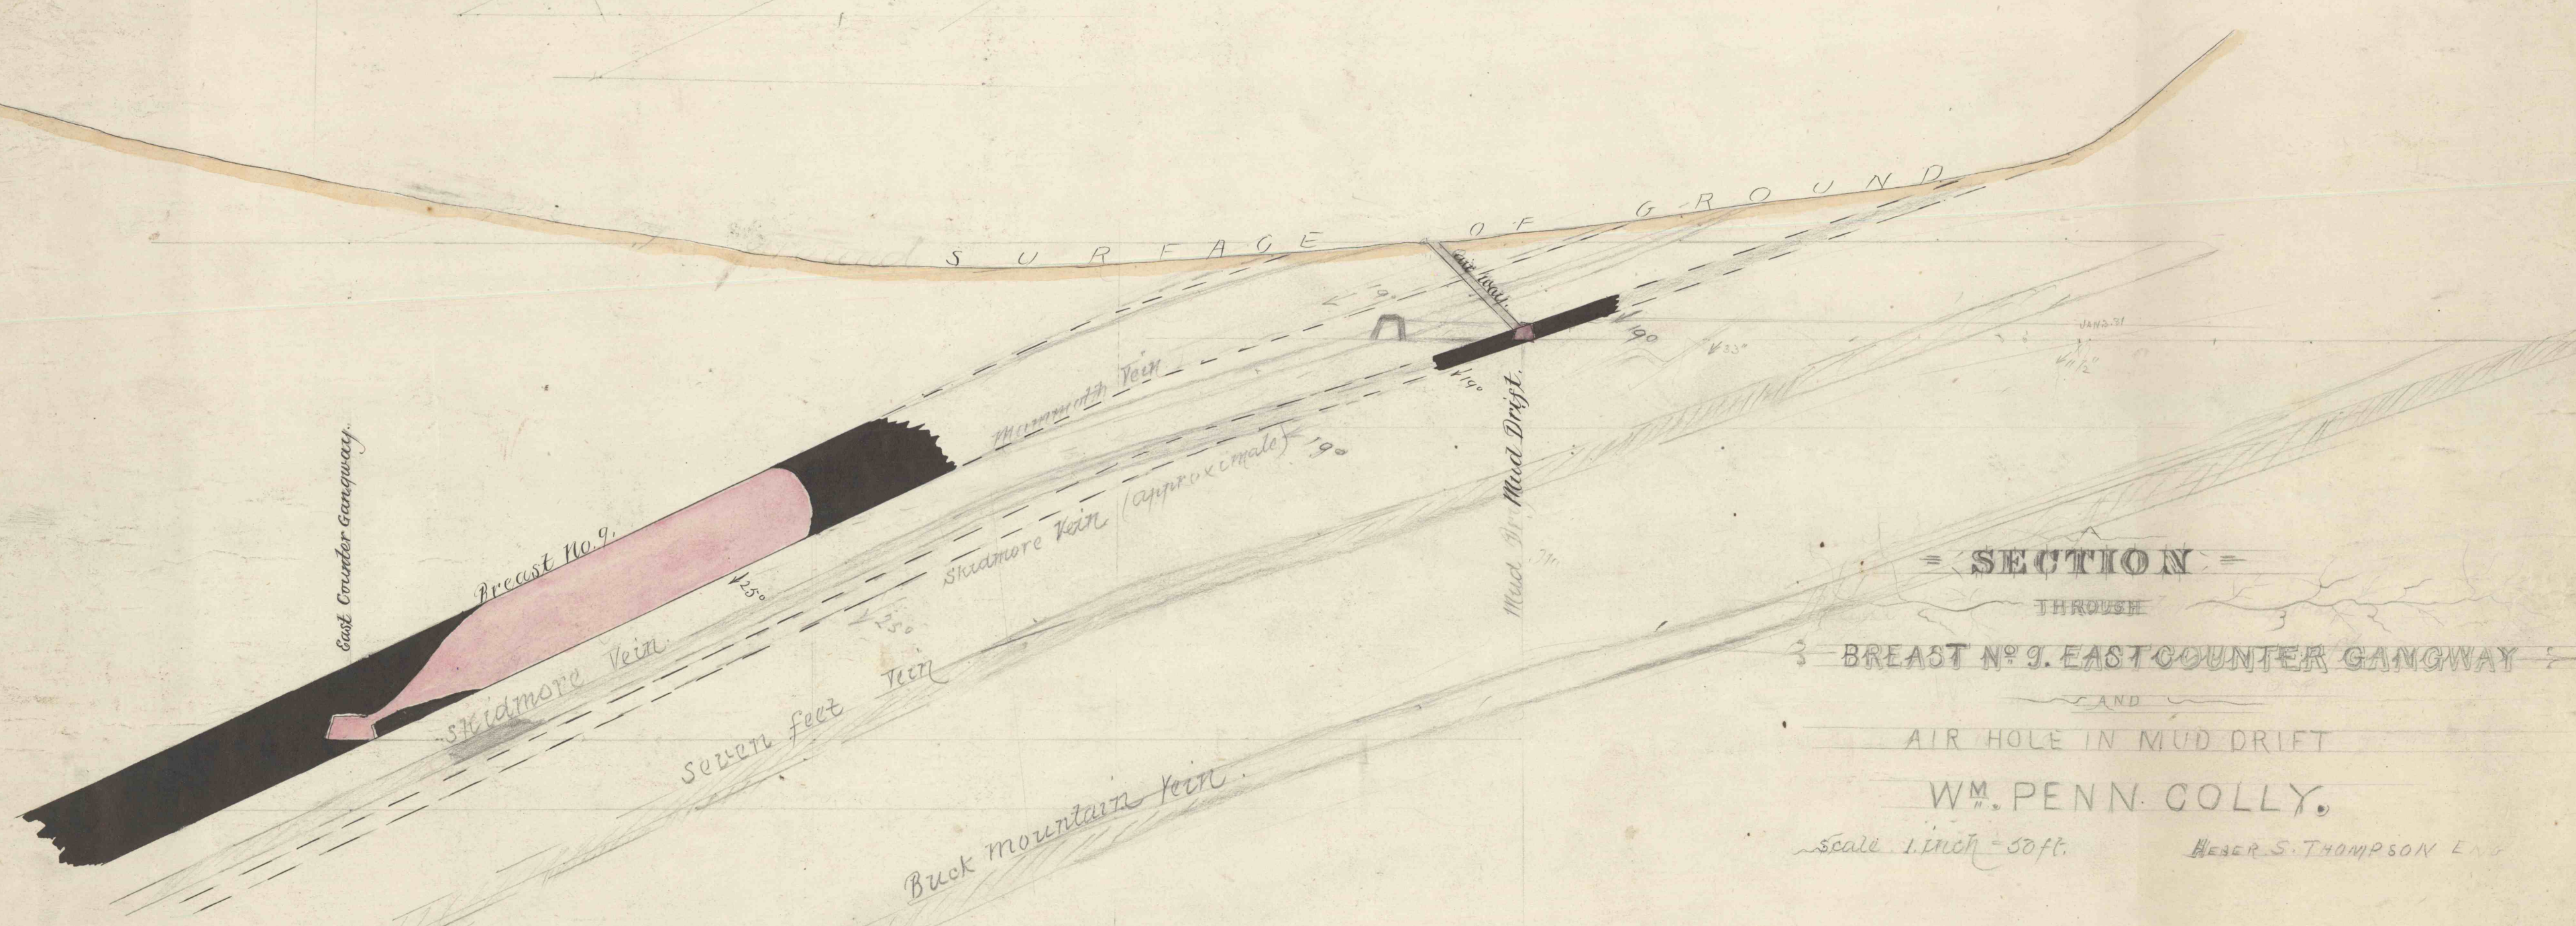

(SCALE OF SECTIONS 1 INCH = 40 FEET)

WM. PENN. COLLY.	W. SHENANDOAH COLLY.	PLANK RIDGE COLLY.	INDIAN RIDGE COLLY.	KEHLEY'S RUN COLLY.
Section of Vein Cut in Mud Drift.	Section of Skidmore Vein.	Section of Skidmore Vein.	Section of Skidmore Vein.	Section of Skidmore Vein.
COAL 1'0"	COAL 0'9"	COAL 0'6"	COAL 0'6"	COAL 2'0"
SLATE 0'10"	SLATE 1'5"	SLATE 1'0"	SLATE 0'10"	SLATE 1'6"
COAL 3'3"	COAL 3'4"	COAL 5'6"	COAL 7'0"	COAL 10'0"
TOTAL 5'3"	TOTAL 5'6"	TOTAL 7'0"	TOTAL 8'4"	TOTAL 13'6"
Distance to Mammoth Vein 15 feet.	Distance to Mammoth Vein 25 feet.	Distance to Mammoth Vein 20 feet.	Distance to Mammoth Vein 20 feet.	Distance to Mammoth Vein 10 feet.

10' = 1"