
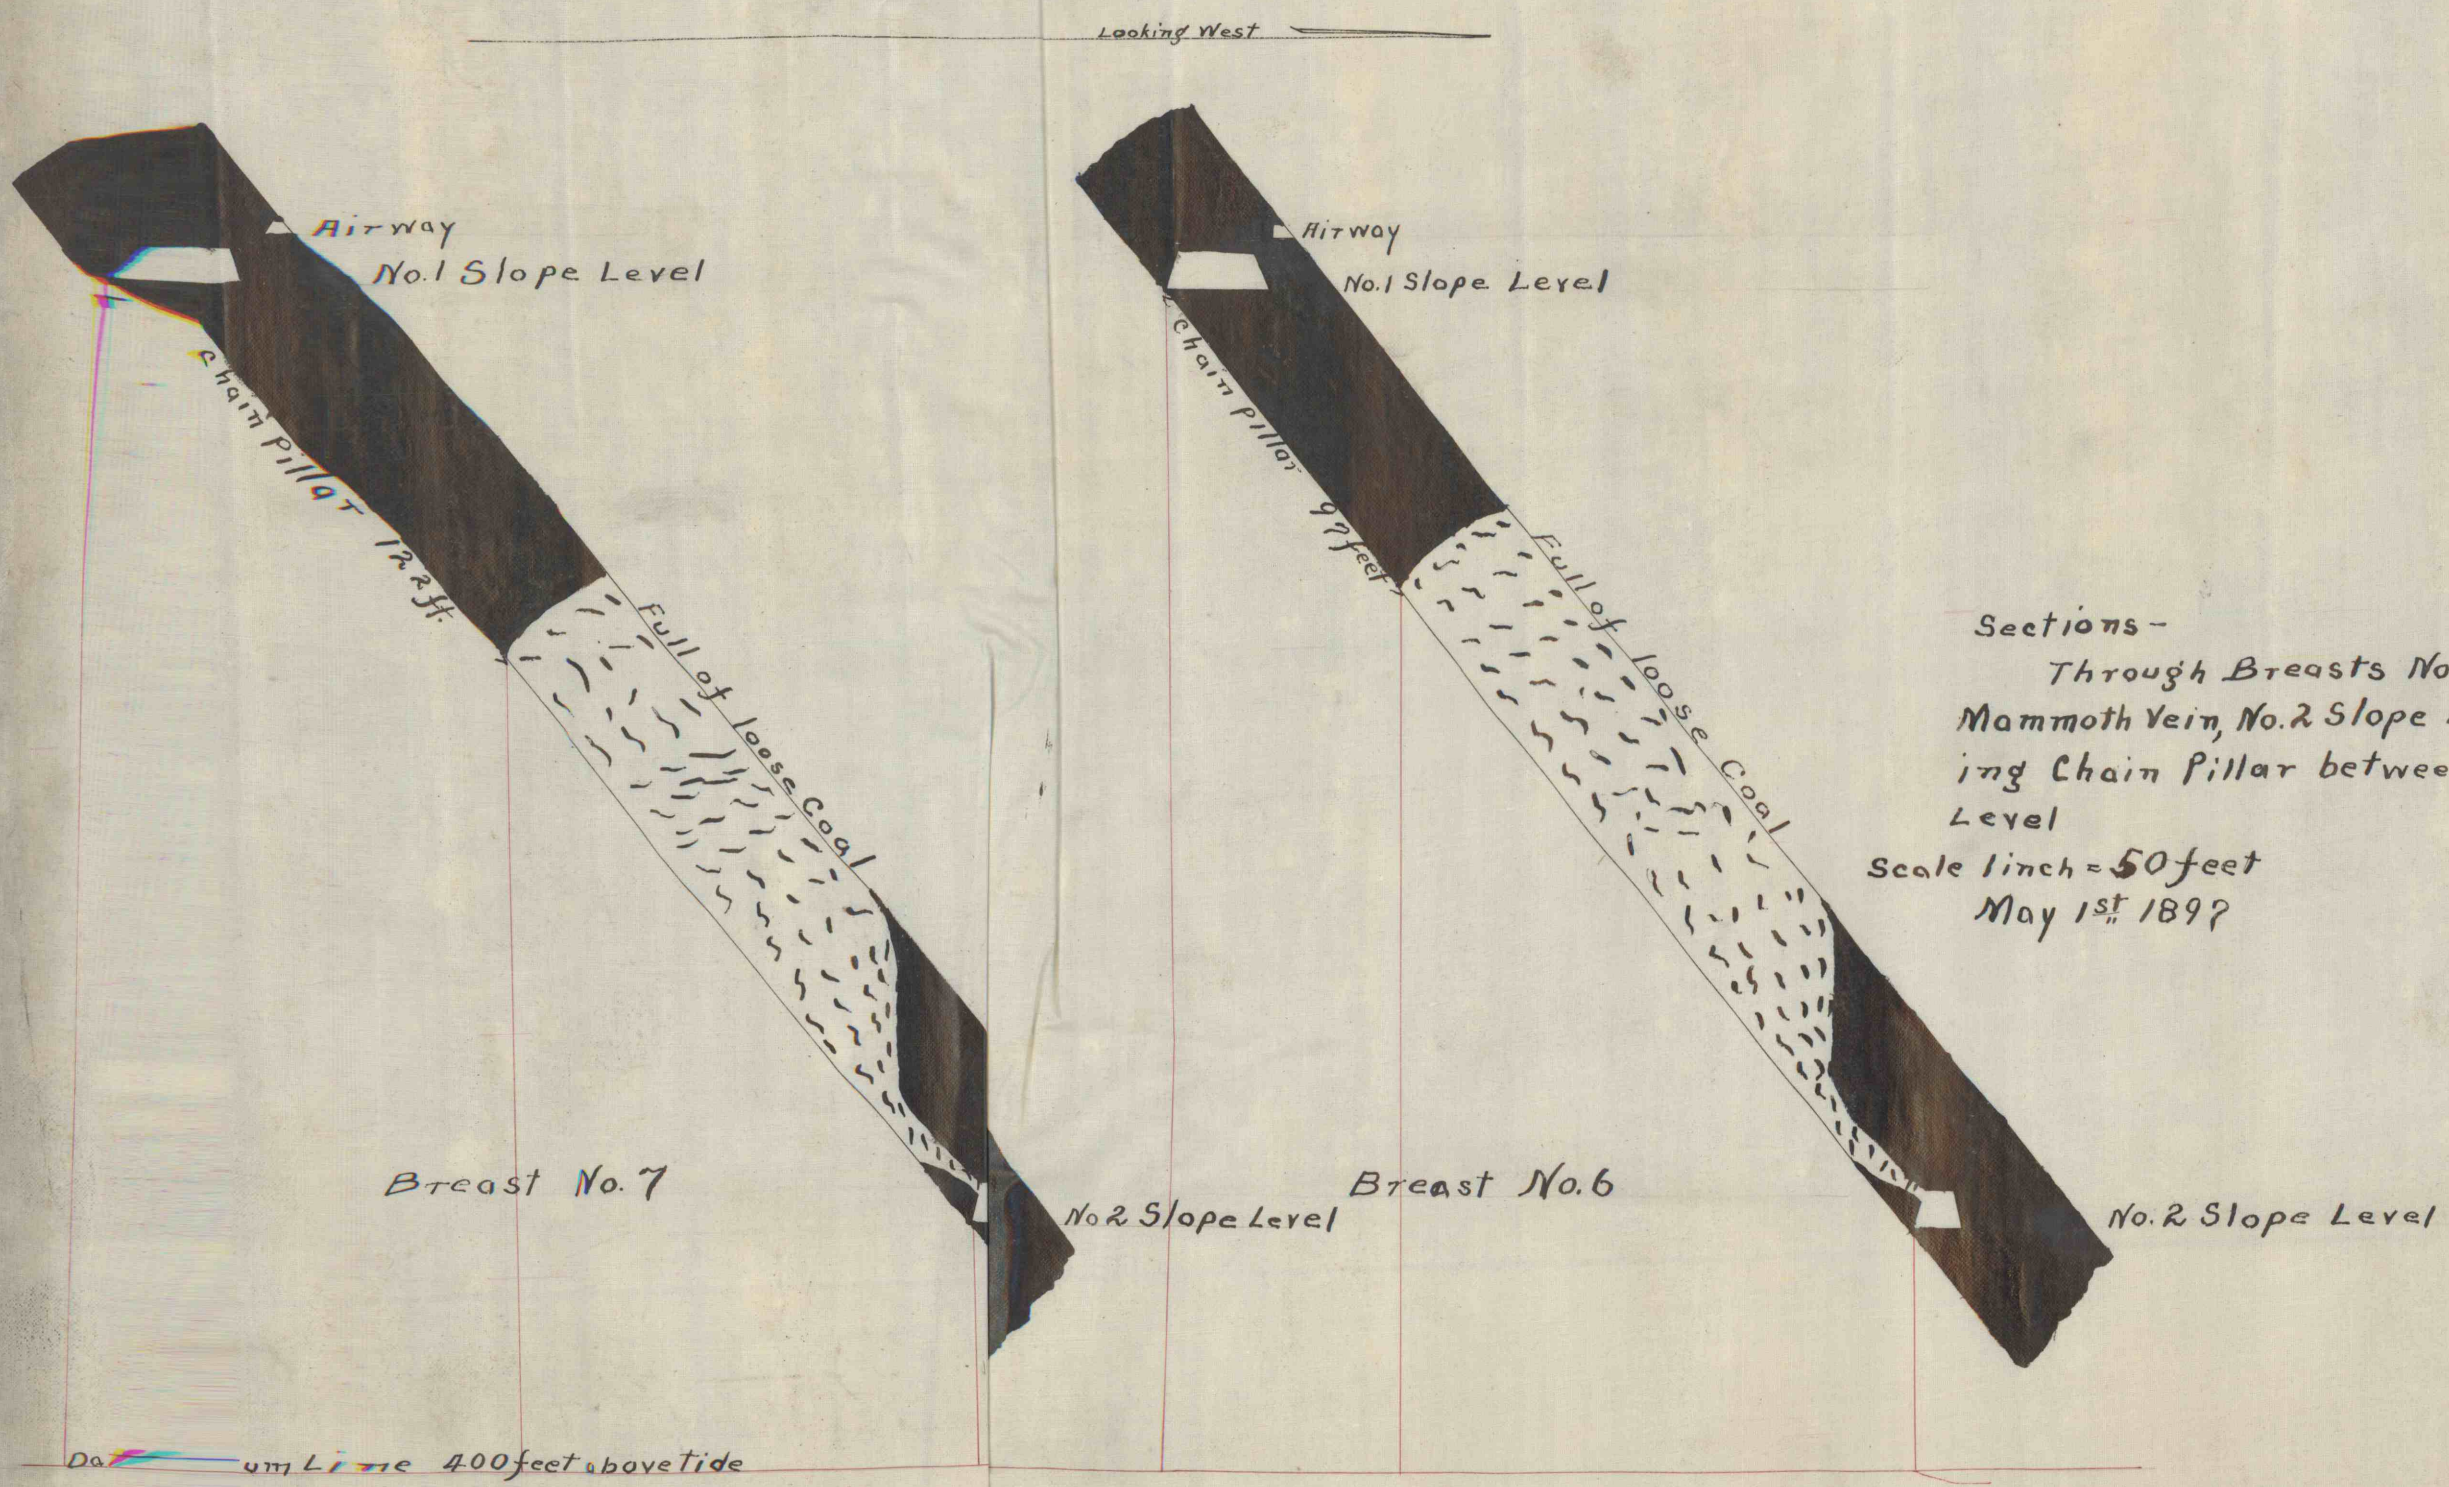


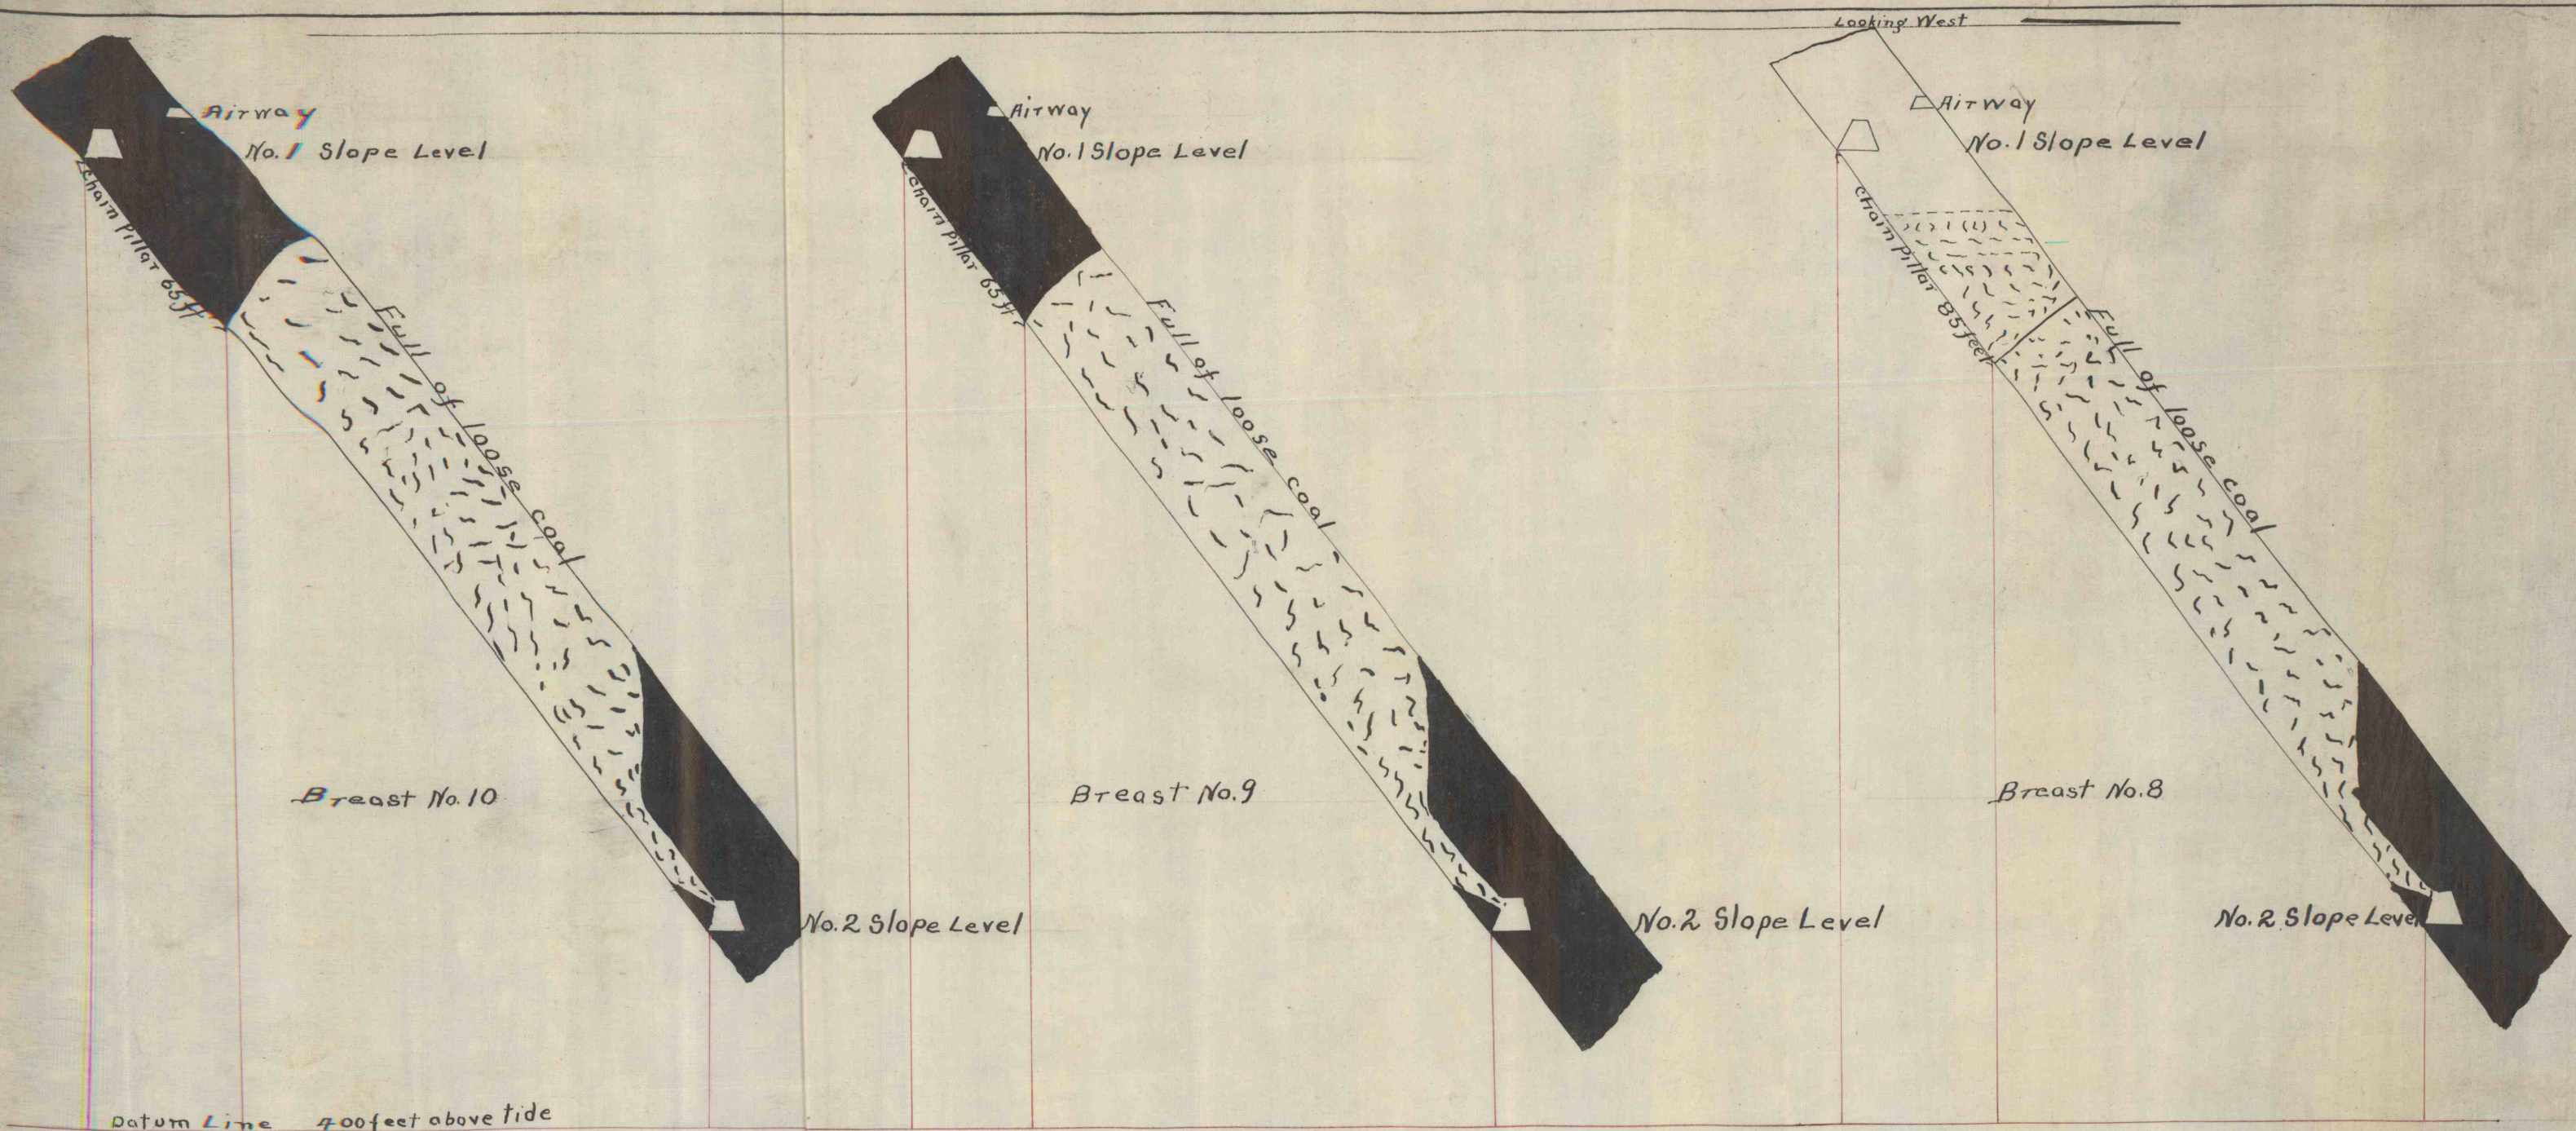

Sections -
Through Breasts Nos. 6-7-8-9-10 on the East Gangway,
Mammoth Vein, No. 2 Slope Level at W^m Penn Colliery; Show-
ing Chain Pillar between faces of breasts and No. 1 Slope
Level
Scale 1 inch = 50 feet
May 1st 1892