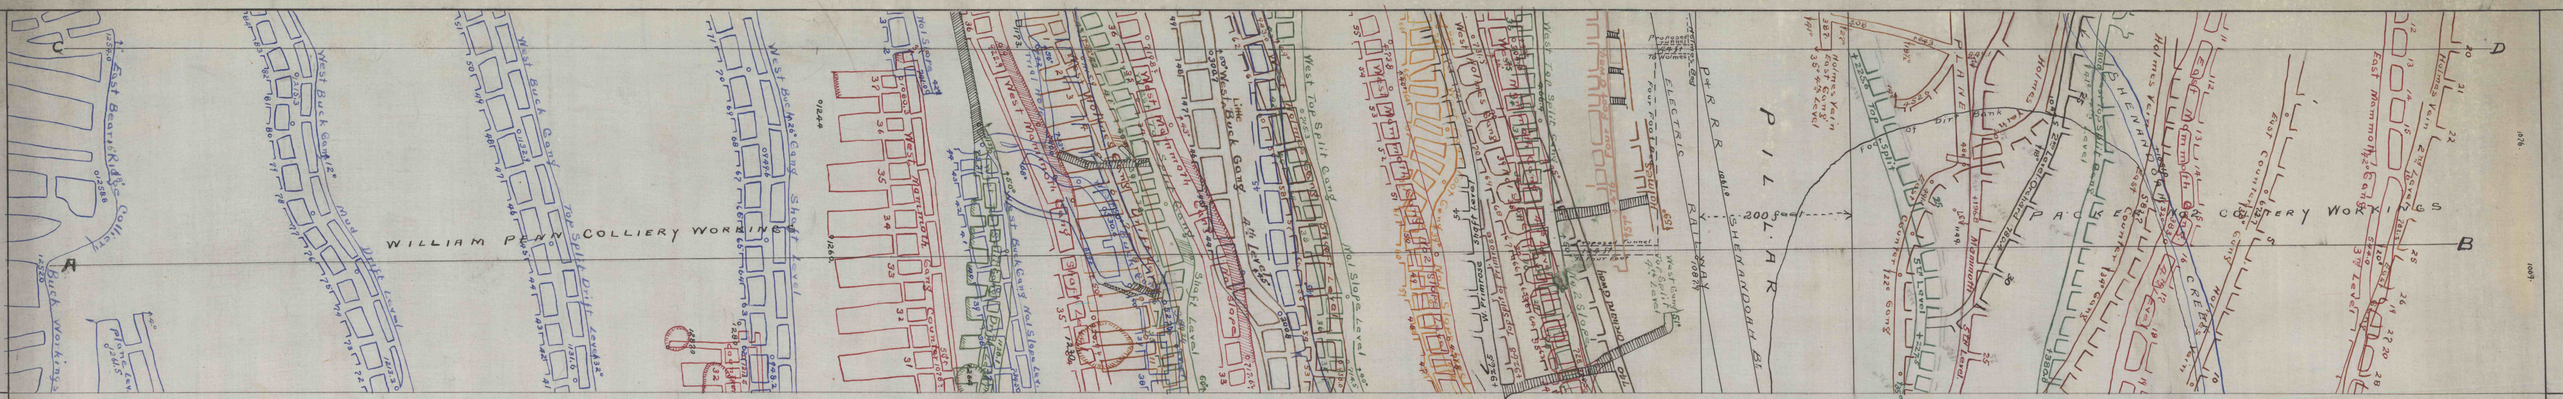

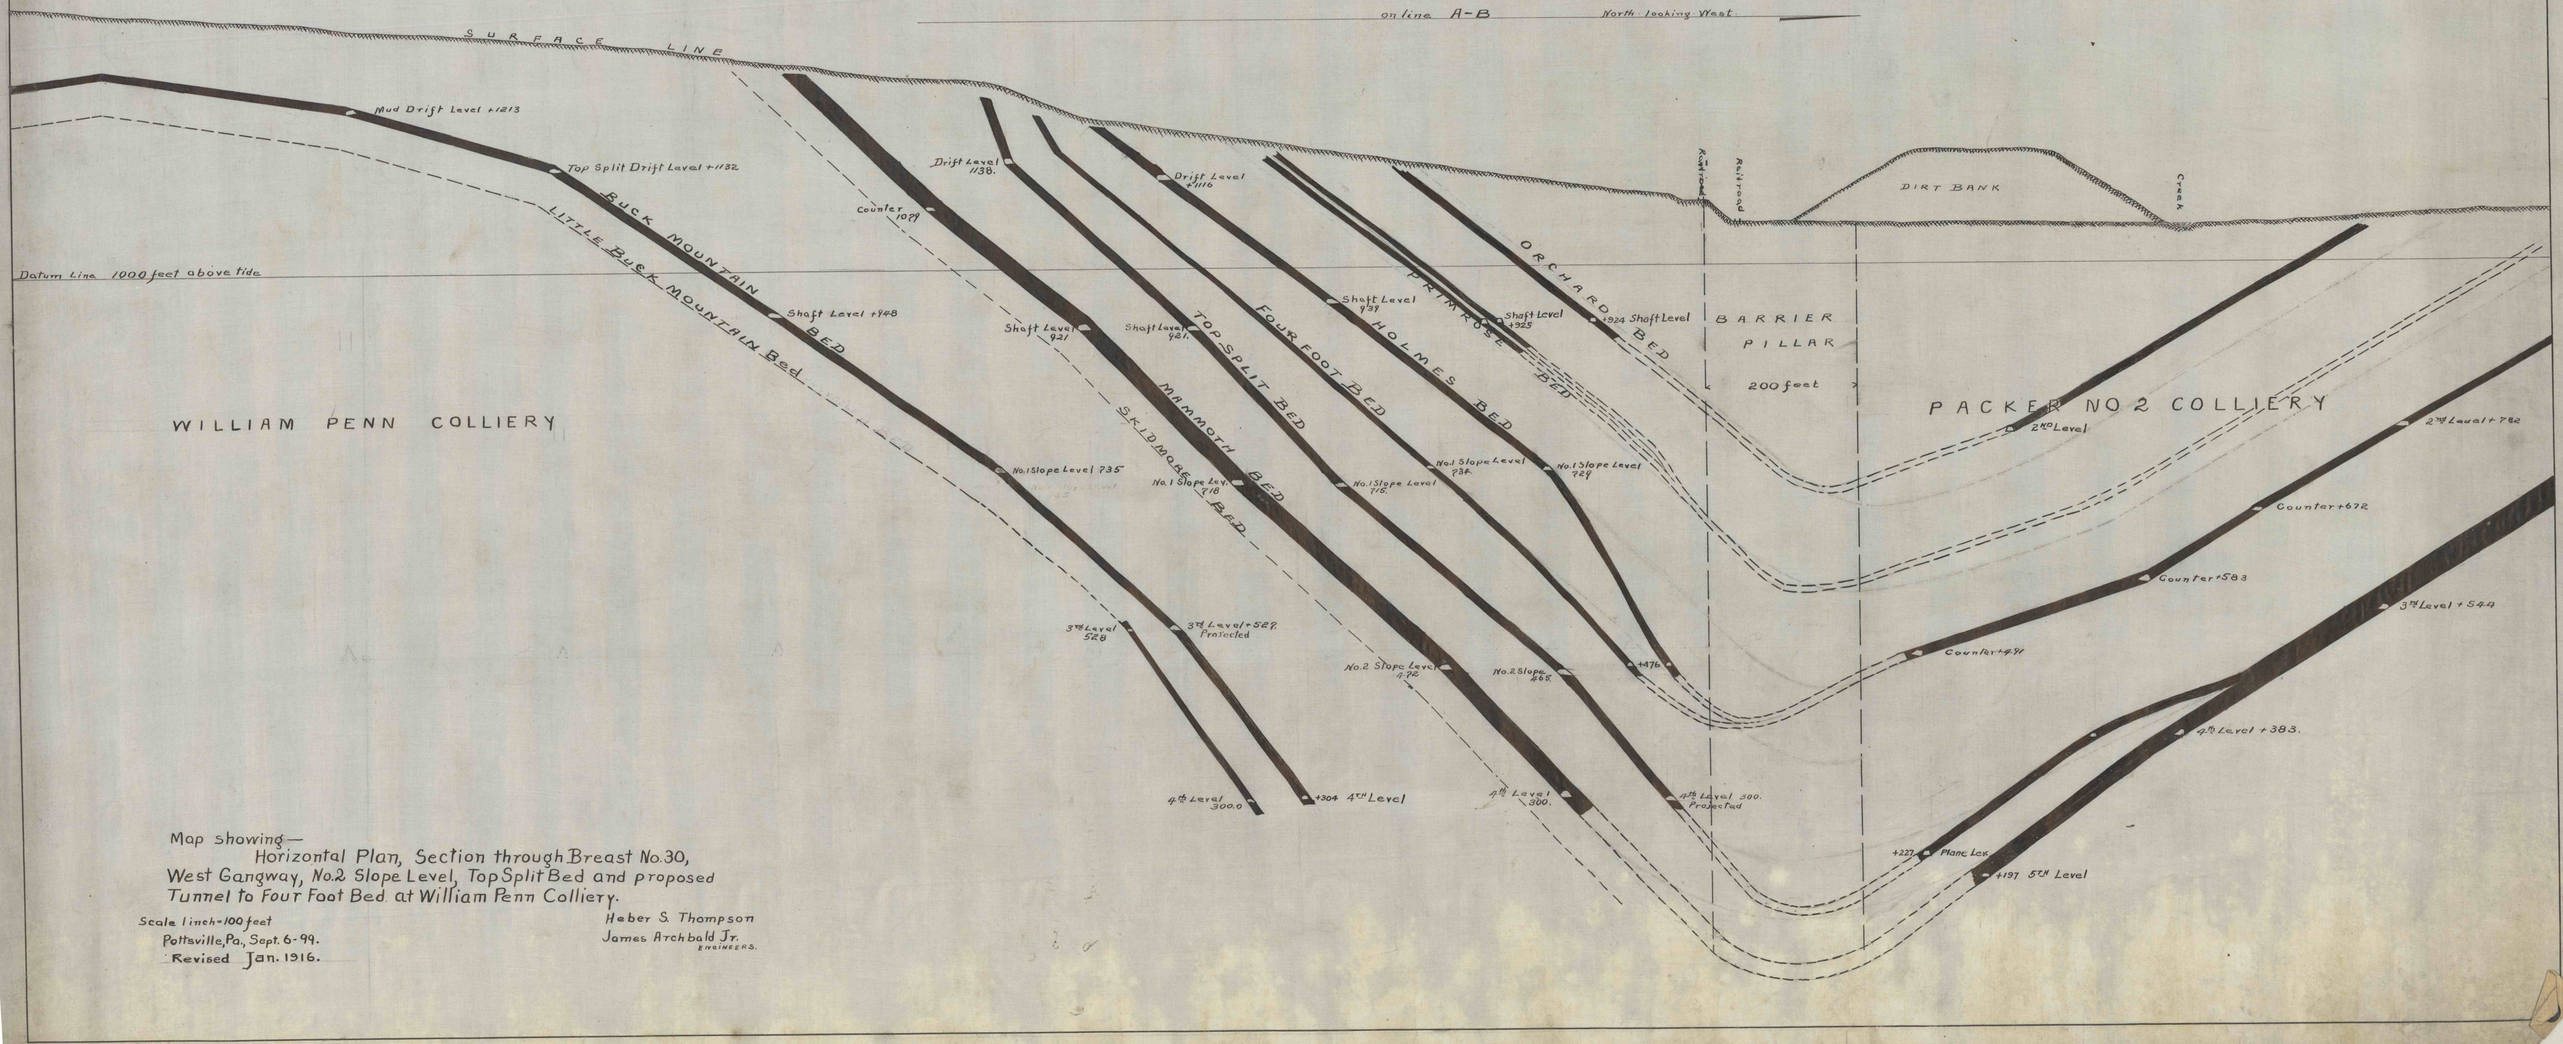

Map showing—
Horizontal Plan, Section through Breast No. 30, West Gangway, No. 2 Slope Level, Top Split Bed and proposed Tunnel to Four Foot Bed at William Penn Colliery.

Scale 1 inch = 100 feet
Pottsville, Pa., Sept. 6-99.
Revised Jan. 1916.

Heber S. Thompson
James Archbald Jr.
ENGINEERS.