

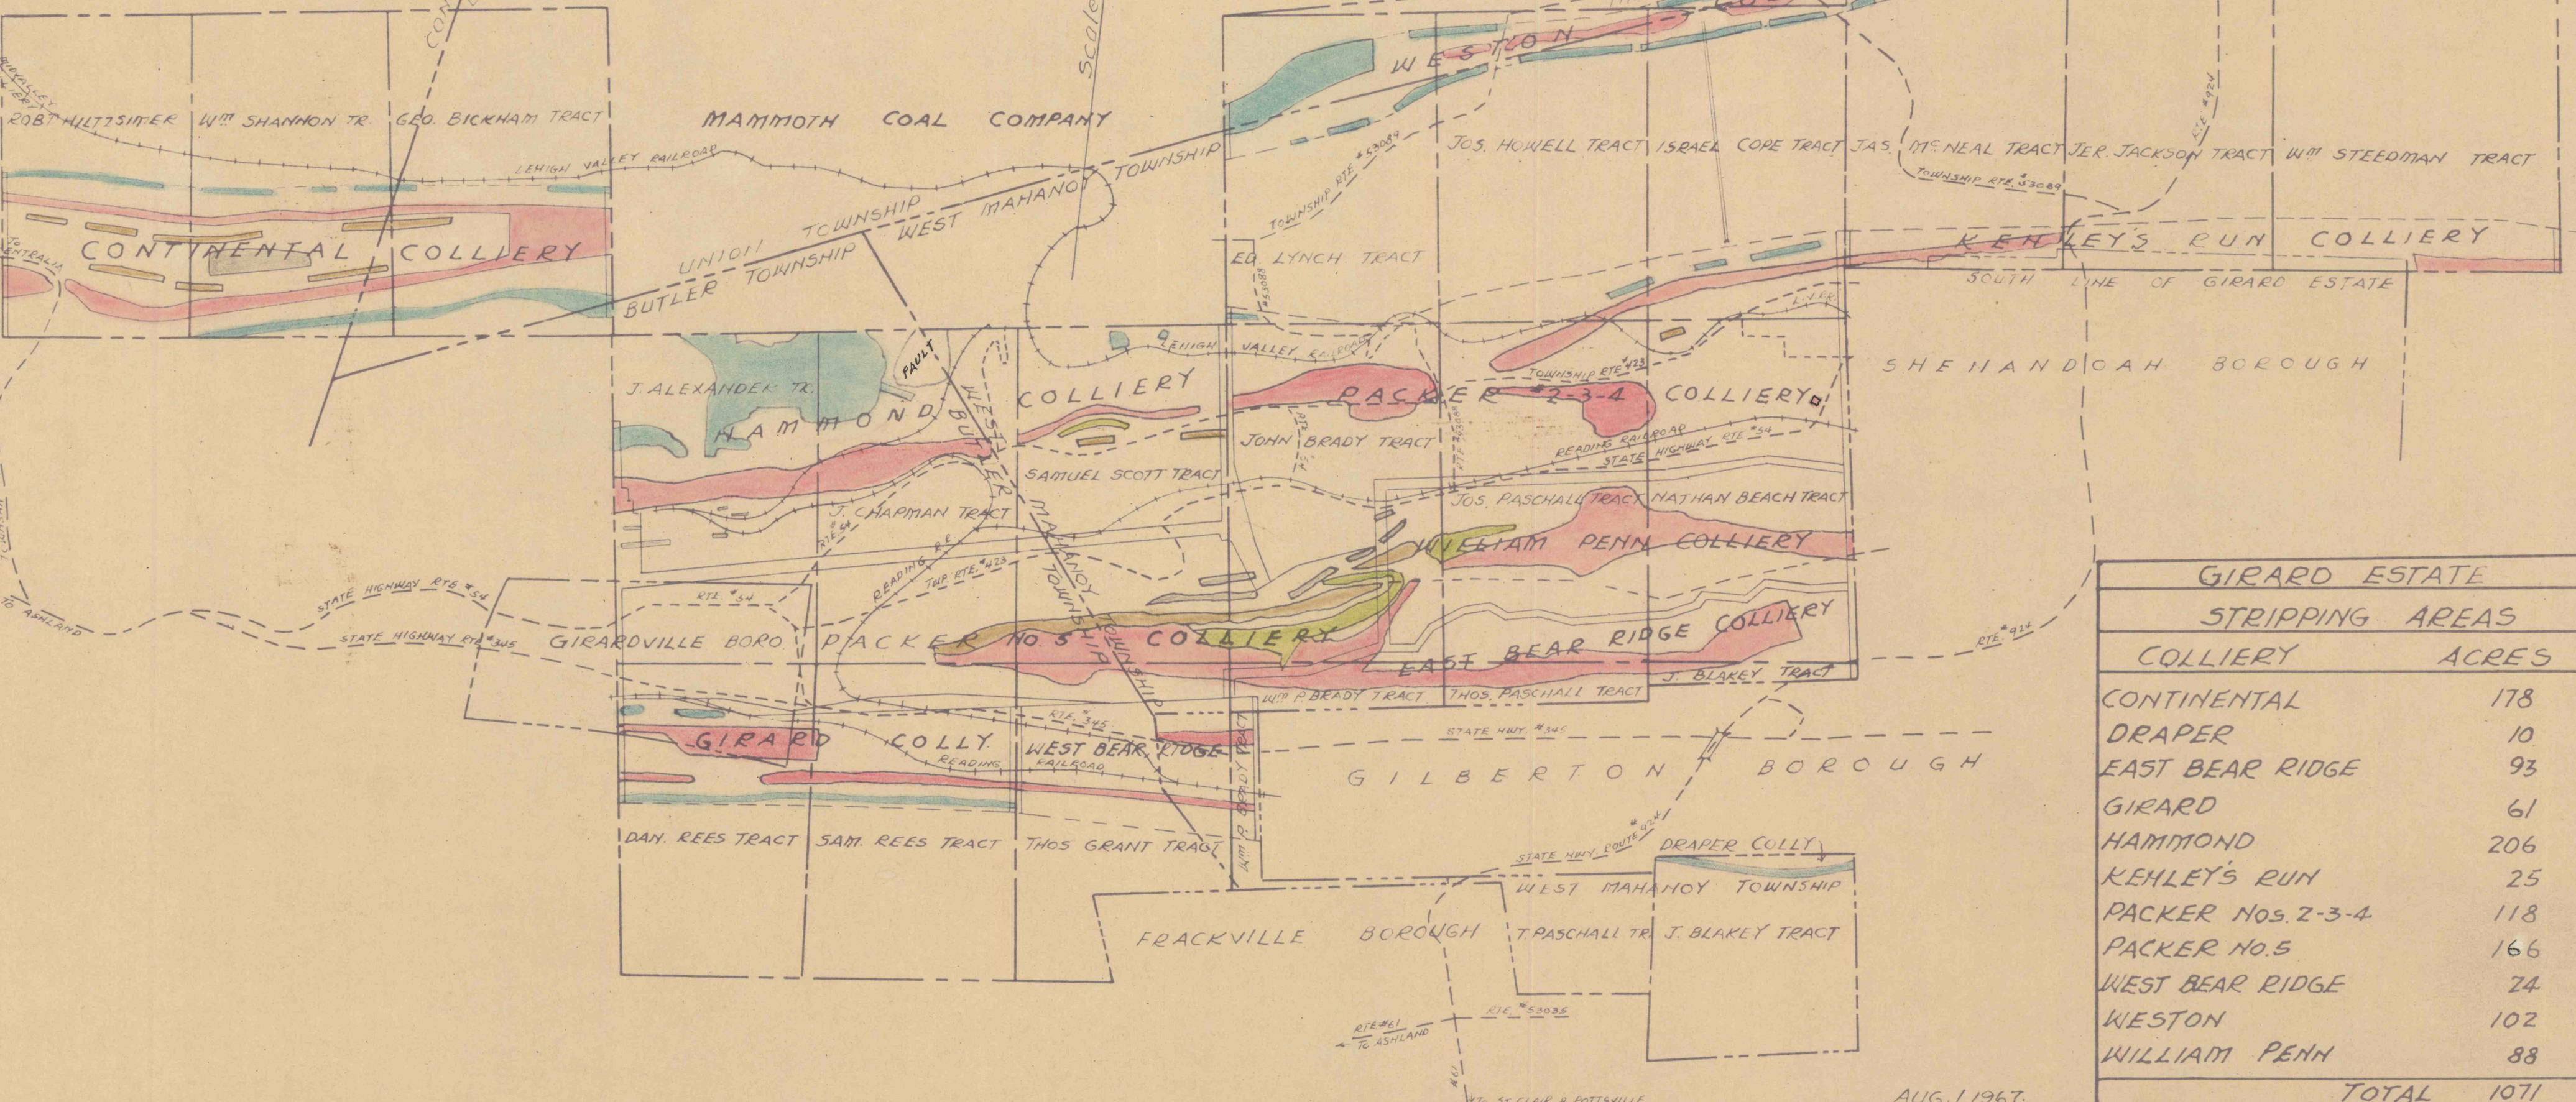
COLUMBIA COUNTY

SCHUYLKILL COUNTY

COUNTY

CONYNGHAM TOWNSHIP
UNION TOWNSHIP

SCALE 1"=2000'

UNION TOWNSHIP
W. MAHANOT TWP.

GIRARD ESTATE STRIPPING AREAS	
COLLIERY	ACRES
CONTINENTAL	178
DRAPER	10
EAST BEAR RIDGE	93
GIRARD	61
HAMMOND	206
KEHLEY'S RUN	25
PACKER NOS. 2-3-4	118
PACKER NO. 5	166
WEST BEAR RIDGE	24
WESTON	102
WILLIAM PENN	88
TOTAL	1071

AUG. 1, 1967.