


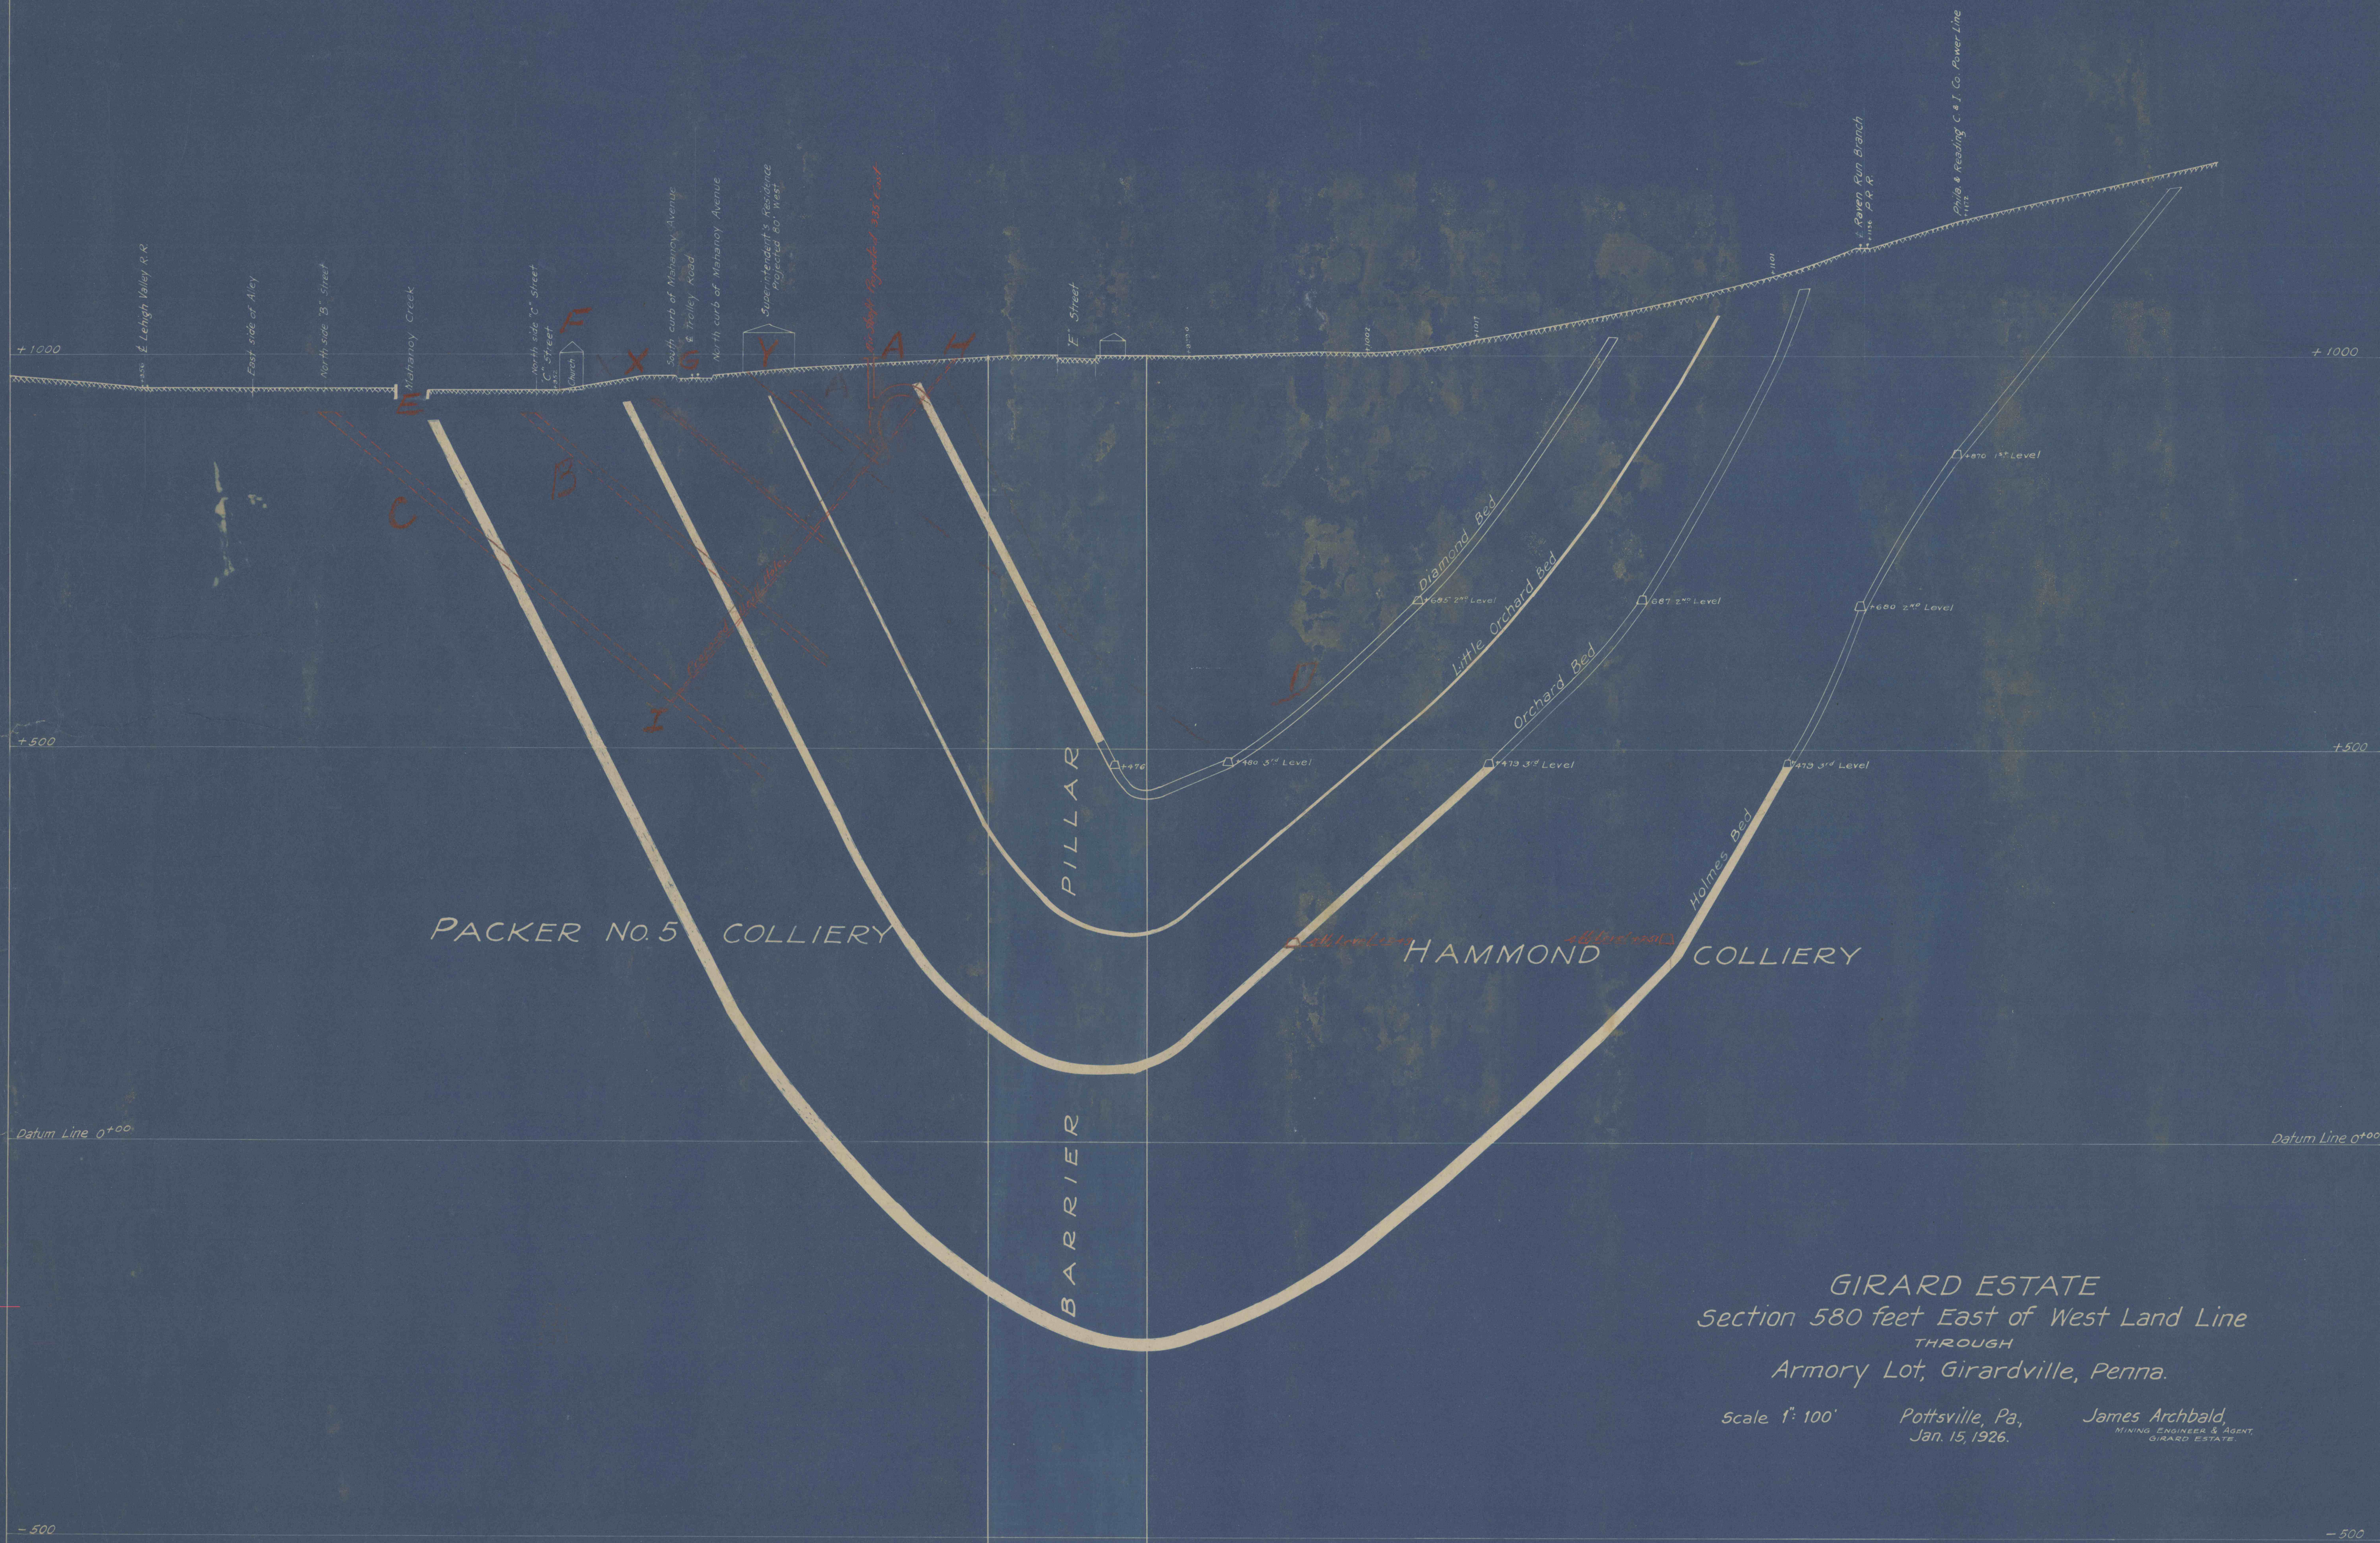

GIRARD ESTATE
Section 580 feet East of West Land Line
THROUGH
Armory Lot, Girardville, Penna.

Scale 1" = 100' Pottsville, Pa, Jan. 15, 1926. James Archbald,
MINING ENGINEER & AGENT,
GIRARD ESTATE