



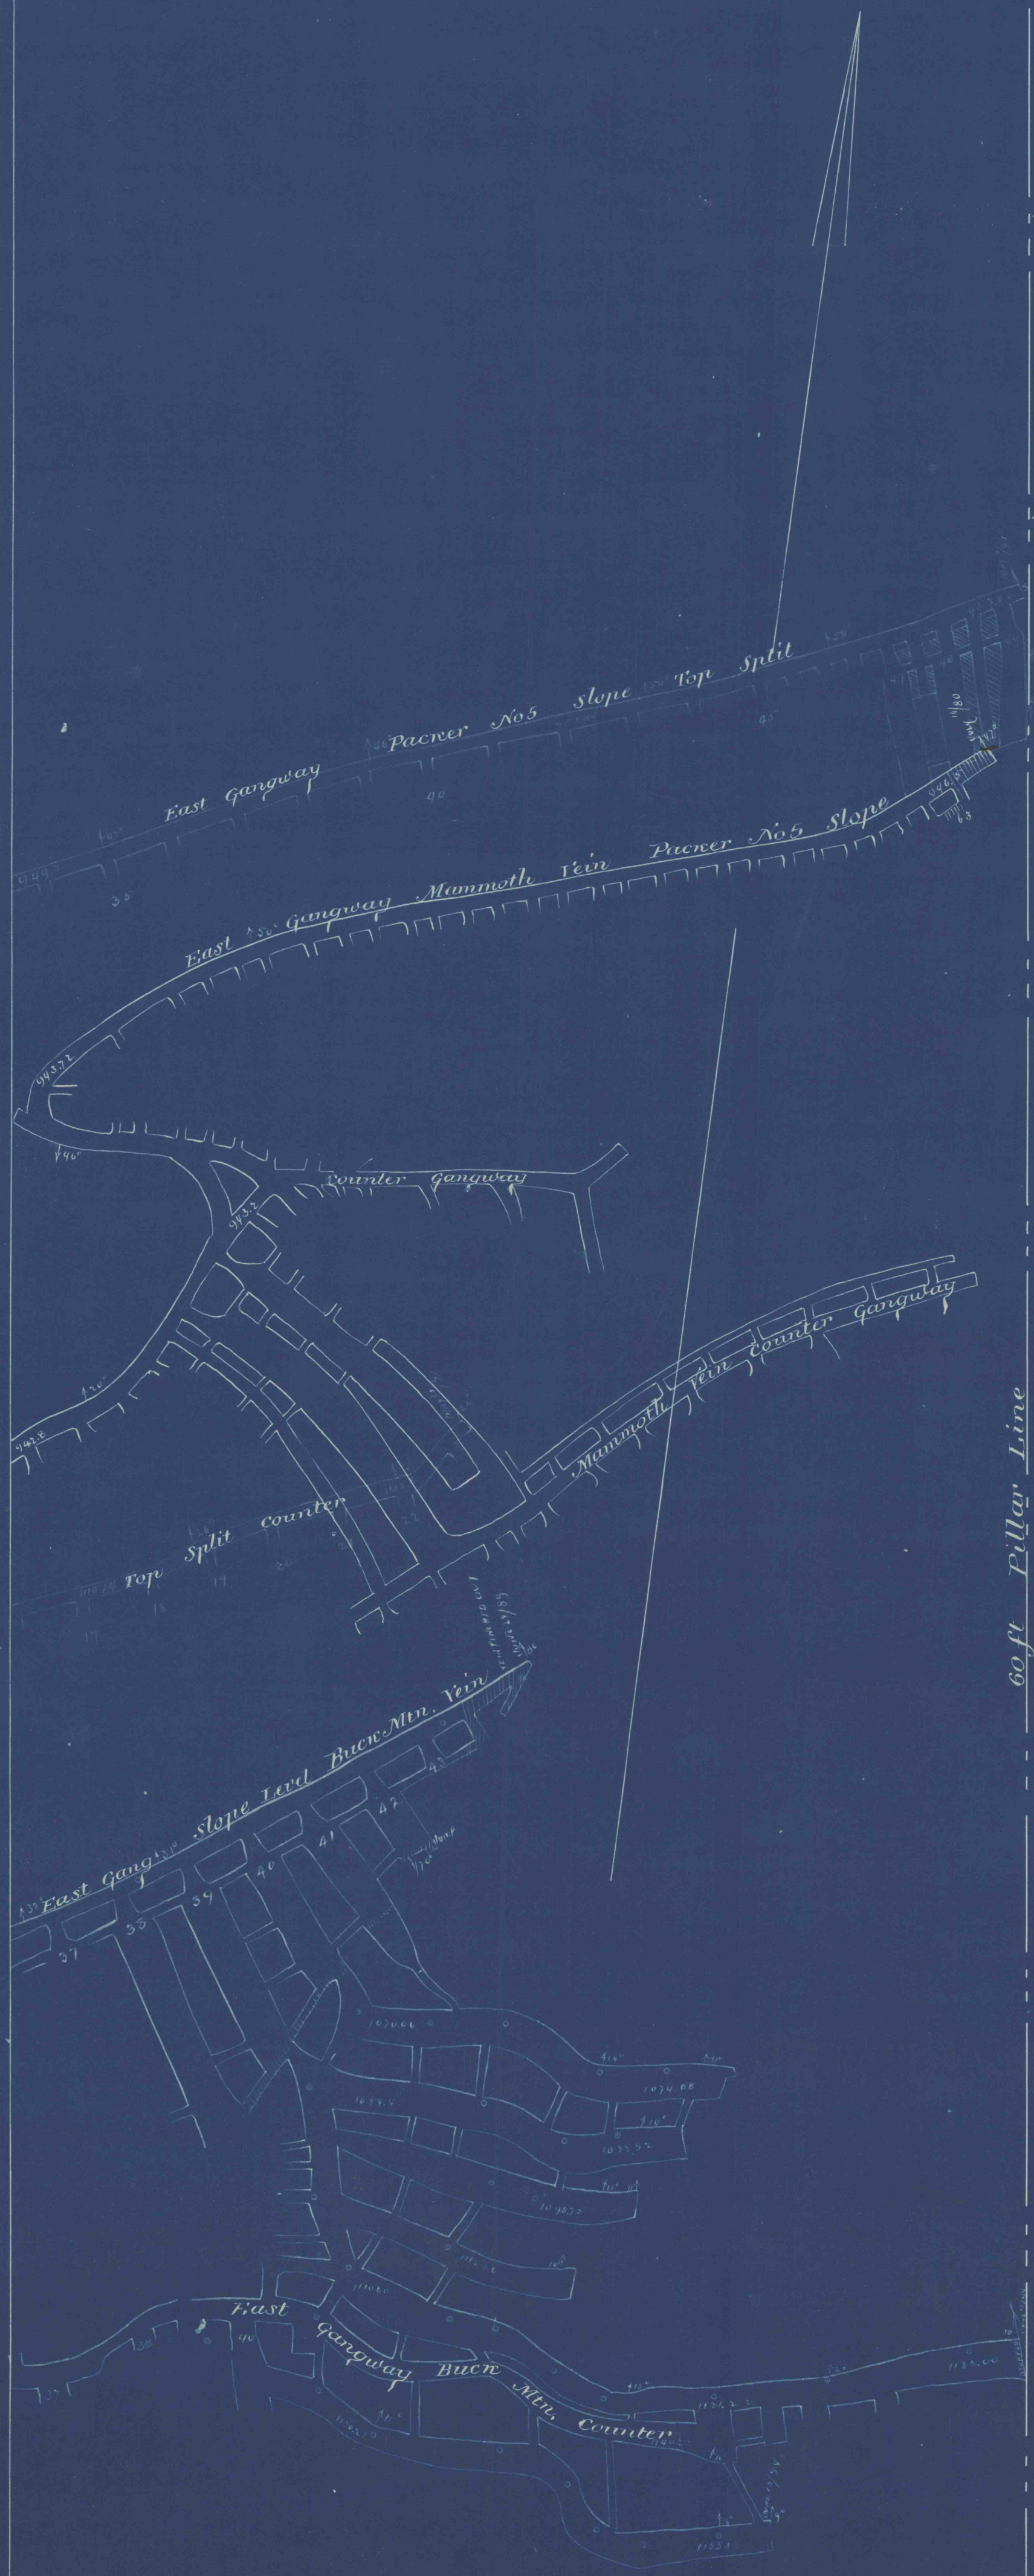

60 ft Pillar Line

Division Line between Packer's Slope Workings and Wm. Penn Mine Workings

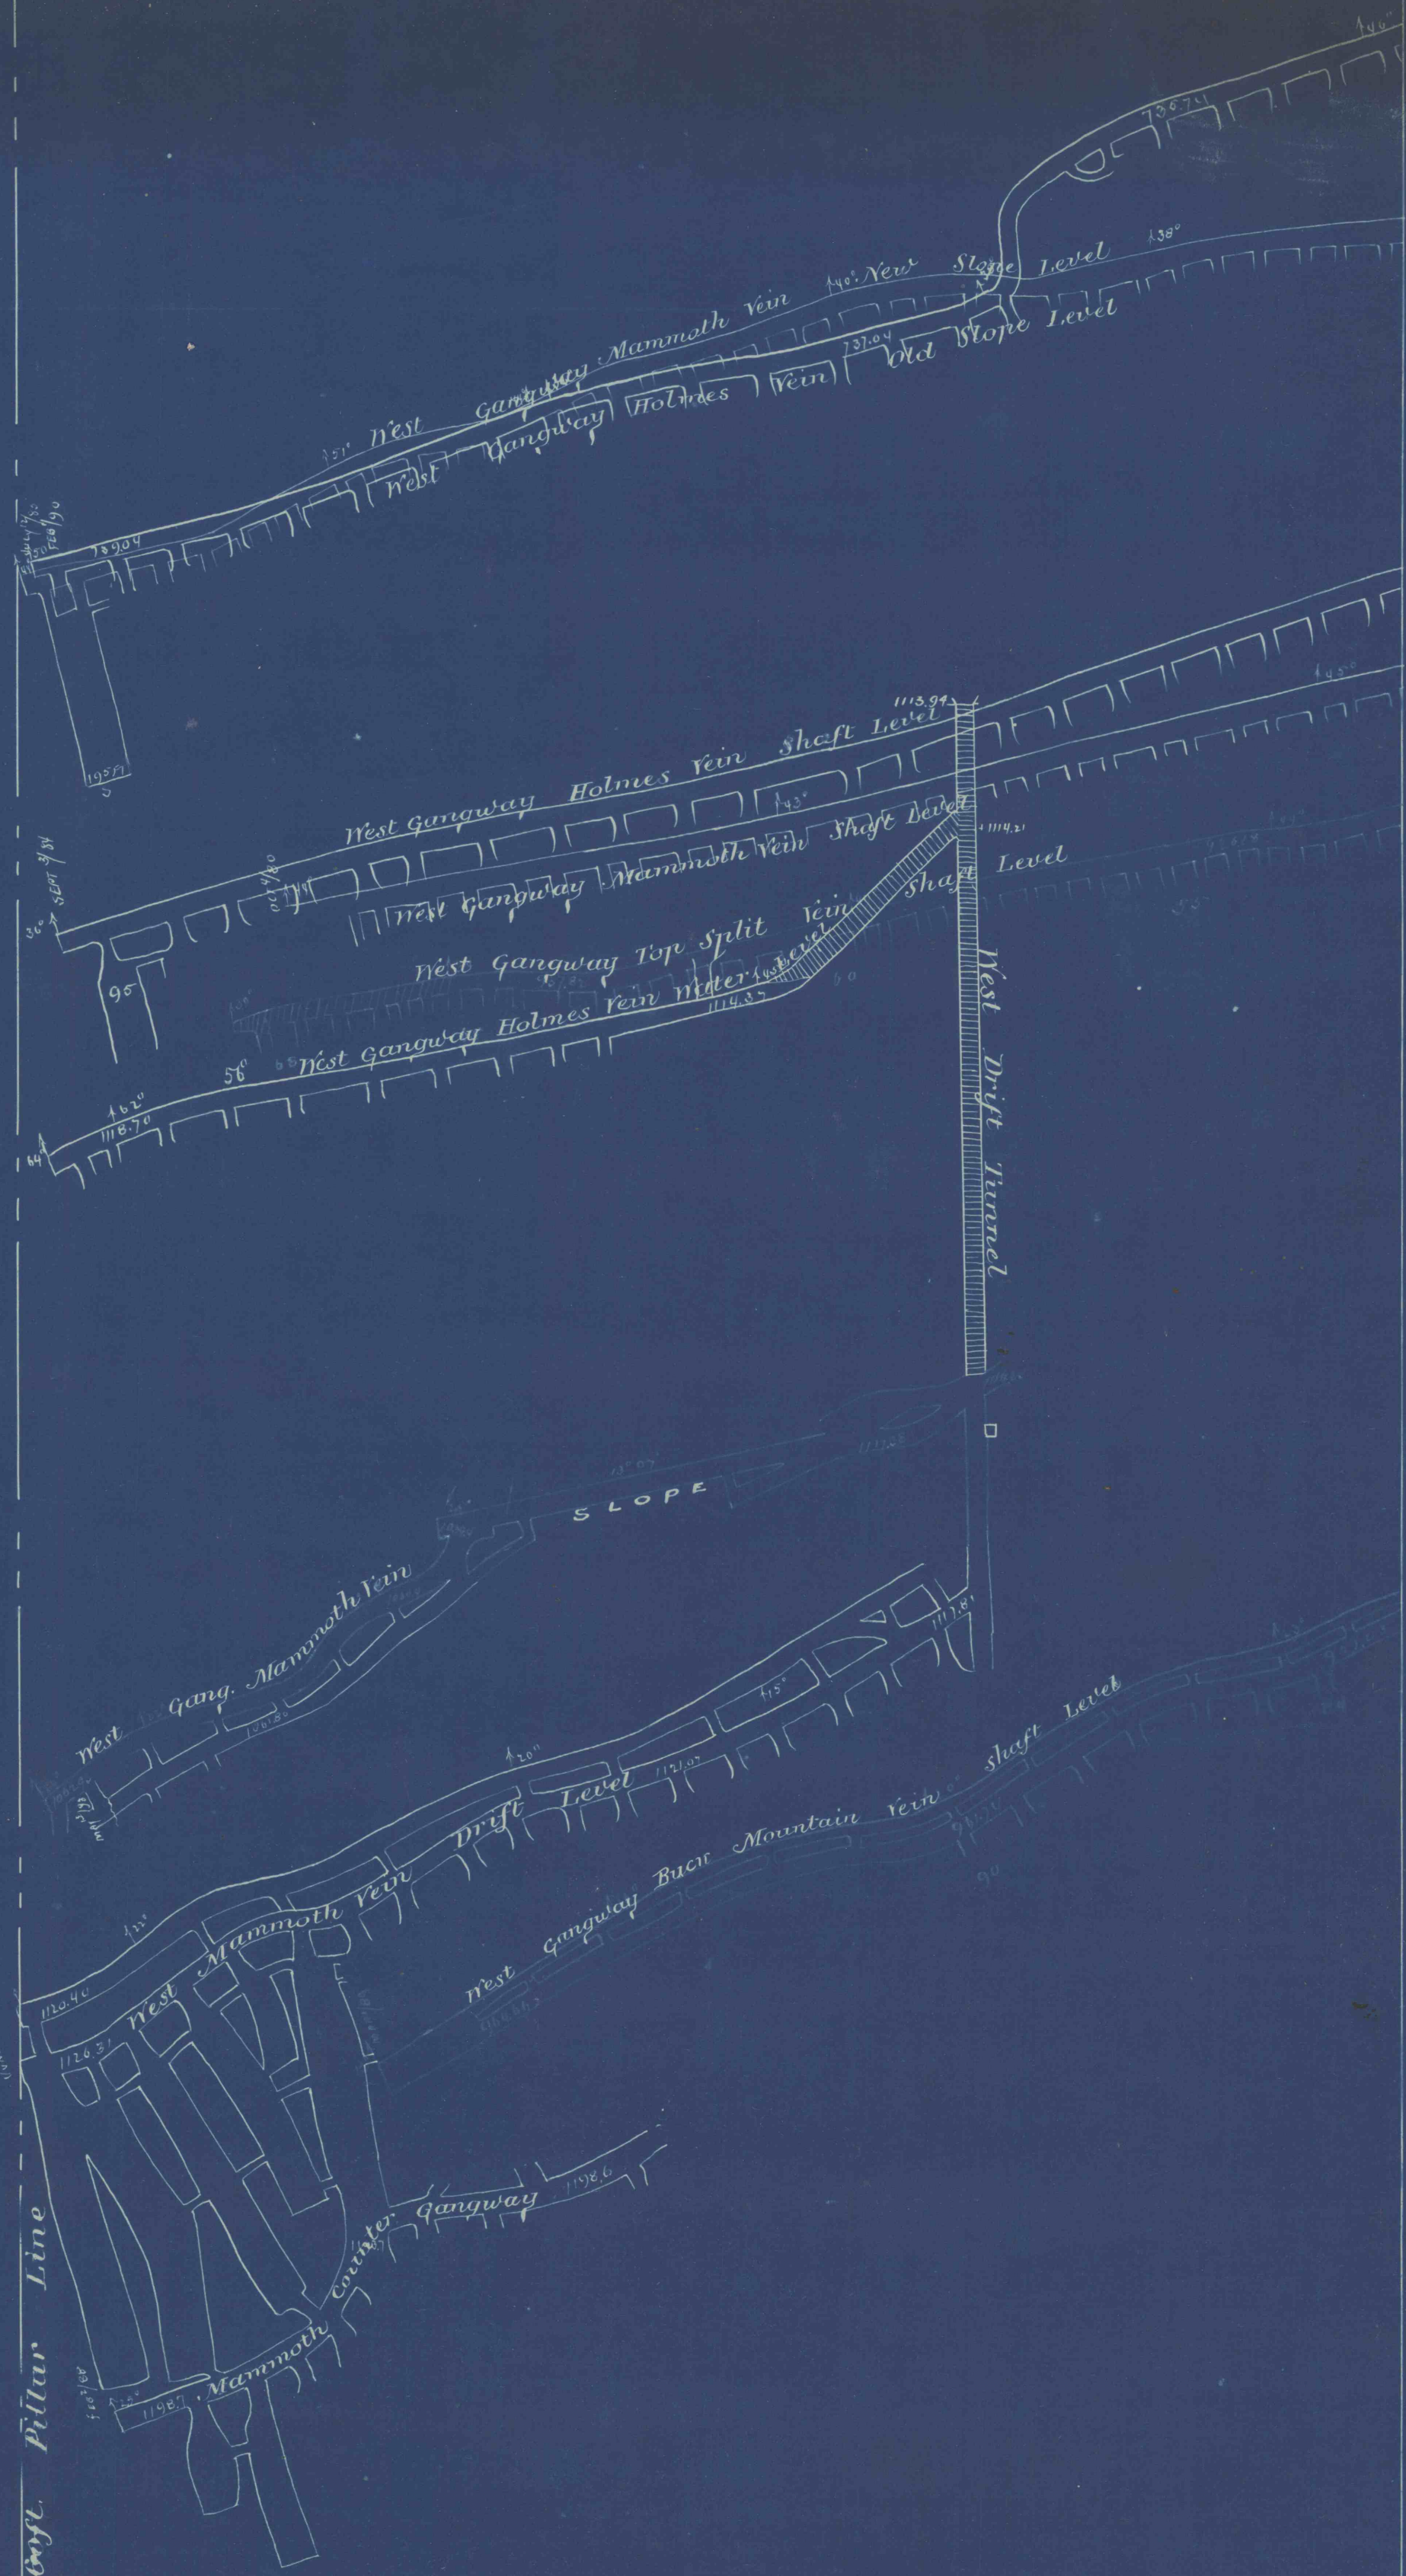

60 ft Pillar Line

Sketch showing
Mine Workings of Wm. Penn and Packer No. 5
Slope in relation to East Line of Packer No. 5 Lease
Scale 100 ft. = 1 Inch
F. E. Zerby Dir. Eng. July 1894
W. A. Lathrop Genl. Supt. L.V. Coal Co.
D. P. Brown Dir. " " "