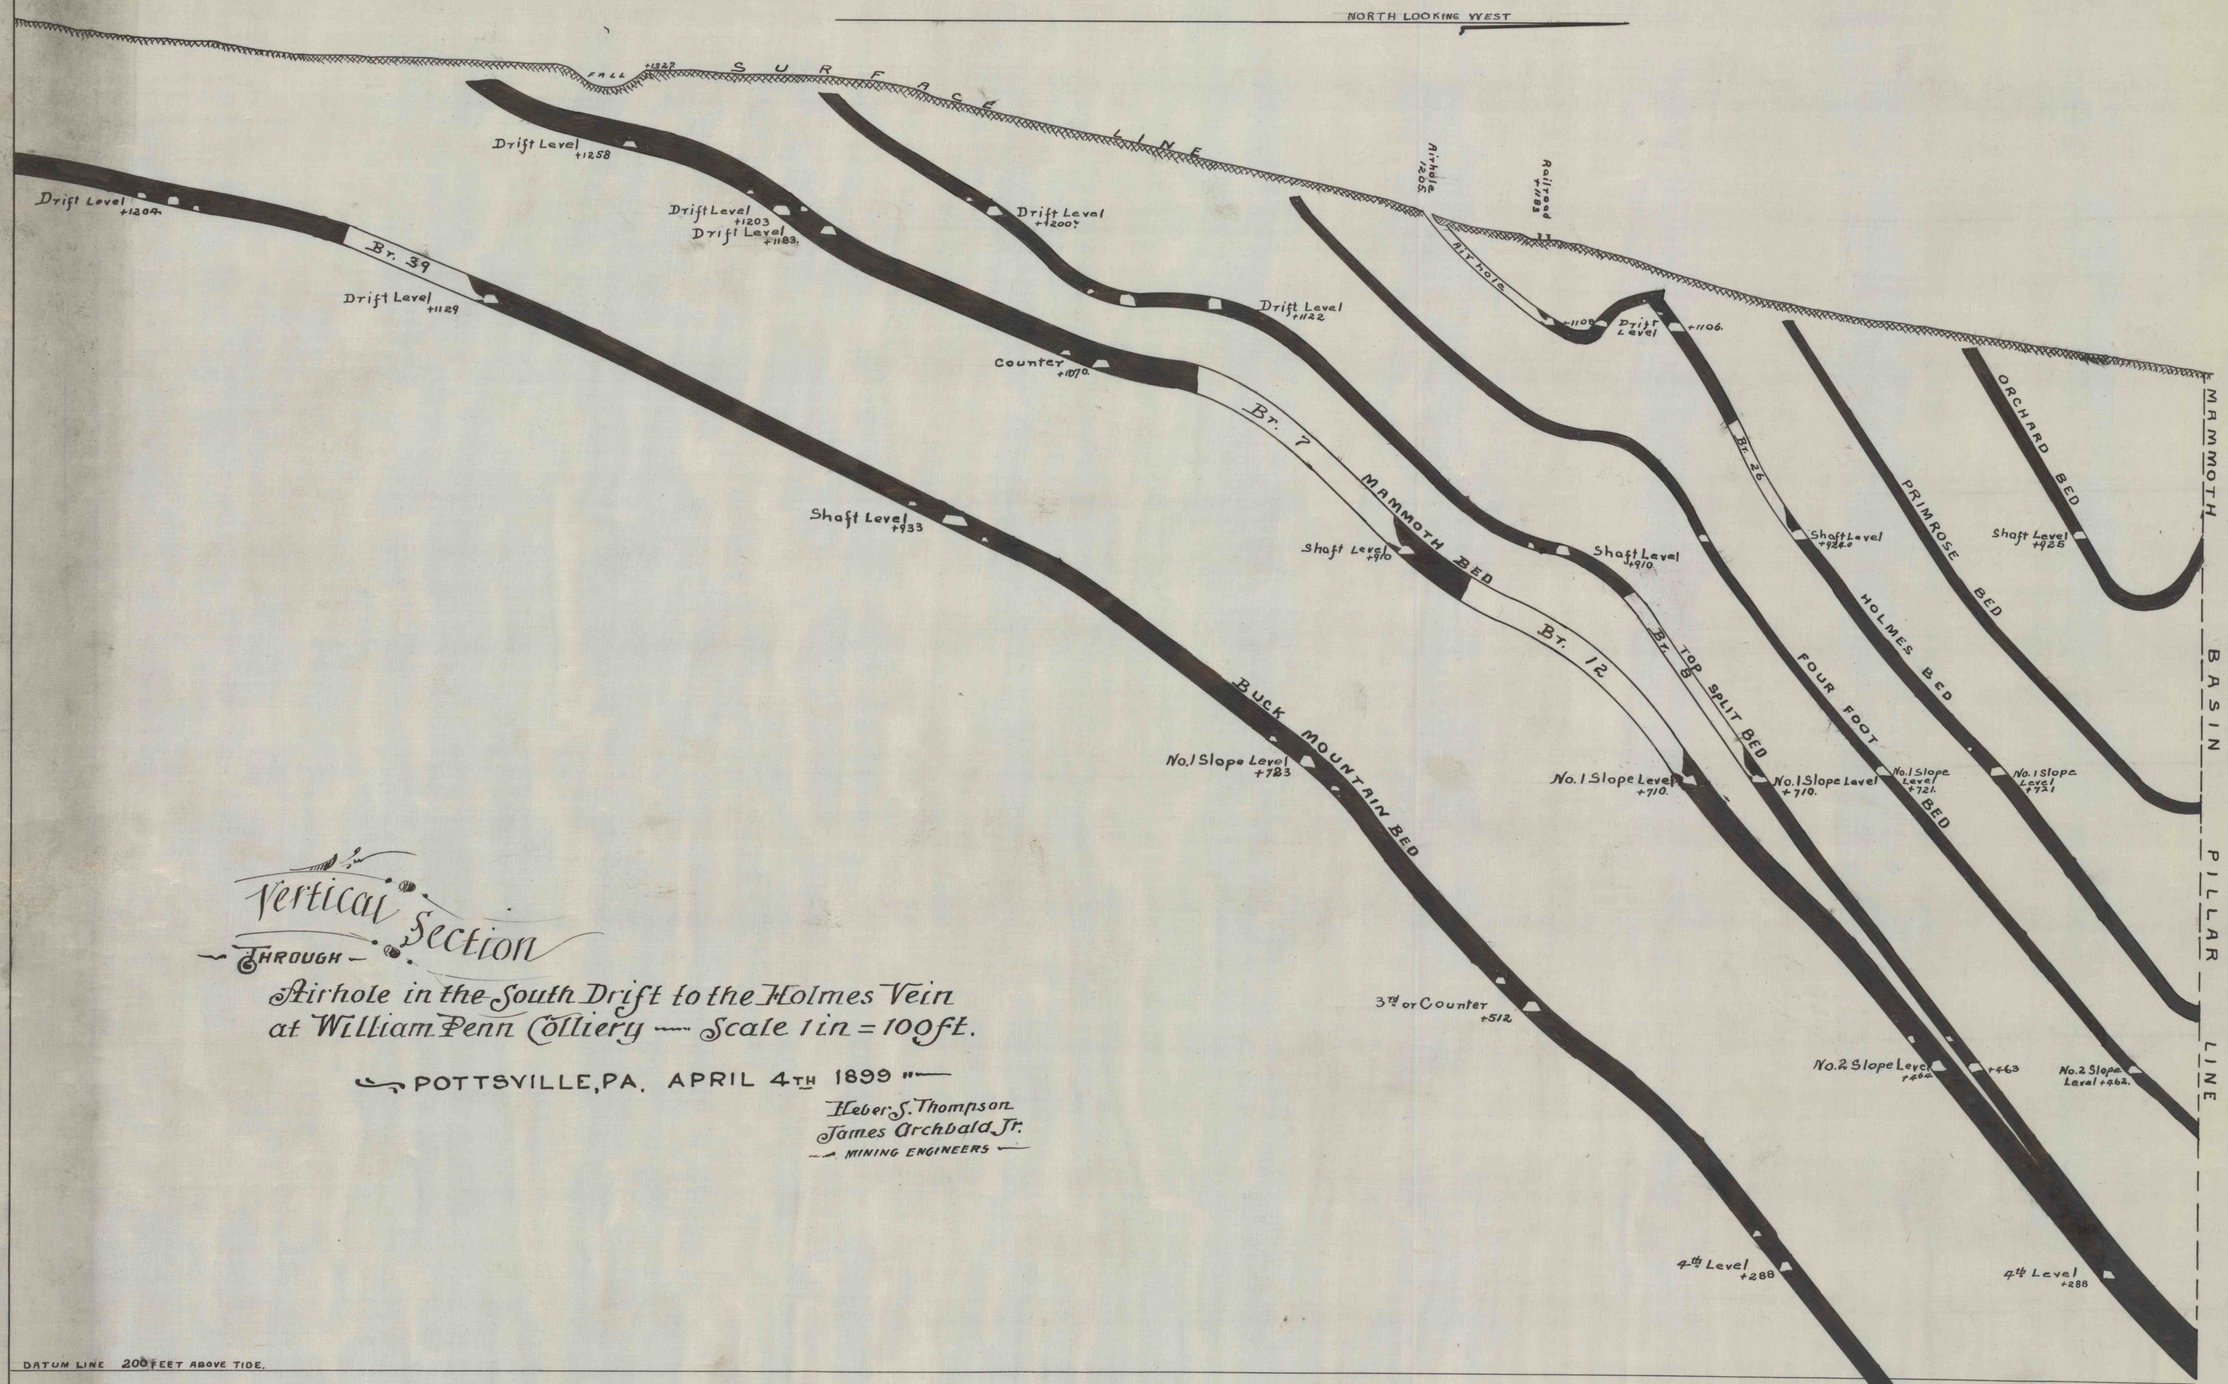

Vertical Section
Through
Airhole in the South Drift to the Holmes Vein at William Penn Colliery ---- Scale 1 in = 100 ft.

POTTSVILLE, PA. APRIL 4TH 1899

Heber S. Thompson
James Archbald Jr.
MINING ENGINEERS

DATUM LINE 200 FEET ABOVE TIDE.

Box 23
1625