


No 6

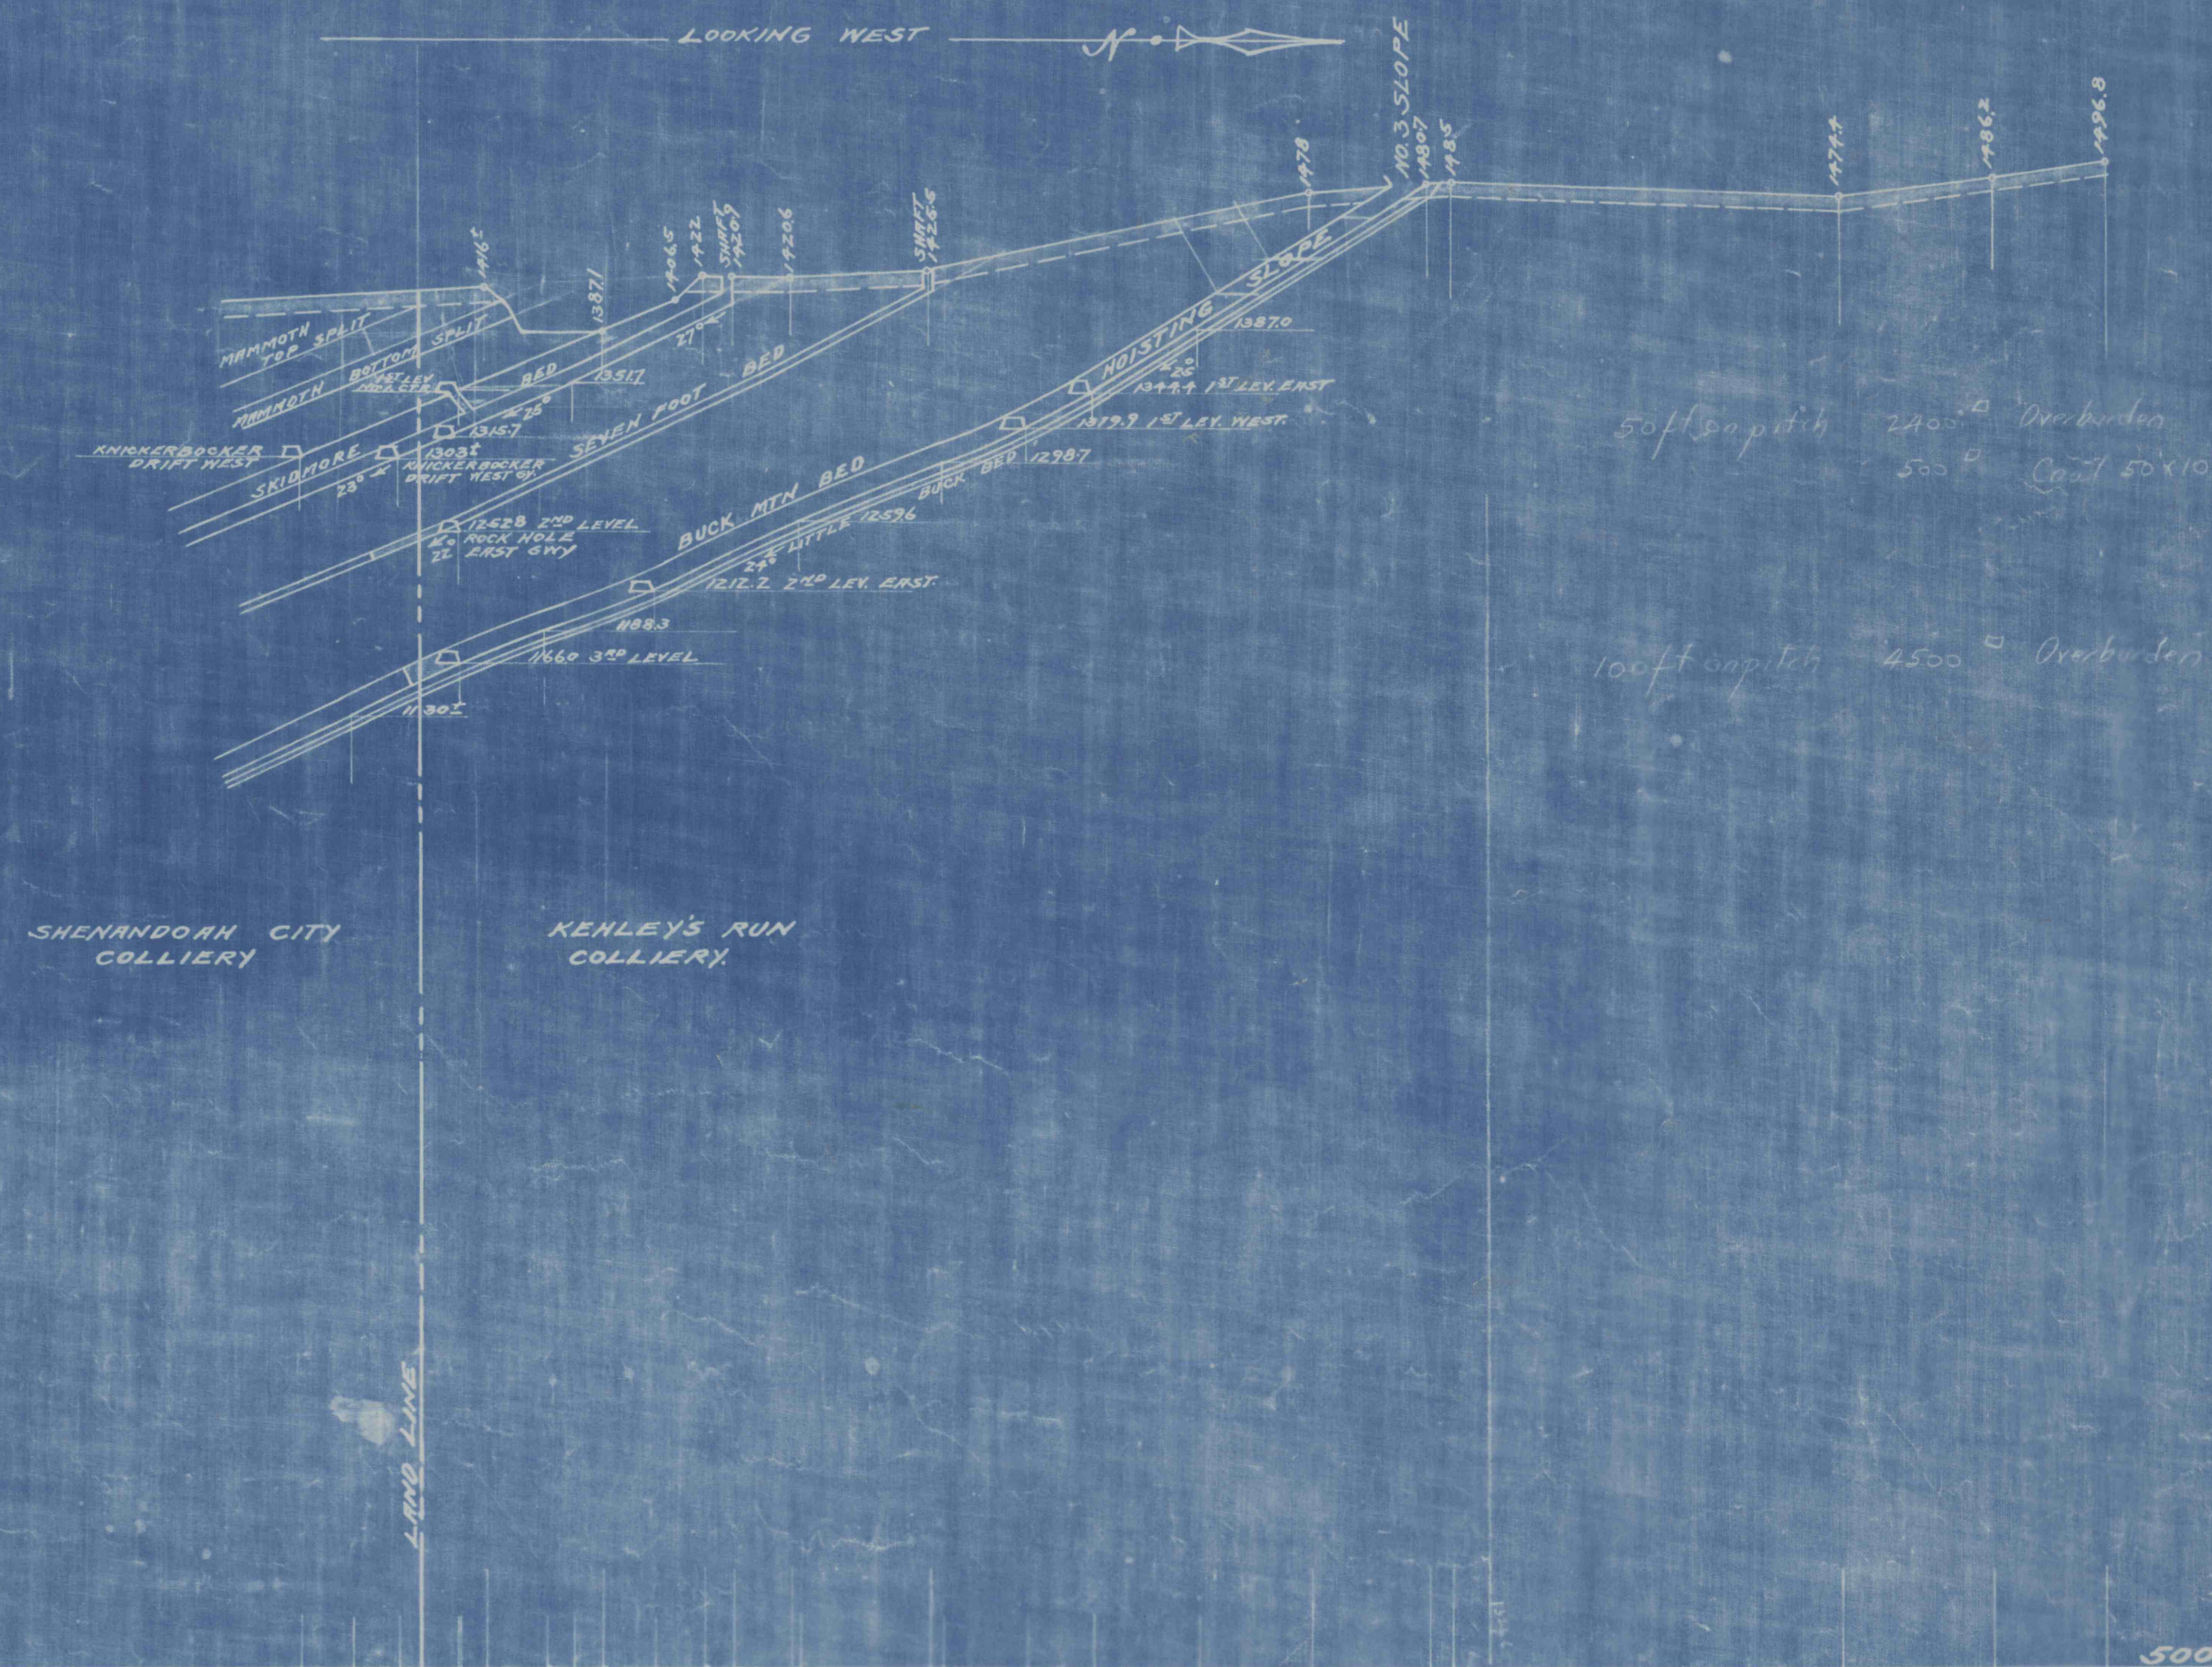

KENLEY'S RUN COLLIERY.
CROSS SECTION ON CENTRE LINE OF NO. 3 BUCK MTN SLOPE
SCALE 1" = 100'

FRICKVILLE, PENNA.

JUNE 4, 1917

SHENANDOAH, PENNA.