


4

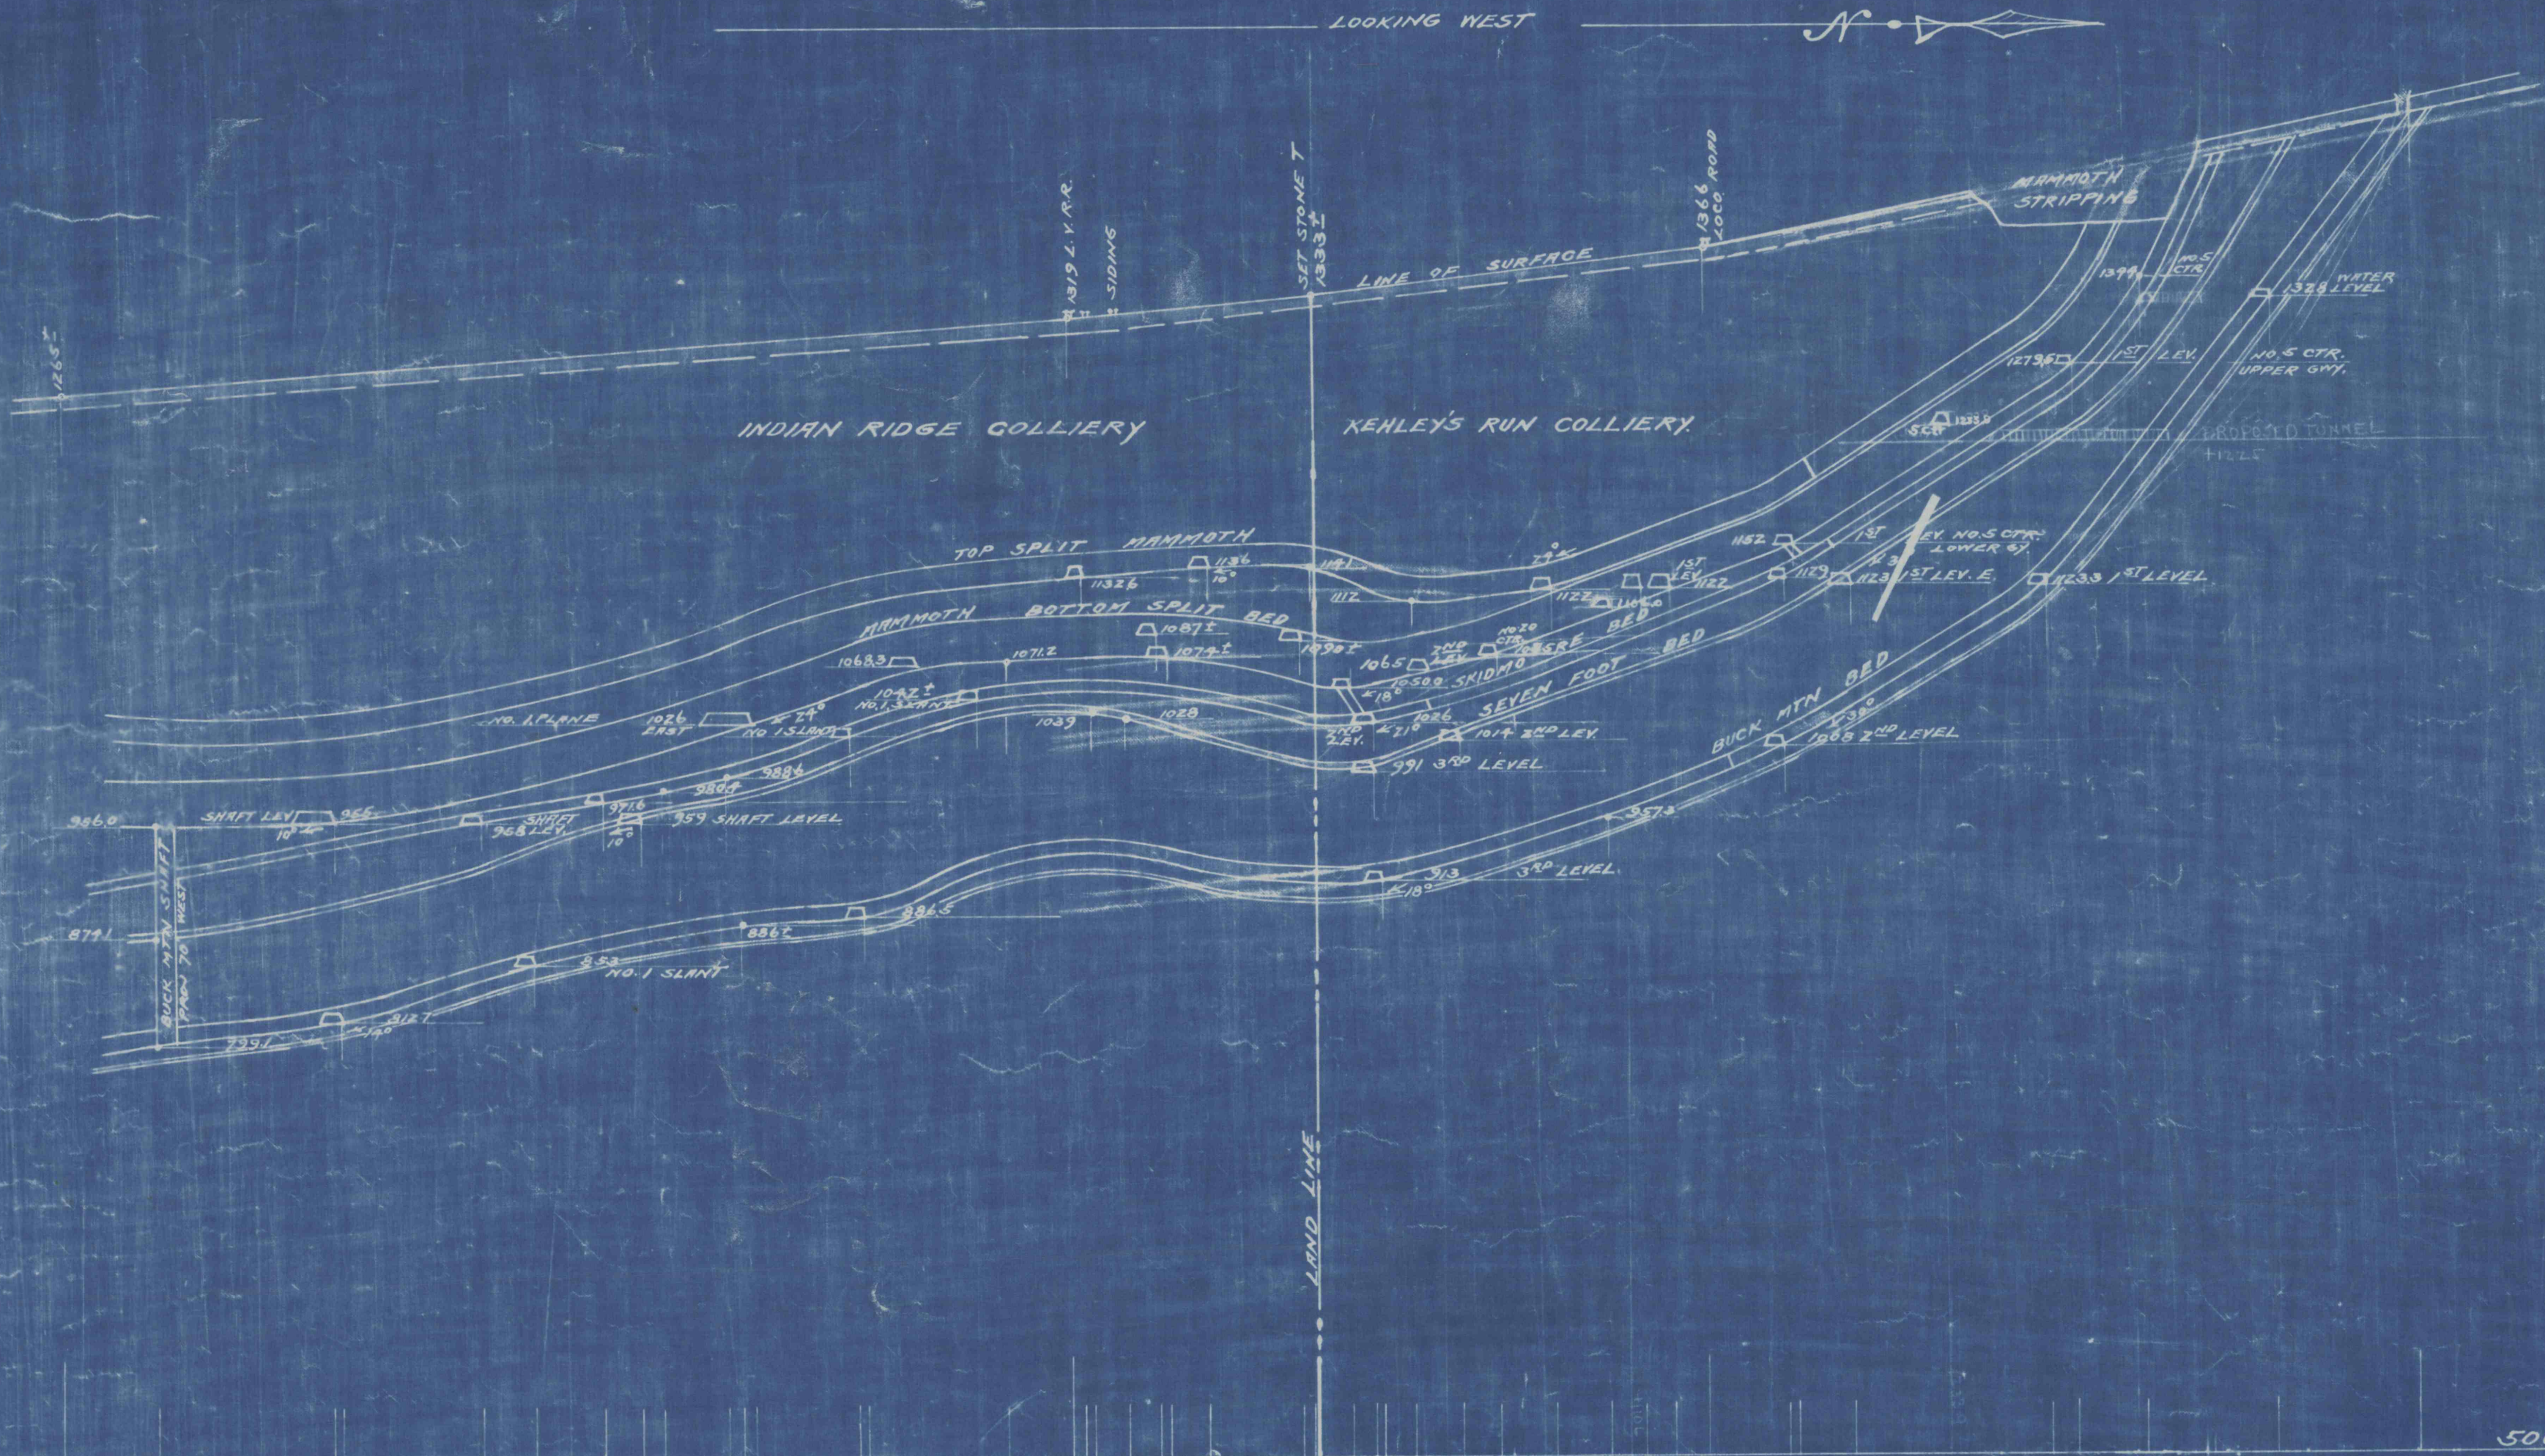

KEHLEY'S RUN COLLIERY
CROSS SECTION THROUGH SET STONE T AT 375 FEET EAST OF AND
PARALLEL TO MERIDIAN LINE 21000 E.

FRACKVILLE, PENNA. THOMAS COLLIERY COMPANY. JUNE 14-1917.
SHENANDOW, PENNA.