


No 1

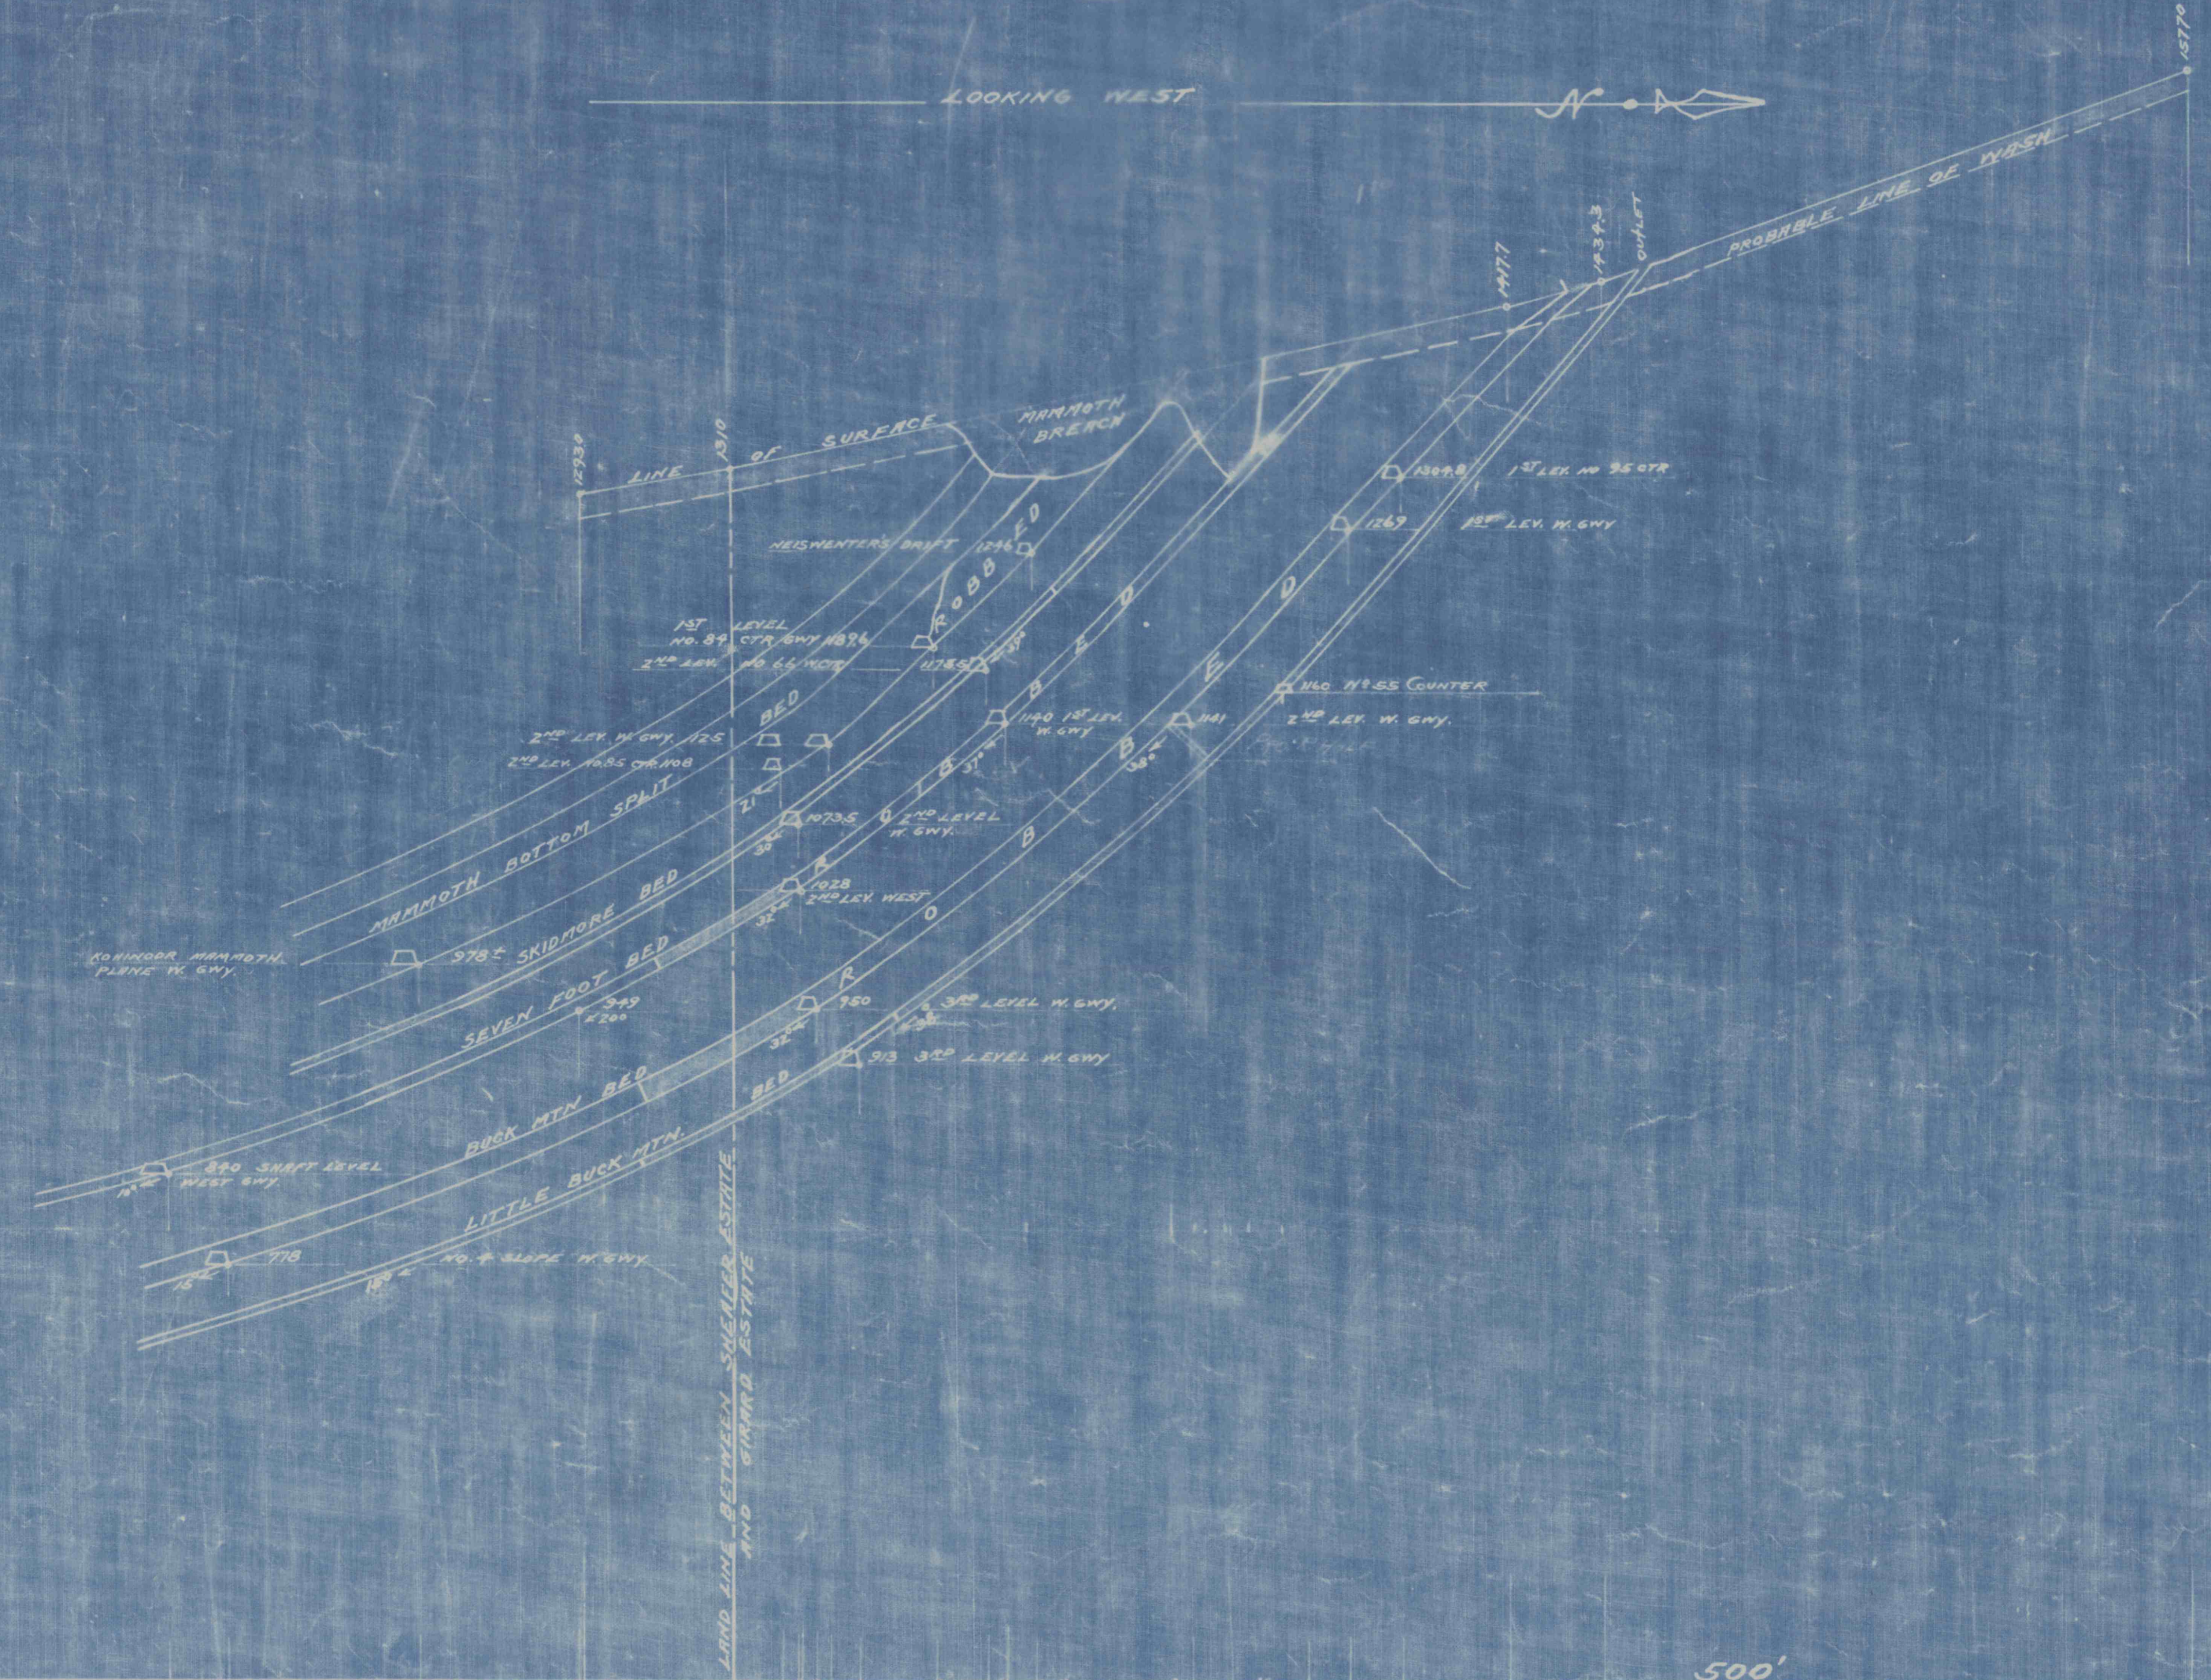

KEHLEY'S RUN COLLIERY  
 CROSS SECTION THRU NO. 95 BUCK MTN TIMBER CHUTE ON 1ST LEVEL WEST BUCK MTN GWY.  
 SCALE 1" = 100'  
 PARKVILLE, PENNA. JUNE 9-1917.  
 THOMAS COLLIERY COMPANY,  
 SHEPPARD, PENNA.

B. 225