


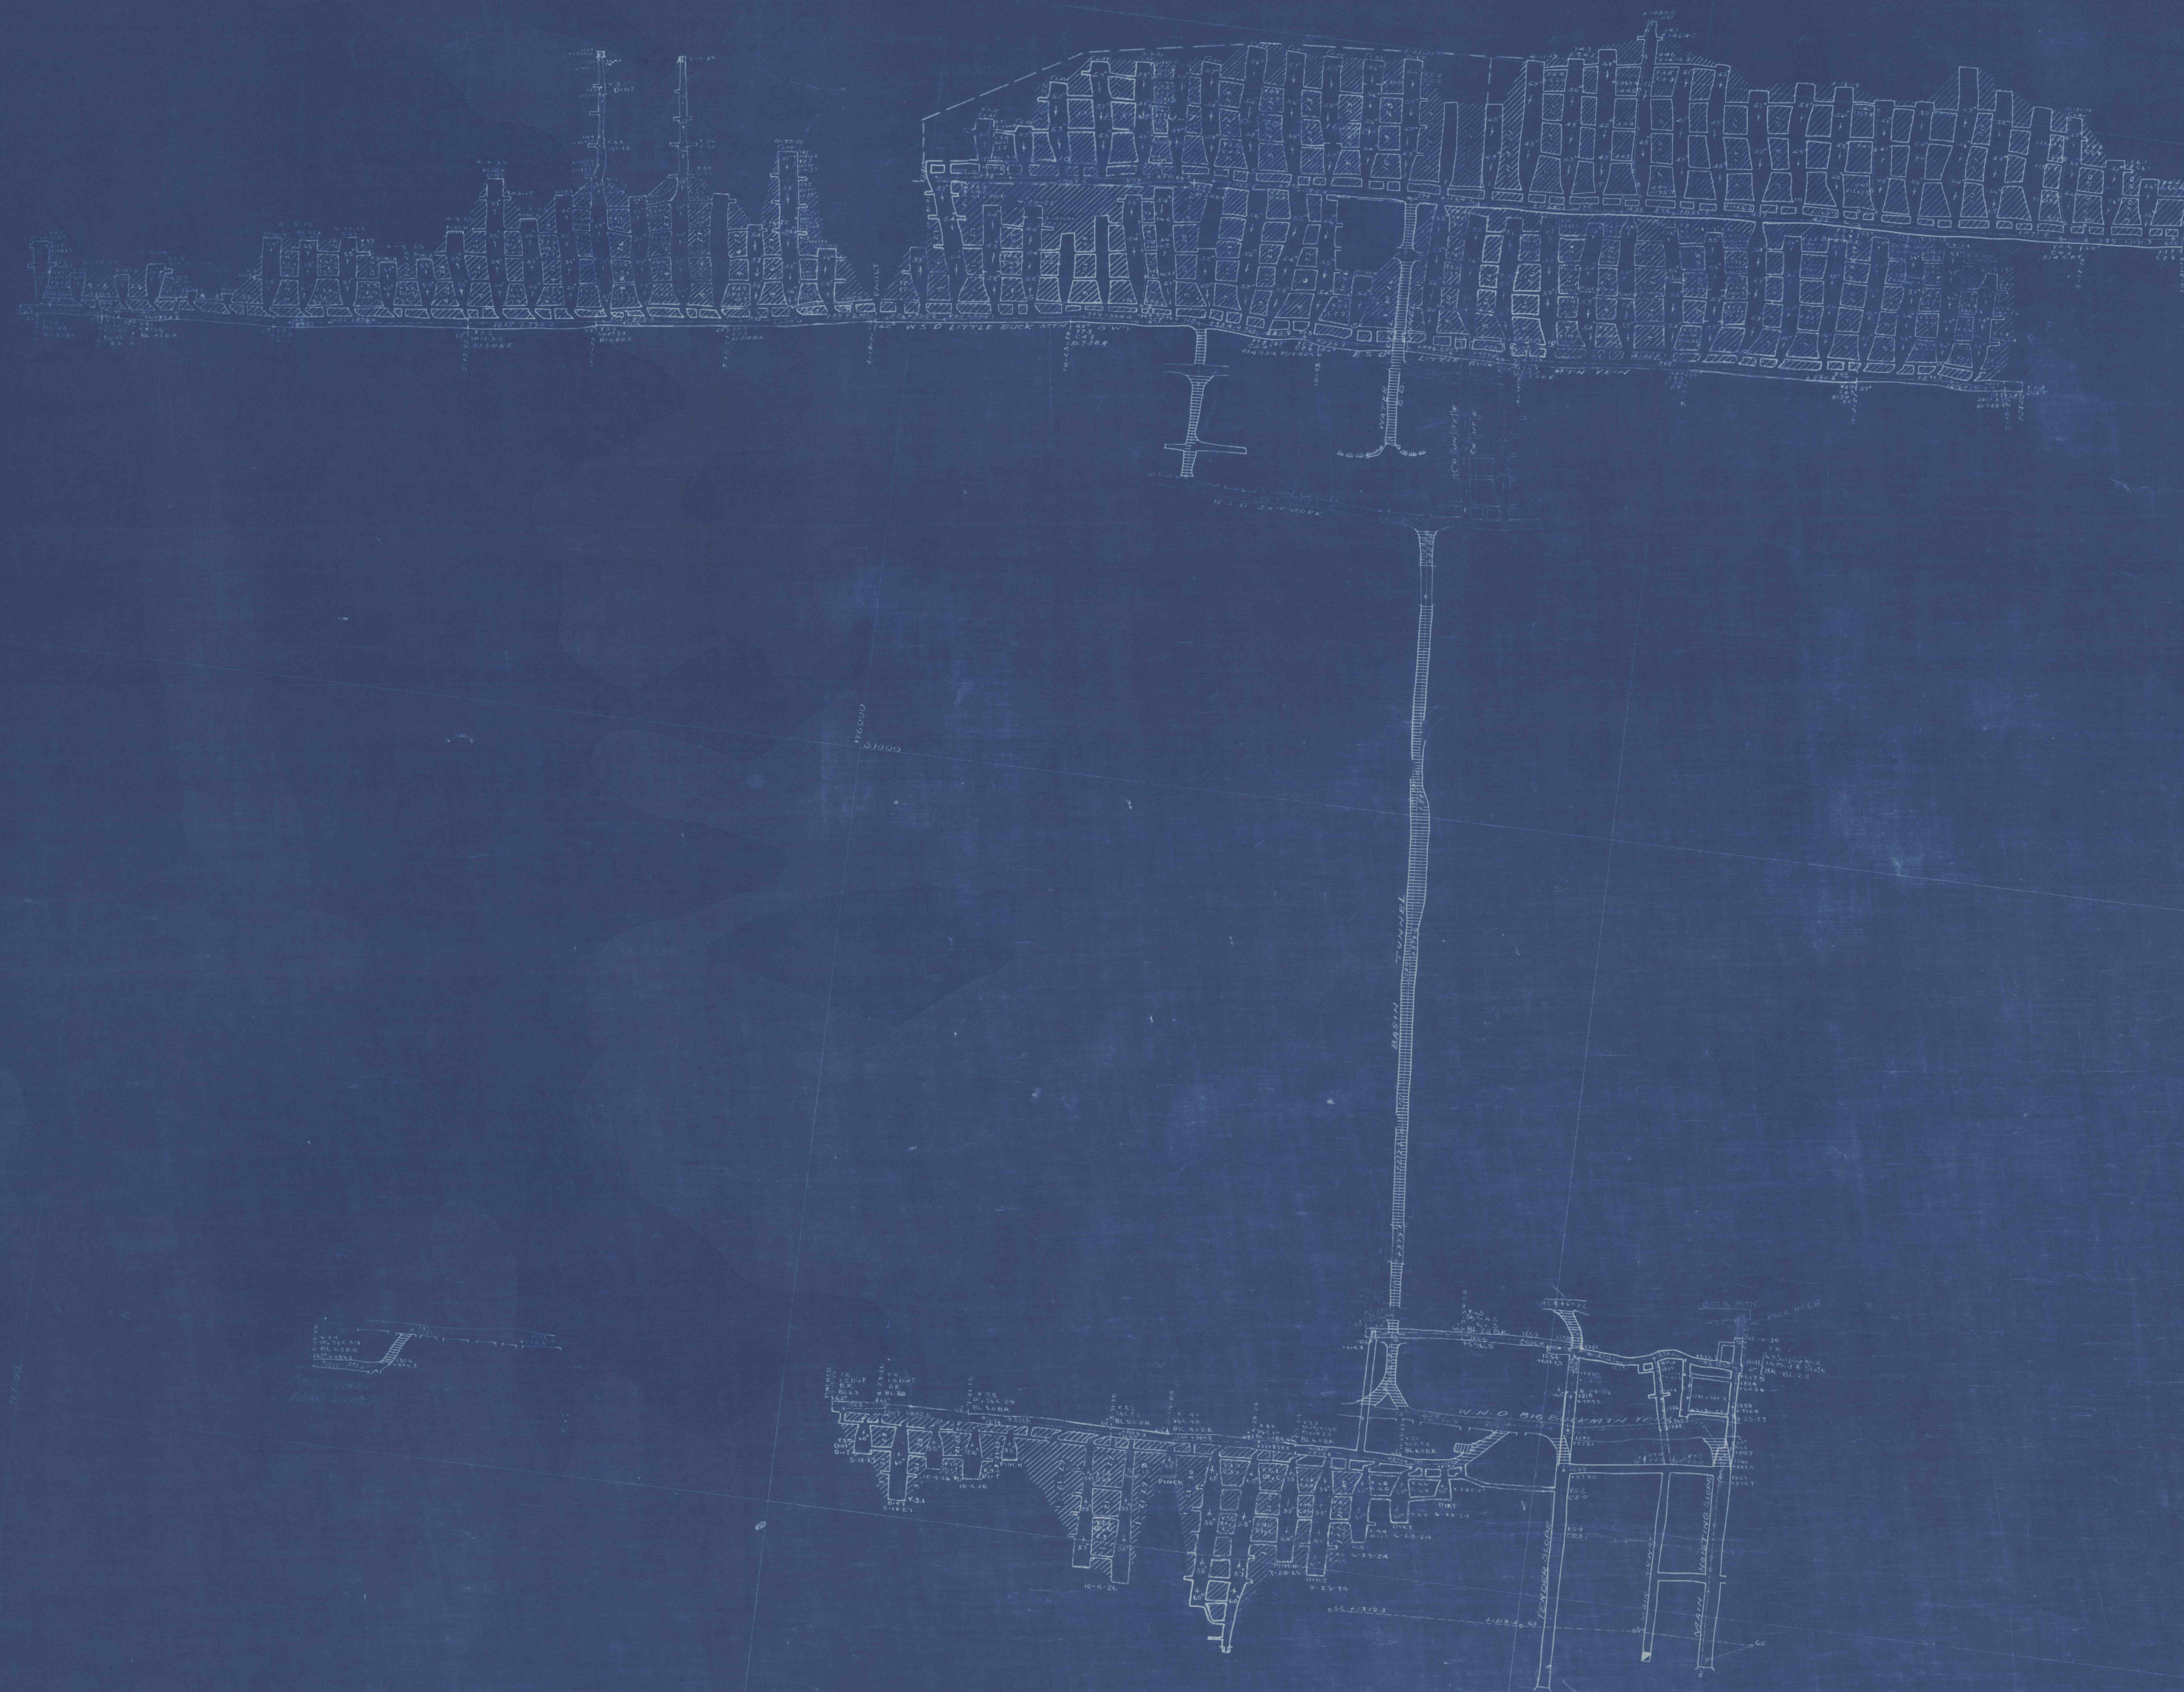

LITTLE BUCK MTN BED
AT
WEST BEAR RIDGE COLLY.
SCALE 1"=100' 10-3-20