


5

LOOKING WEST

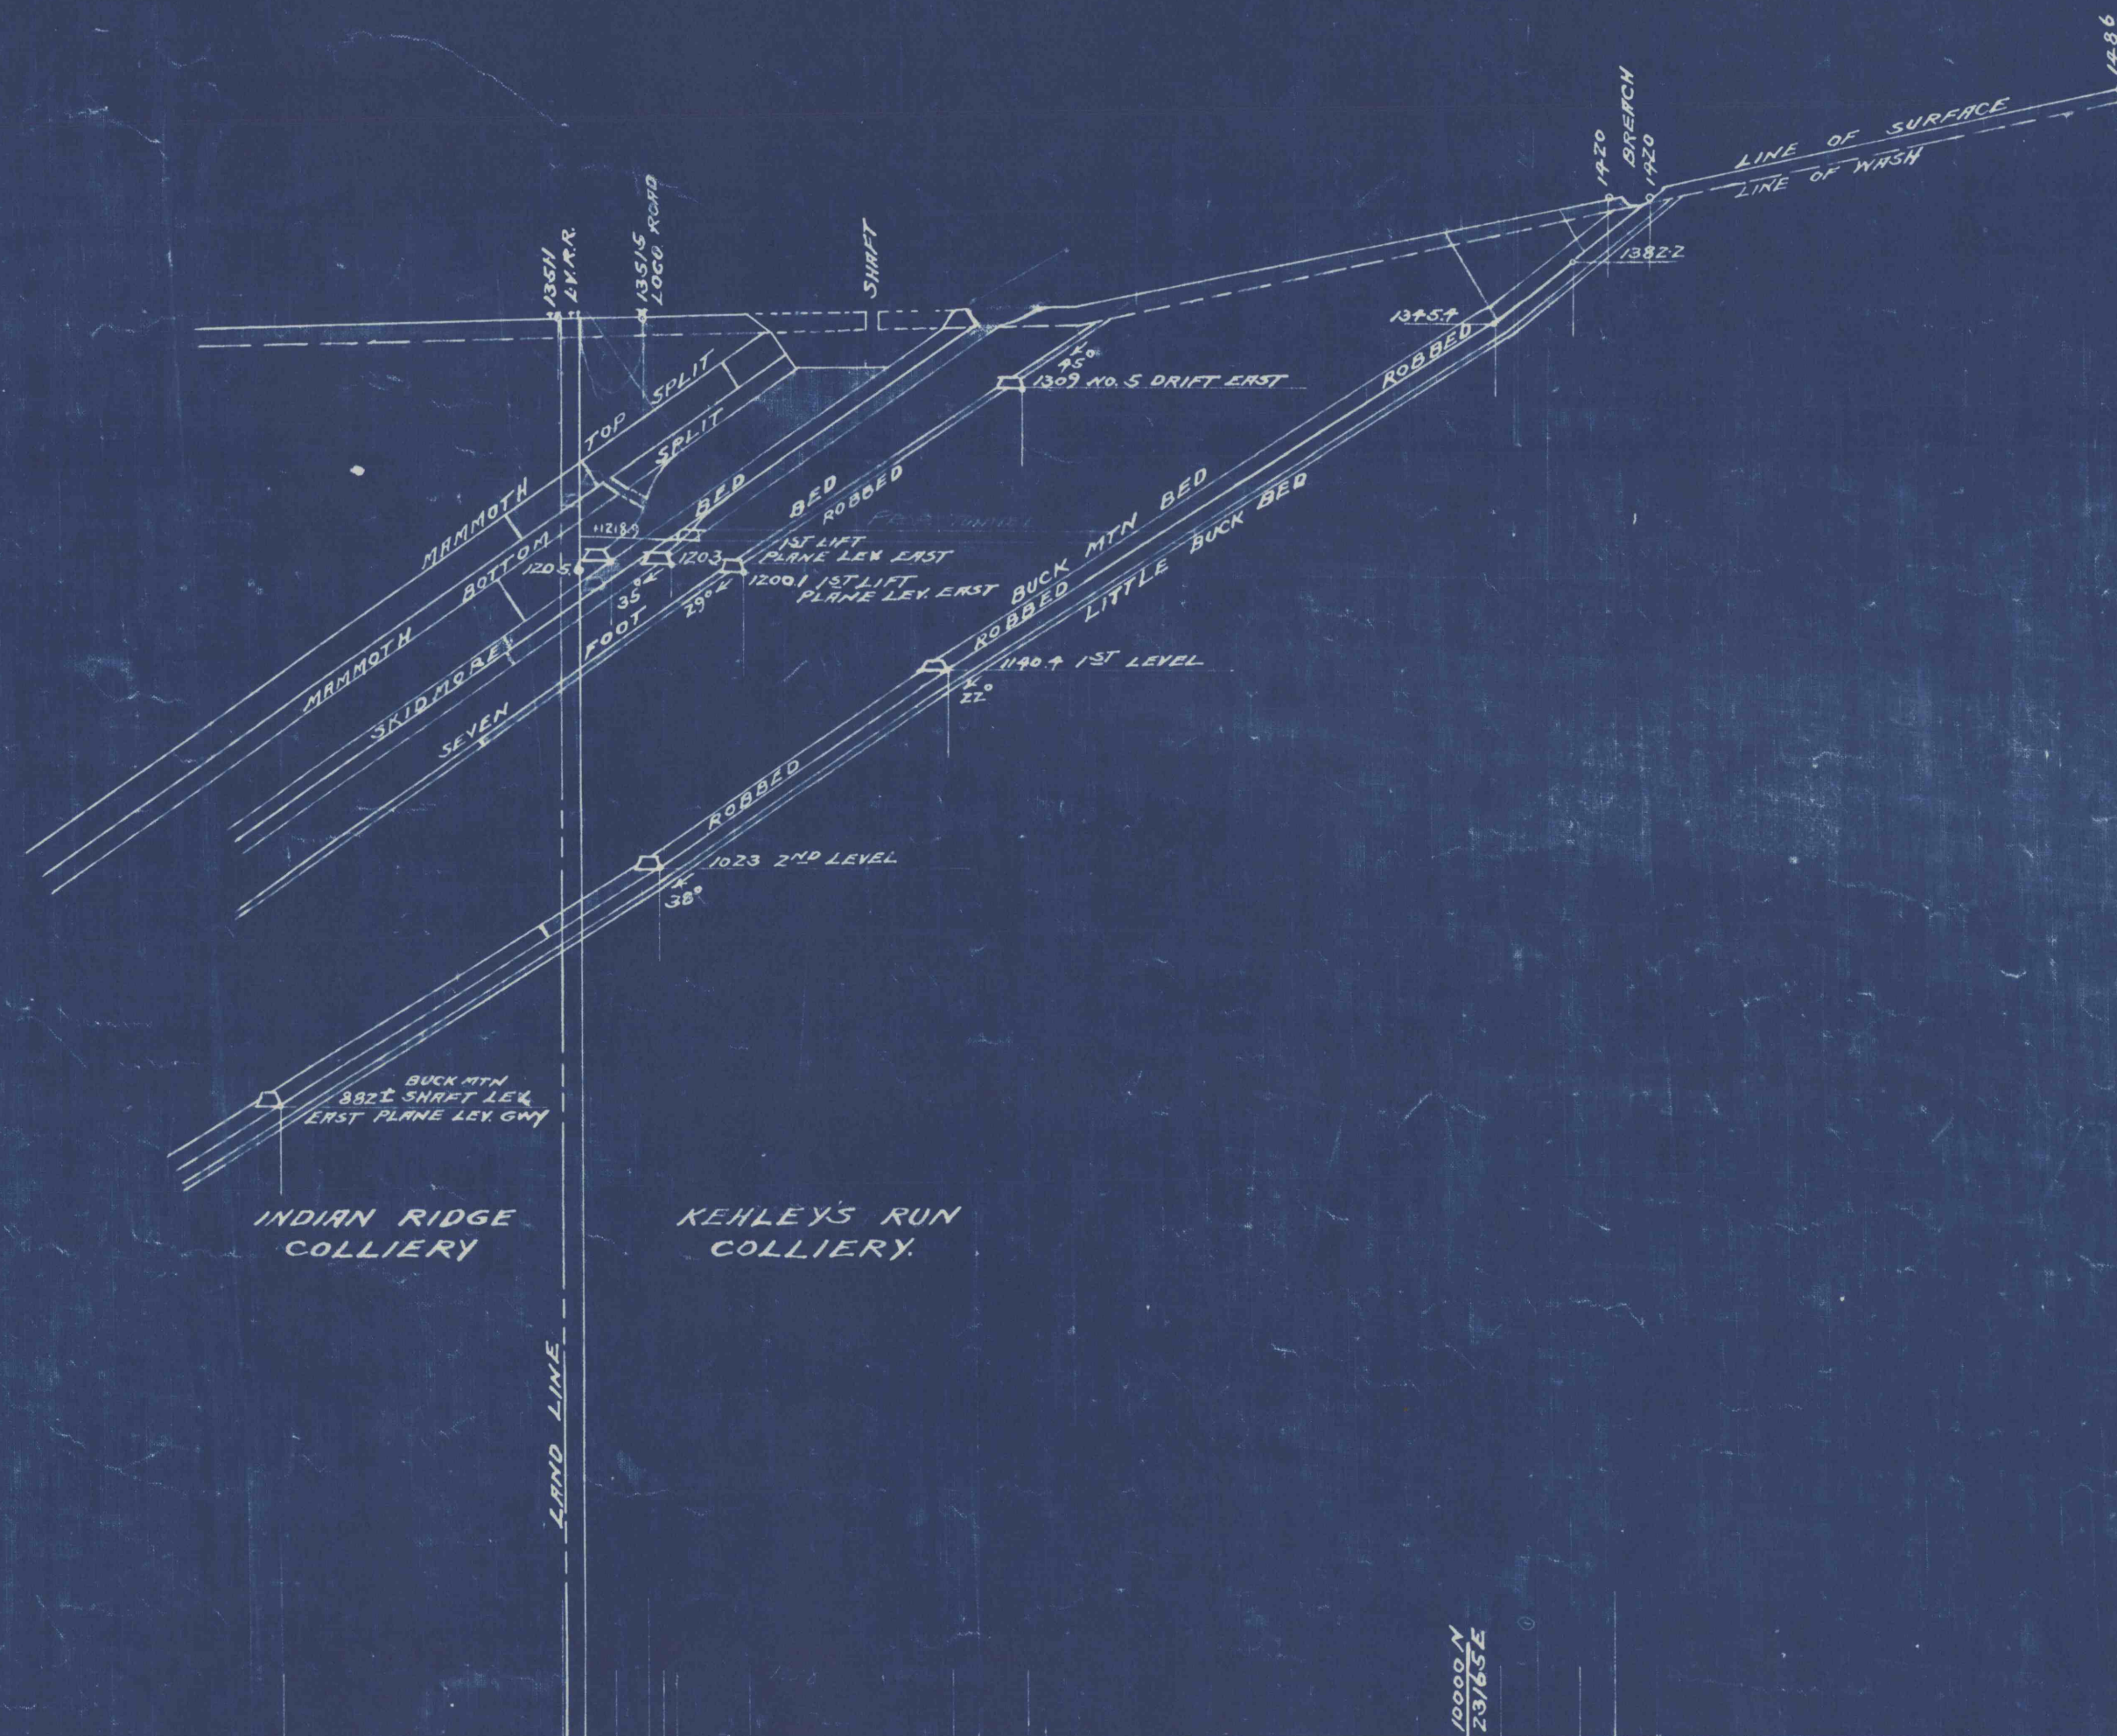

KEHLEY'S RUN COLLIERY

CROSS SECTION THRO BREAST No. 31 ON FIRST LIFT PLANE LEVEL
EAST BOTTOM SPLIT GANGWAY.

SCALE 1" = 100'

FRICKVILLE, PENNA.

THOMAS COLLIERY COMPANY,
SHEPCH, PA.

JUNE-9-1917.