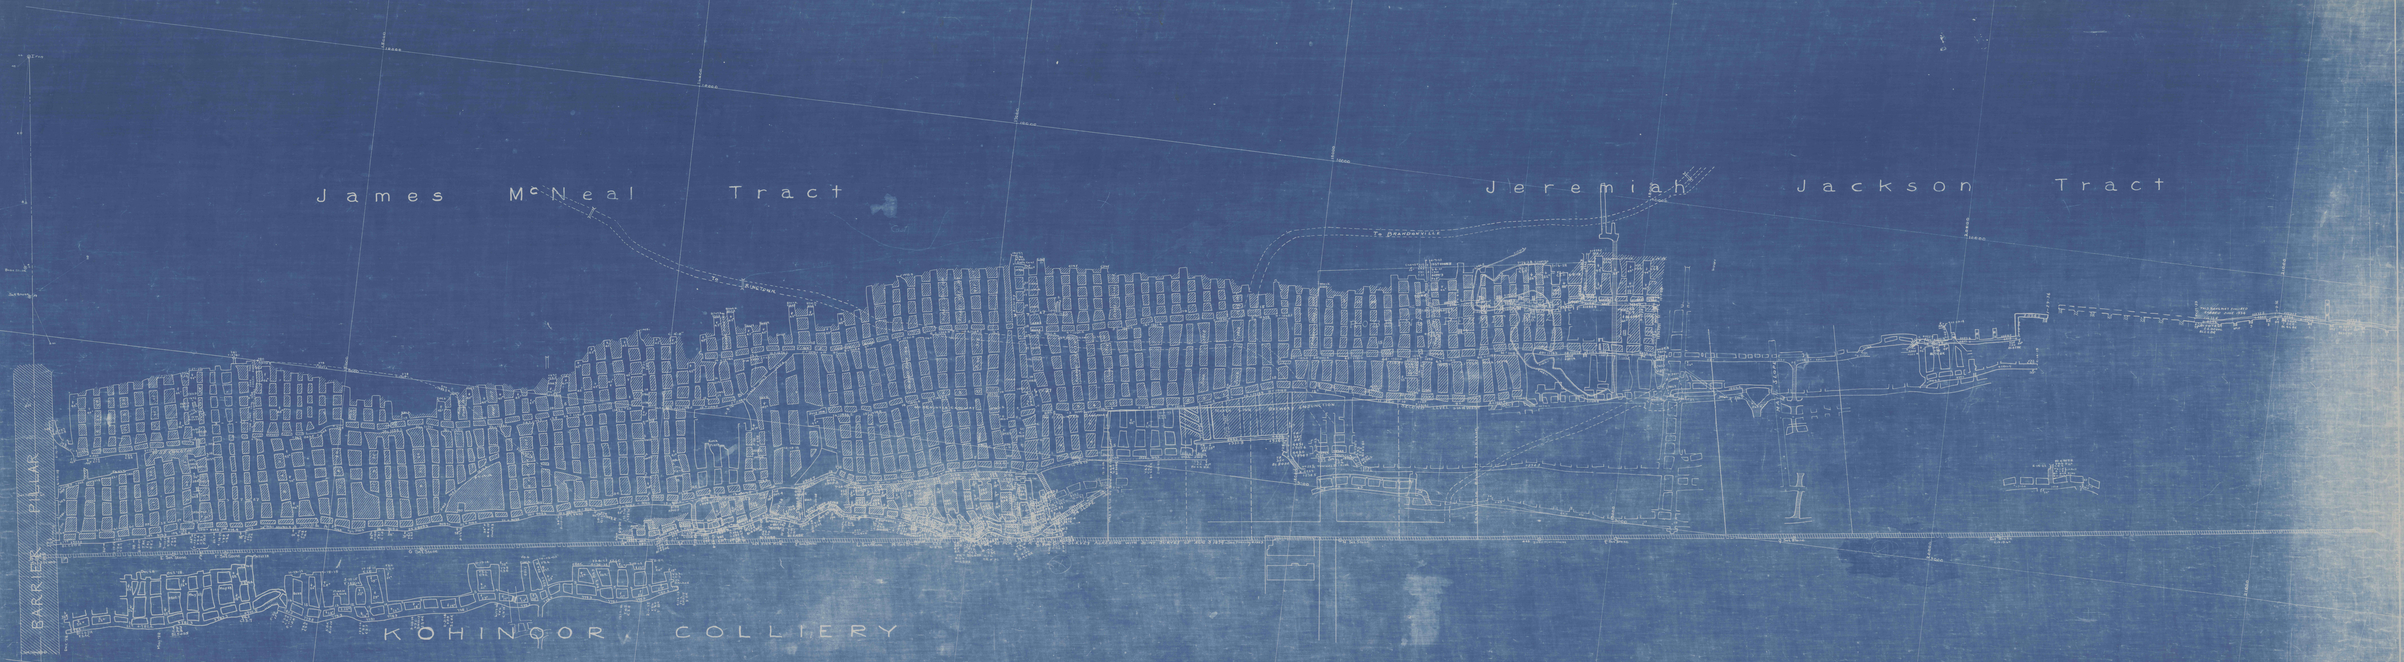
James McNeal Tract
Jeremiah Jackson Tract
BARRIER PILLAR
KOHINOOR COLLIERY
INDIAN RIDGE COLLIERY
LITTLE BUCK MOUNTAIN VEIN
KEHLEY'S RUN COLLY - SHENANDOAH PA
Scale 1 Inch = 100 feet
JUNE 18 1924