


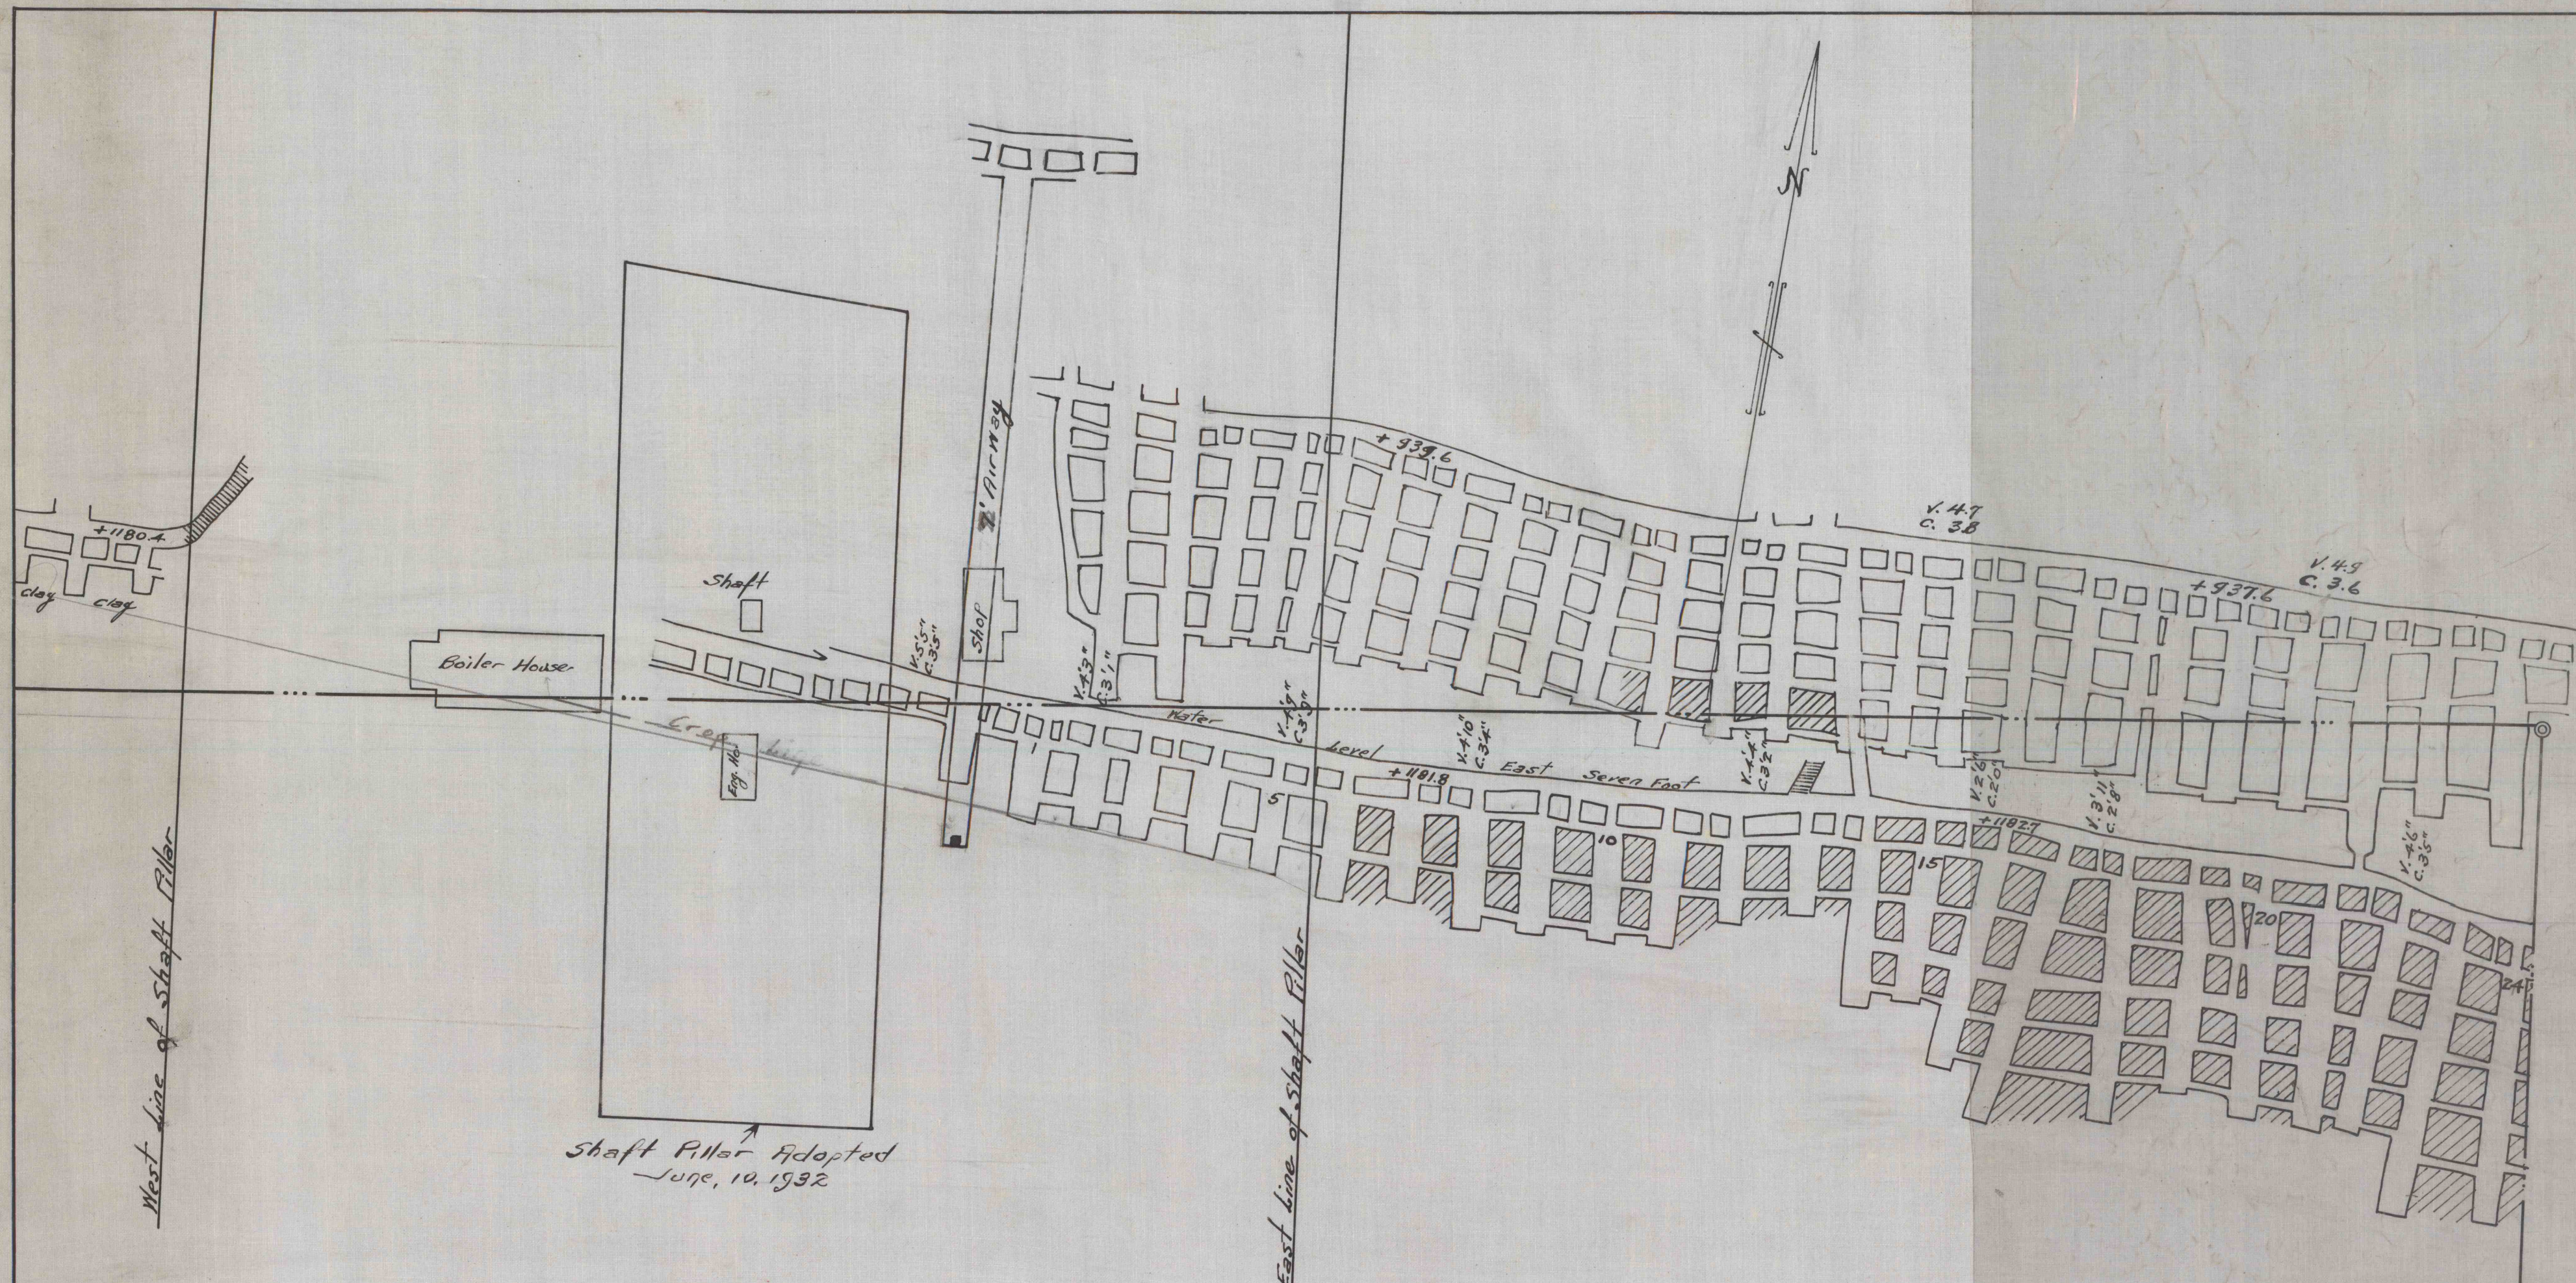

G I R A R D E S T A T E

SEVEN FOOT VEIN
 AT
 KIMBERLEY COLLIERY
 GIRARD ESTATE GIRARDVILLE, PENNA. NOV. 10, 1926
 SCALE 1"=100'
 Posted 7/13/1936